


PARCEL	INSTRUMENT	DATE	GRANTOR	GRANTEE	RECORDED WATERFORD	REMARKS
A, B	Q.C.D.	7-15-37	SAMUEL W. BONNETT & GRACE H. BONNETT	ST. OF RT.	25 219 225-36	CUL. STA. 477+00
A, B, C	ADMIN. DEED	3-20-37	JOHN W. DAVIS ESTATE	"	25 219 225-36	38 200 100 20 40 1100
A, B	Q.C.D.	2-15-38	SAMUEL W. BONNETT & GRACE H. BONNETT	"	25 219 225-36	38 200 100 20 40 1100

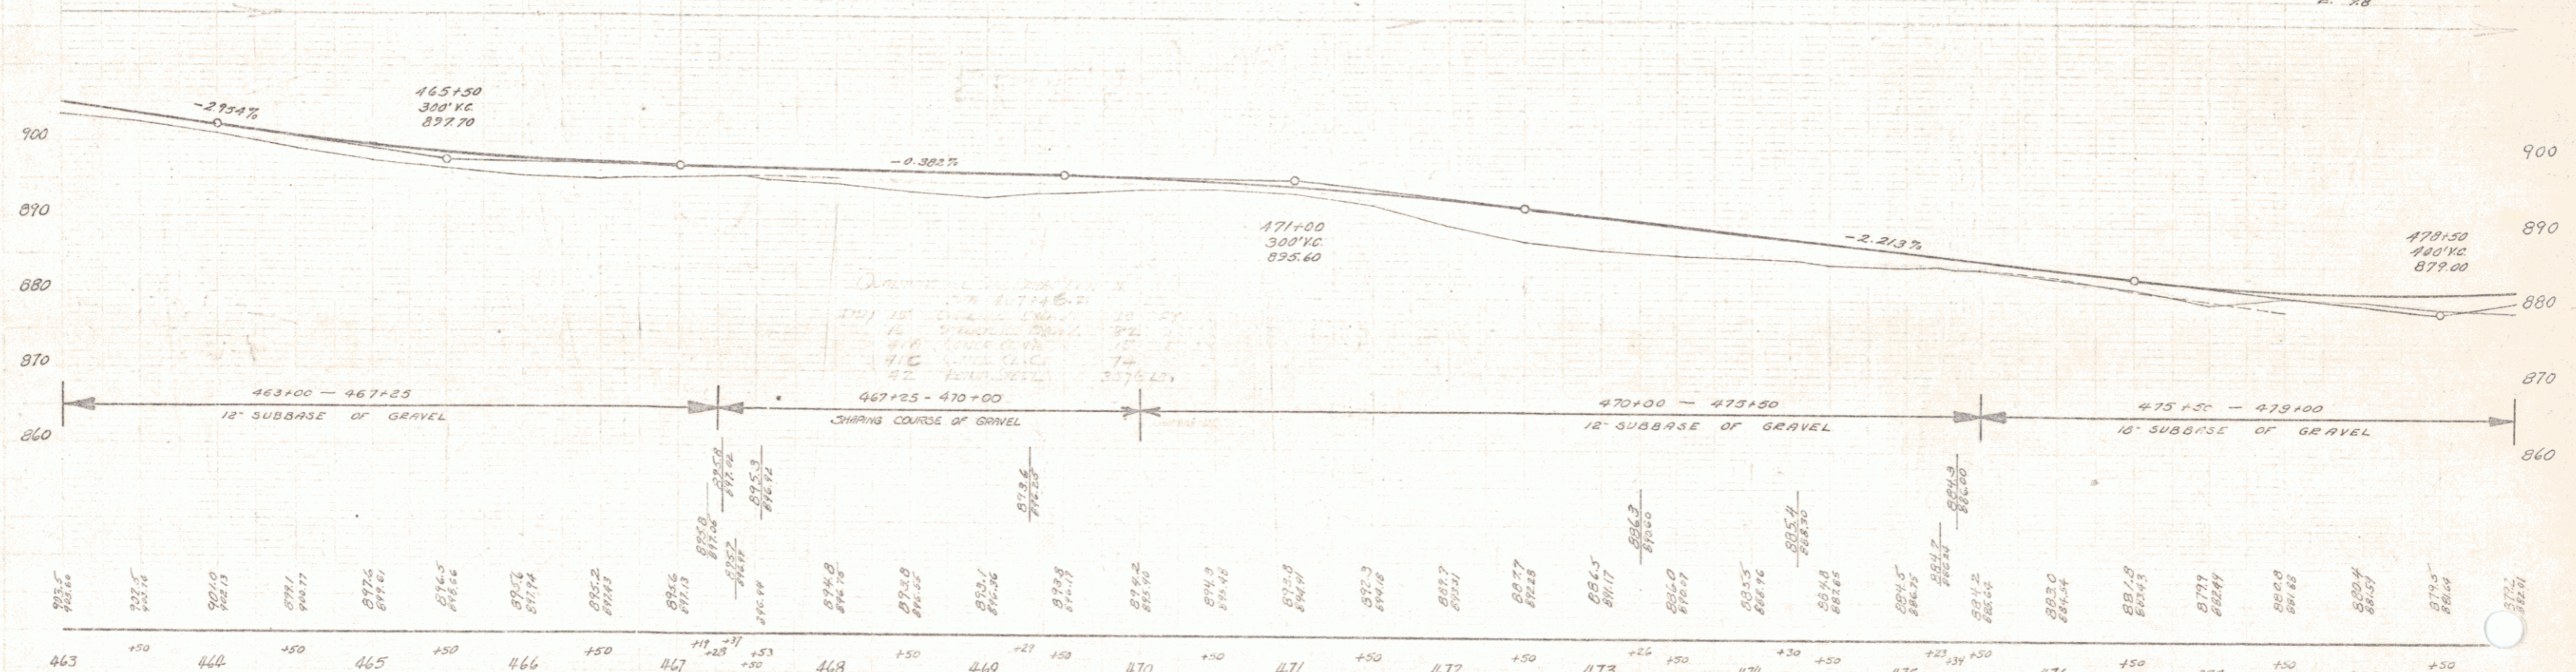

BM 53A S.I.R. 52' RT Sta 467+55 Elev 900.71