



Δ 10°22' LT
 D 115'
 R 538.38
 T 415.8
 L 829.3
 E 22.1

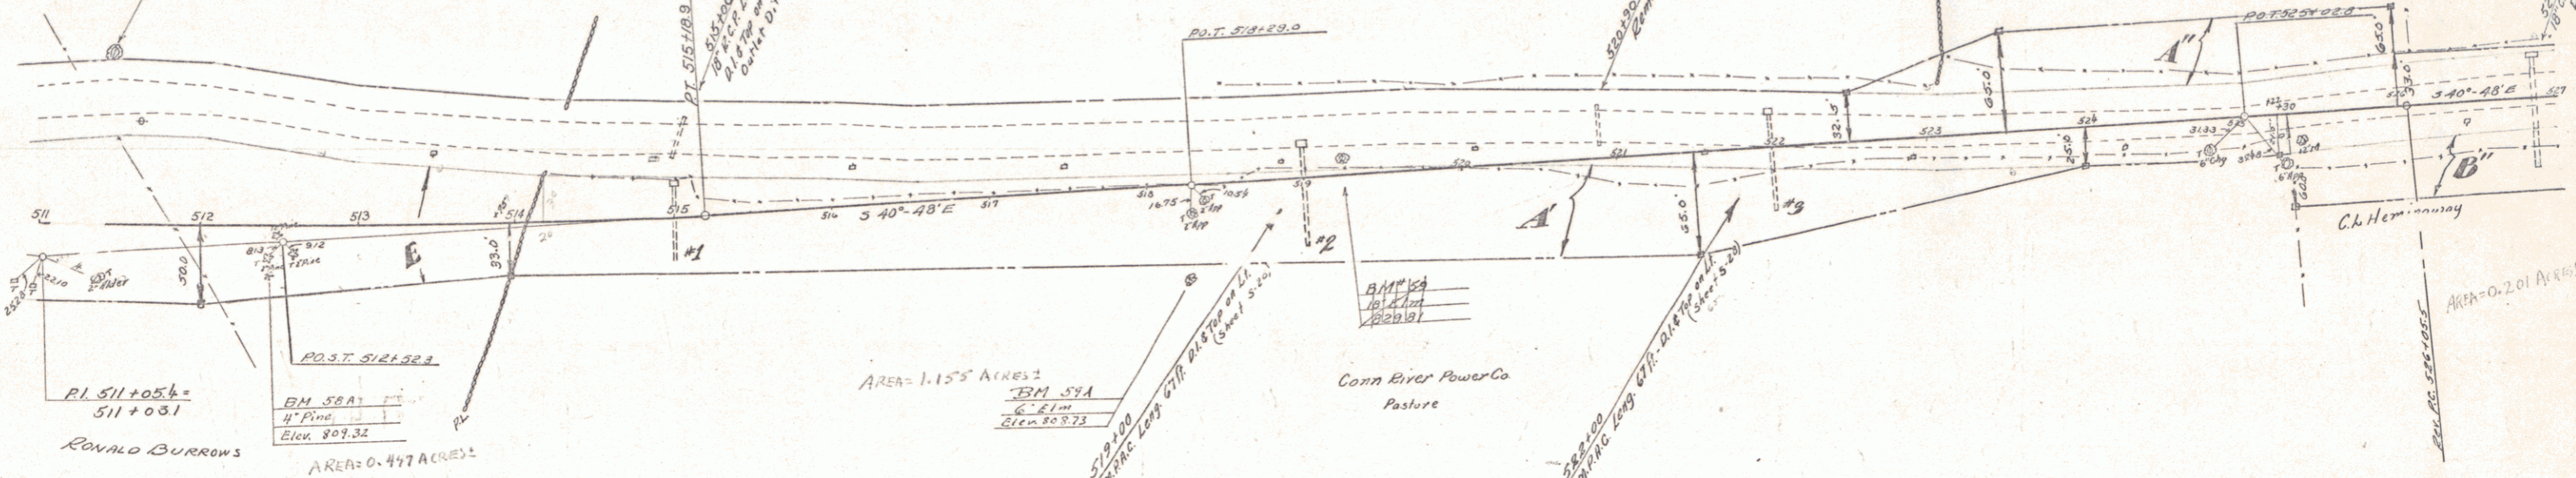

PARCEL	INSTRUMENT	DATE	GRANTOR	GRANTEE	RECORDED	REMARKS
A B C D E	G.C.D.	9-9-37	RONALD BURROWS	CLARENCE BARKETT	BOOK PAGE DATE	CUL. STA.
A B C D E	G.C.D.	9-3-37	CONNECTICUT RIVER POWER CO.	"	25 171-200 100 9-23-37	146-536-60 " 12-5-31-36
A B C	G.C.D.	7-14-37	C.H. HEMINGWAY	"	25 100-103 7-23-37	"
A-B-C-D-E	ADMIN DEED	8-20-37	JOHN W. DAVIS ESTATE	"	25 106-7-1 8-27-37	"

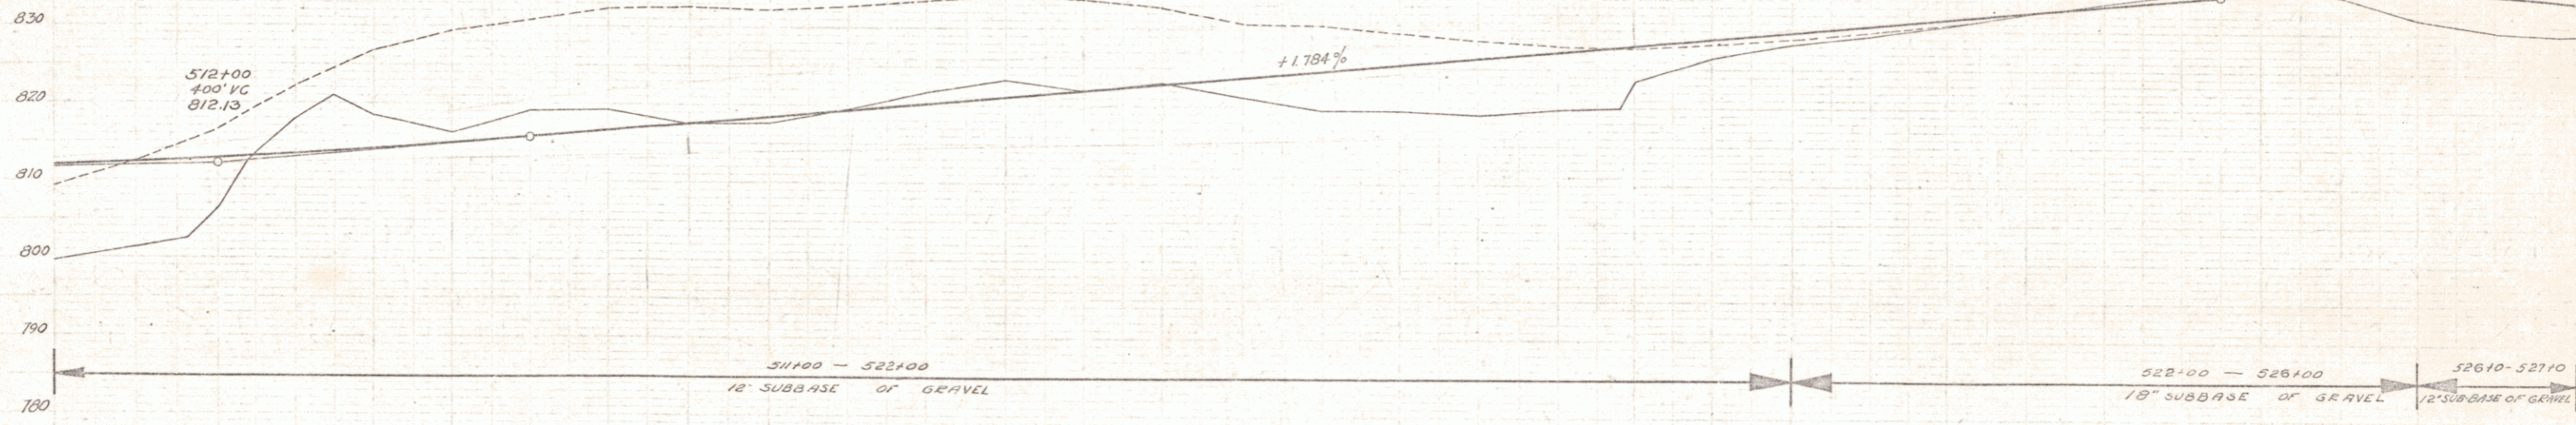

STATION	ELEVATION	STATION	ELEVATION	STATION	ELEVATION
511	817.6	514	815.0	517	812.0
512	812.13	515	811.7	518	811.0
513	812.13	516	811.5	519	810.6
514	812.13	517	811.0	520	810.0
515	812.13	518	810.5	521	809.5
516	812.13	519	810.0	522	809.0
517	812.13	520	809.5	523	808.5
518	812.13	521	809.0	524	808.0
519	812.13	522	808.5	525	807.5
520	812.13	523	808.0	526	807.0
521	812.13	524	807.5	527	806.5

BM 581 S.T. 4" Pine 30' RT 3m. 512+46 Elev 809.32
 BM 582 S.T. 4" Pine 106' RT 512+11 Elev 812.09
 BM 583 S.T. 4" Pine 105' RT 513+23 Elev 812.01
 BM 584 S.T. 4" Pine 60' RT 514+25 Elev 808.73