


PARCEL	INSTRUMENT	DATE	GRANTOR	GRANTEE	RECORDED
AB, CD, E	G.C.D.	9-3-37	CONNECTICUT RIVER POWER CO.	STATE	194/200 20 125-37

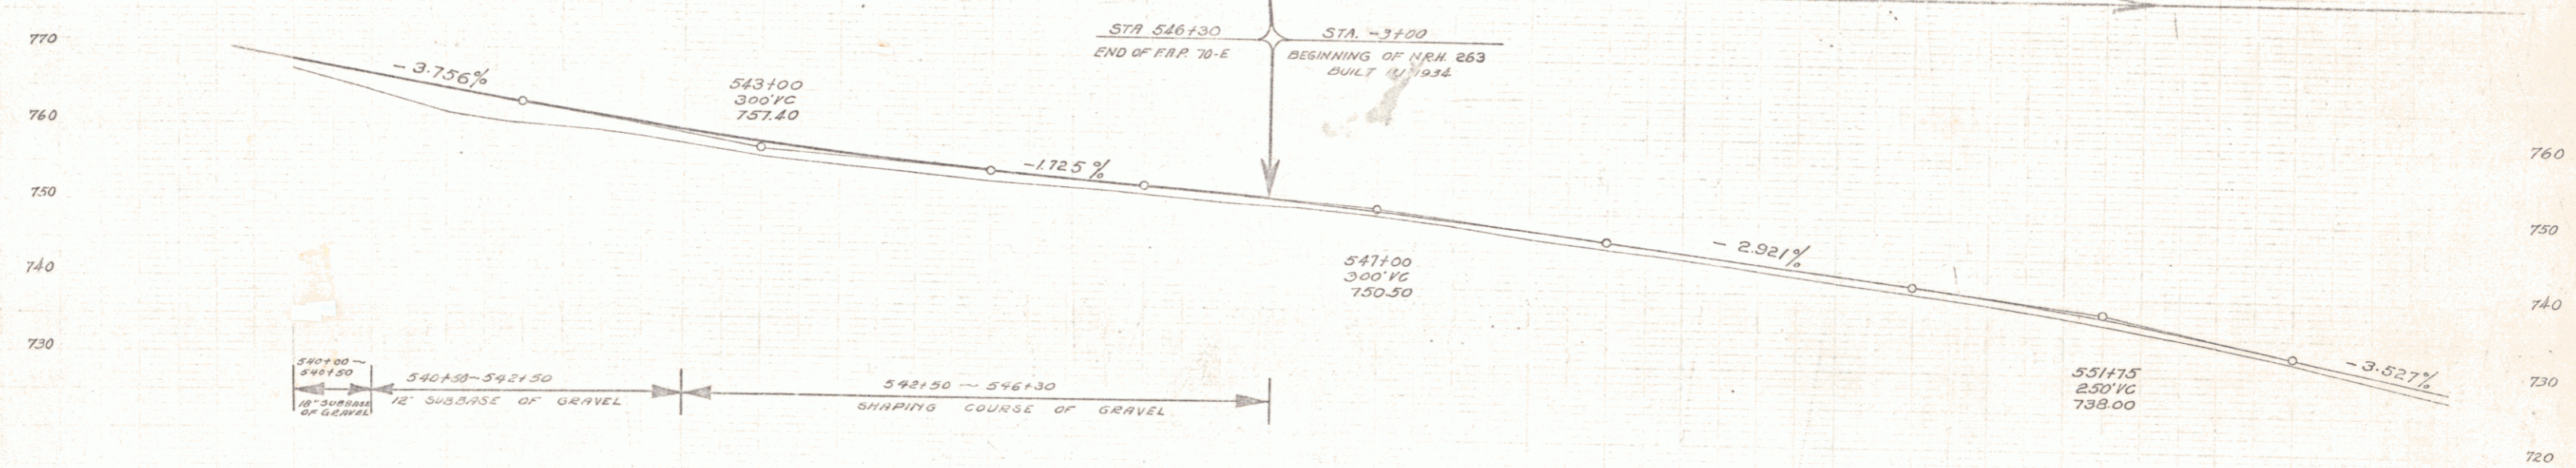

Station	Elevation
540+00	756.07
540+10	756.29
540+20	756.49
540+30	756.70
540+40	756.91
540+50	757.12
541+00	757.33
541+10	757.54
541+20	757.75
541+30	757.96
541+40	758.17
541+50	758.38
542+00	758.59
542+10	758.80
542+20	759.01
542+30	759.22
542+40	759.43
542+50	759.64
543+00	759.85
543+10	759.95
543+20	759.95
543+30	759.95
543+40	759.95
543+50	759.95
544+00	759.95
544+10	759.95
544+20	759.95
544+30	759.95
544+40	759.95
544+50	759.95
545+00	759.95
545+10	759.95
545+20	759.95
545+30	759.95
545+40	759.95
545+50	759.95
546+00	759.95
546+10	759.95
546+20	759.95
546+30	759.95
546+40	759.95
546+50	759.95
547+00	759.95
547+10	759.95
547+20	759.95
547+30	759.95
547+40	759.95
547+50	759.95
548+00	759.95
548+10	759.95
548+20	759.95
548+30	759.95
548+40	759.95
548+50	759.95
549+00	759.95
549+10	759.95
549+20	759.95
549+30	759.95
549+40	759.95
549+50	759.95
550+00	759.95
550+10	759.95
550+20	759.95
550+30	759.95
550+40	759.95
550+50	759.95
551+00	759.95
551+10	759.95
551+20	759.95
551+30	759.95
551+40	759.95
551+50	759.95
552+00	759.95
552+10	759.95
552+20	759.95
552+30	759.95
552+40	759.95
552+50	759.95
553+00	759.95
553+10	759.95
553+20	759.95
553+30	759.95
553+40	759.95
553+50	759.95

BM #2 51.2 18.1m 47.41 Sta 540+33 Elev 760.1
 BM #3 14.30 21.55 Sta 551+43 Elev 738.28