



FED. ROAD DIST. NO.	STATE	FISCAL YEAR	SHEET NO.	TOTAL SHEETS
9	VT	1938	7	36

PARCEL INSTRUMENT DATE GRANTOR GRANTEE RECORDED WATERFORD
 A G.C.D. 7-14-37 MAURICE PELLETIER ST. J. 8005 PAGE DATE
 104 125-37

CURVE
 Δ 2° 28' 11"
 D 1° 00'
 E 5729.7
 T 223.9
 L 446.7
 R 4.4

CURVE
 Δ 34° 44' 11"
 D 5° 20'
 E 1074.7
 T 539.6
 L 1332.7
 R 193.8

BURETT AND DONALD
 12-25
 2-37
 TRACED
 ALDORFIELD
 2-37

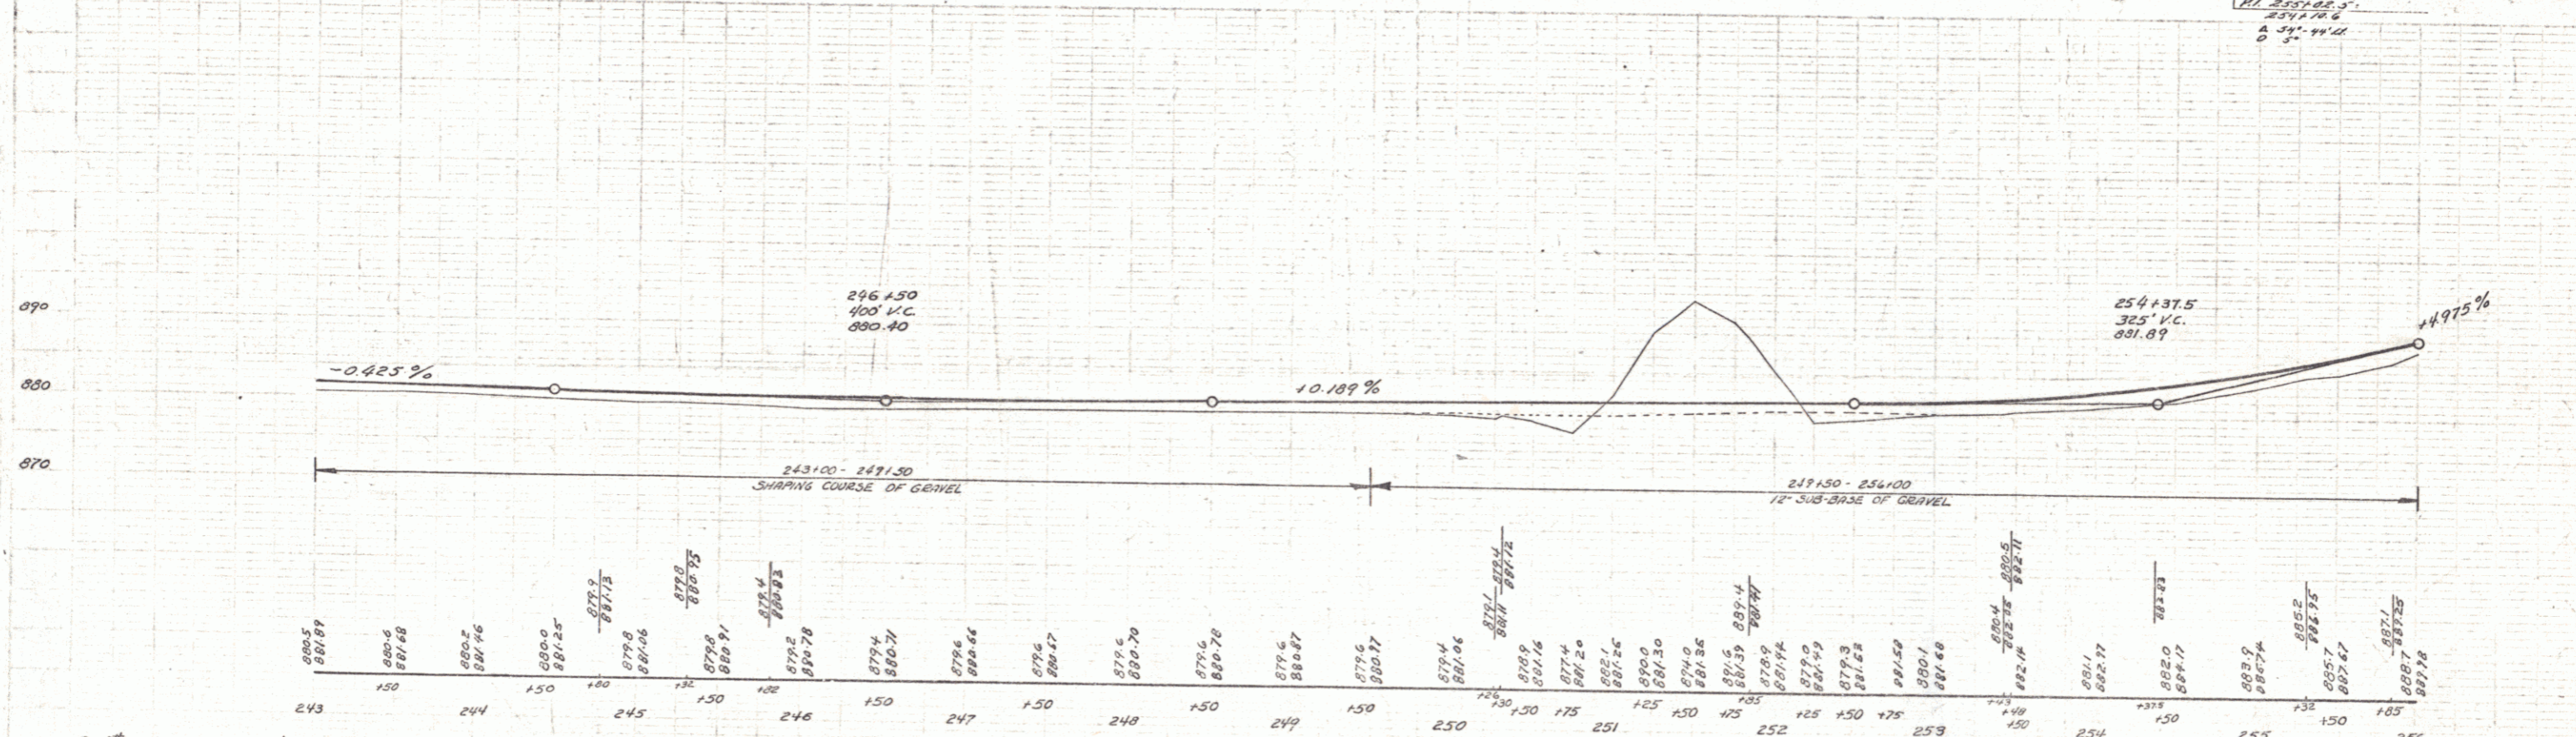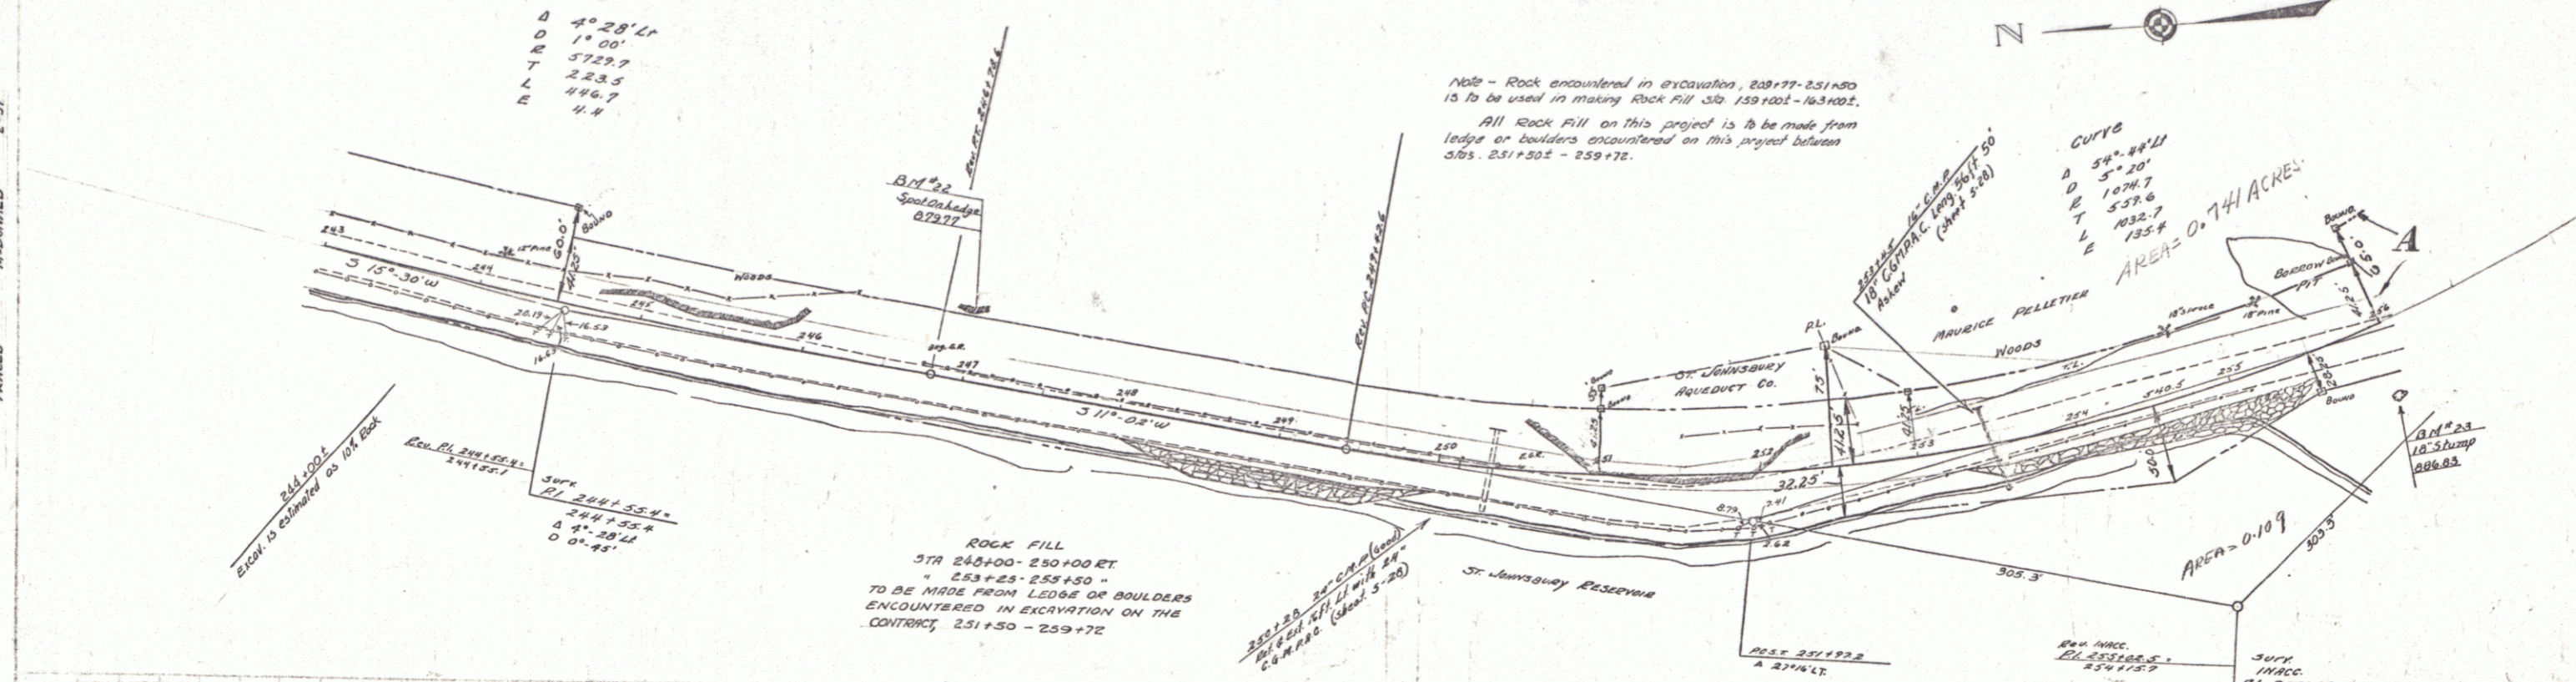

B.M. 22 Spool on Ledge to 41 Sta 246+90 Elev 879.97
 B.M. 23 Spike 10' Stamp 53 R1 - 255+87 - 886.83