


GUARD RAIL REQUIRED
 ON LEFT
 Sta. 29+28 to Sta. 29+52 Length 24ft
 " 35+38 " " 35+62 " 24"
 ON RIGHT
 Sta. 29+28 to Sta. 29+52 Length 24ft
 " 34+84 " " 35+14 " 30"
 " 35+38 " " 35+62 " 24"
 " 37+34 " " 40+00 " 266"
 Total this sheet 522 ft


NEW CULVERTS REQUIRED
 Sta. 29+40 16" Corrt. Pipe Length 28ft
 1-8" Concrete 18 Cu yds.
 Sta. 35+50 16" Corrt. Pipe Length 28ft
 1-8" Concrete 18 Cu yds.

SUBBASE REQUIRED
 Sta. 27+00 to Sta. 38+50 Length 1750ft

FED. ROAD DIST. NO.	STATE	FED. AID	FISCAL YEAR	SHEET NO.	TOTAL SHEETS
104	Vt.		1944	5	21

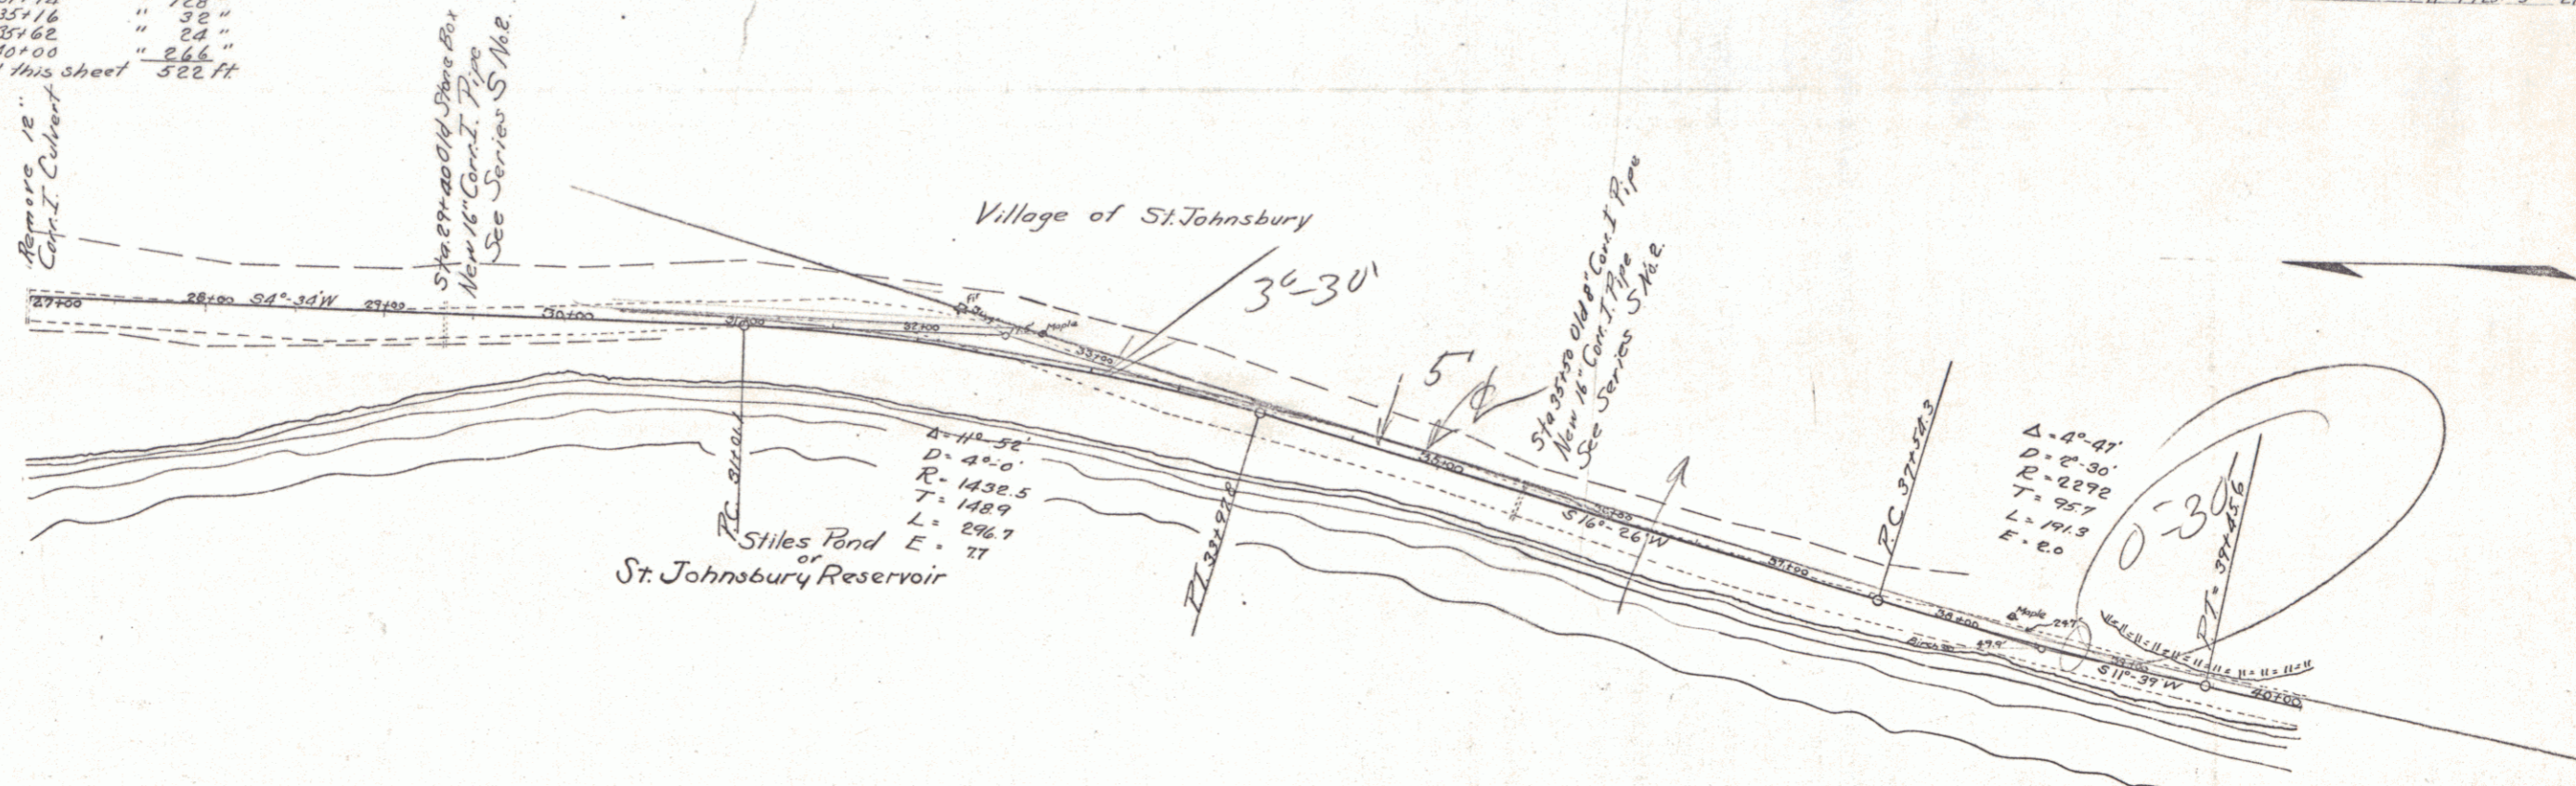

M.C. Brodley 7/20/44

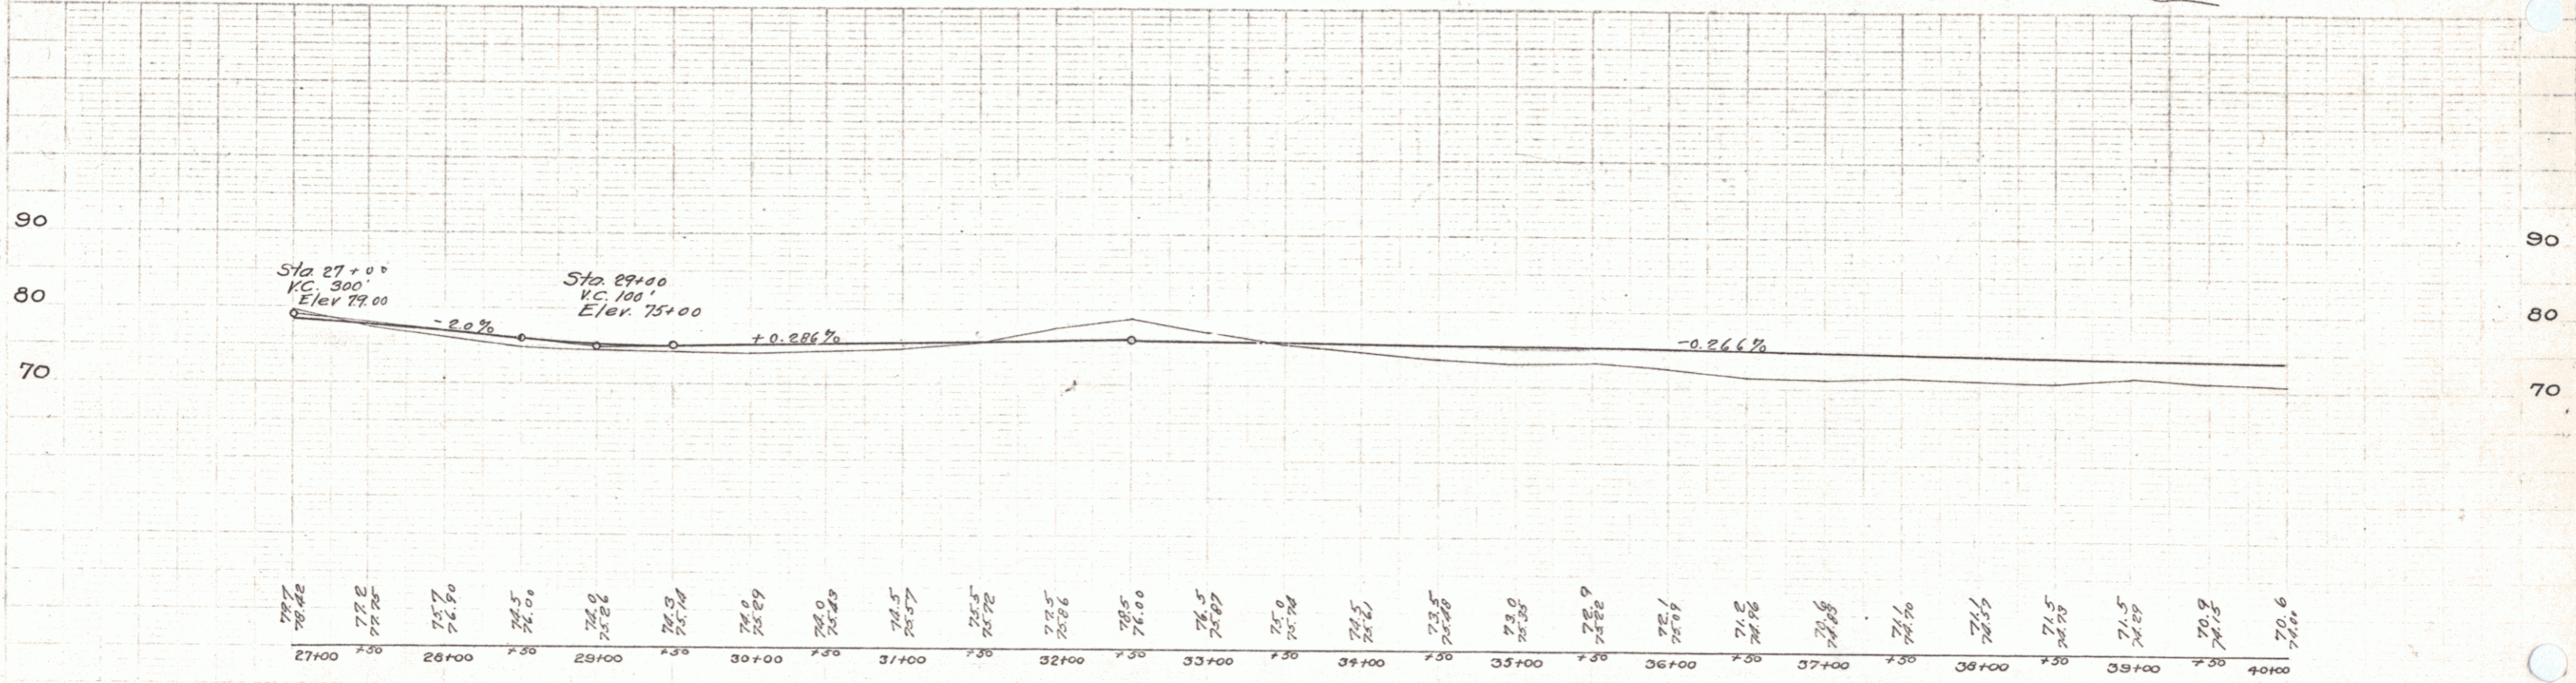

Series F No. 7671 Filed
Sheet 5 of 21