
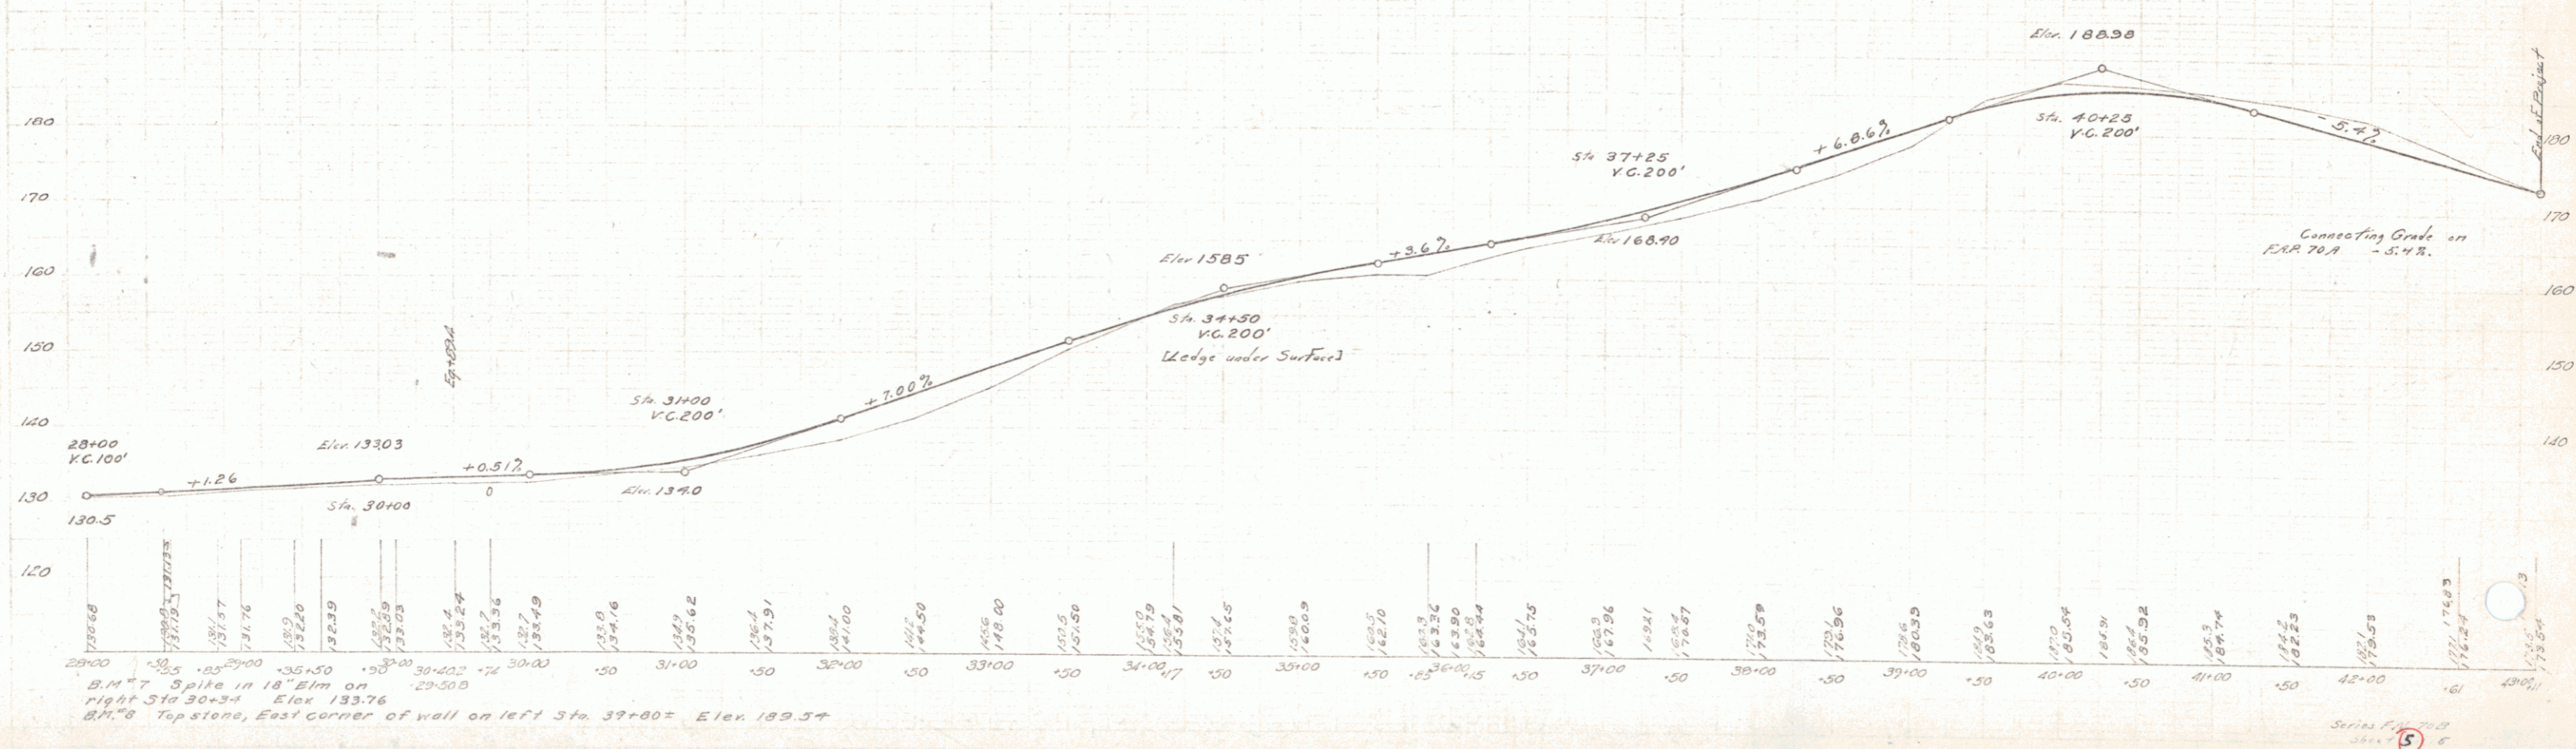


**GUARD RAIL REQUIRED**  
 ON LEFT  
 Sta. 29+62 to Sta. 29+86 Length 24 Ft.  
 - 35+38 - 35+62 24 -  
 ON RIGHT  
 Sta. 29+00 to Sta. 30+03 Length 103 Ft. 9'-8"  
 - 35+38 - 36+50 112 -  
**TOTAL THIS SHEET 352 Ft**

**NEW CURVEITS REQUIRED**  
 Sta. 29+74 16" Cur. Iron Pipe Length 30 Ft  
 1-2x-5 Concrete 2.5 cu yd.  
 Sta. 30+80 14" Cur. Iron Pipe Length 33 Ft  
 1-2x-5 Concrete 2.0 cu yd.

**SUB-DASE REQUIRED**  
 Sta. 33+25 to Sta. 39+50 Length 425 Ft.

NO.	DATE	BY	CHECKED	TOTAL
22				10

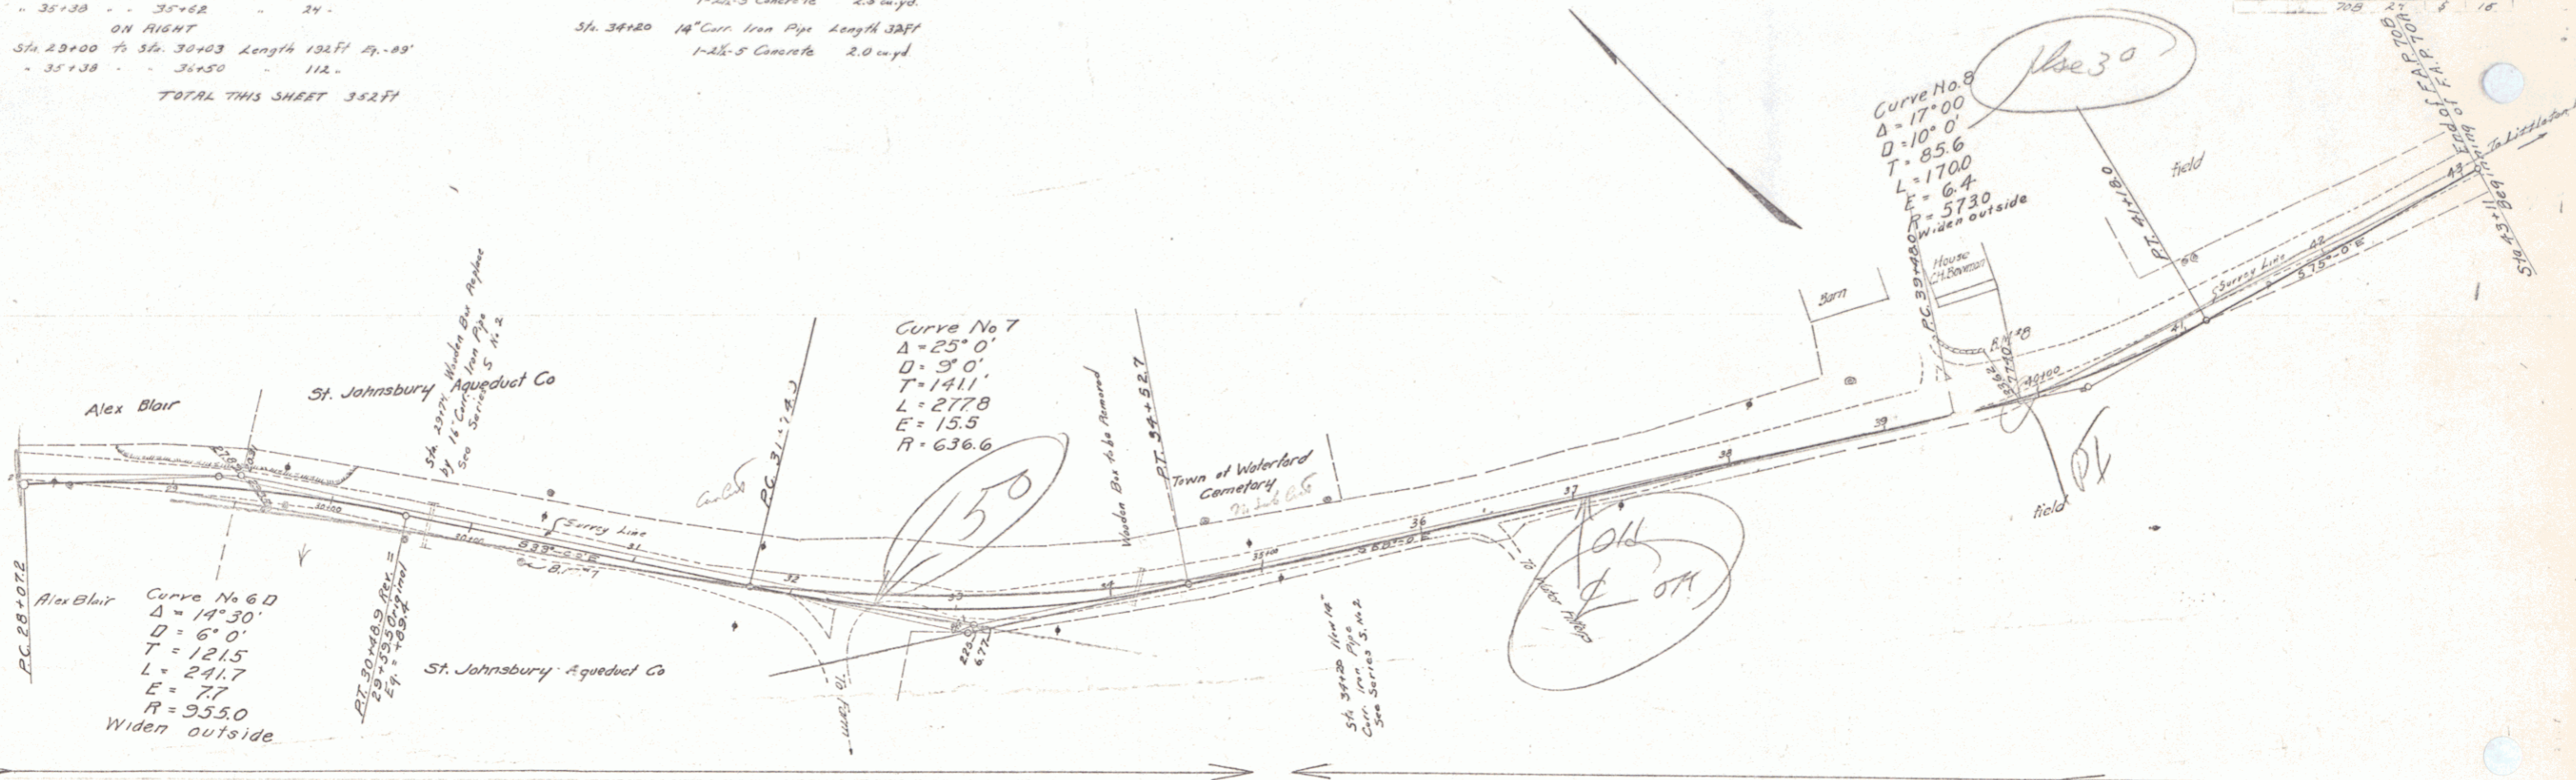

B.M. 7 Spite in 18" Elm on right Sta. 30+34 Elev 133.76  
 B.M. 8 Top stone, East corner of wall on left Sta. 39+00 Elev 189.54

Series F-1000  
 5