



7-39
7-41
7-41
LOVE
ADGERS
CLARK

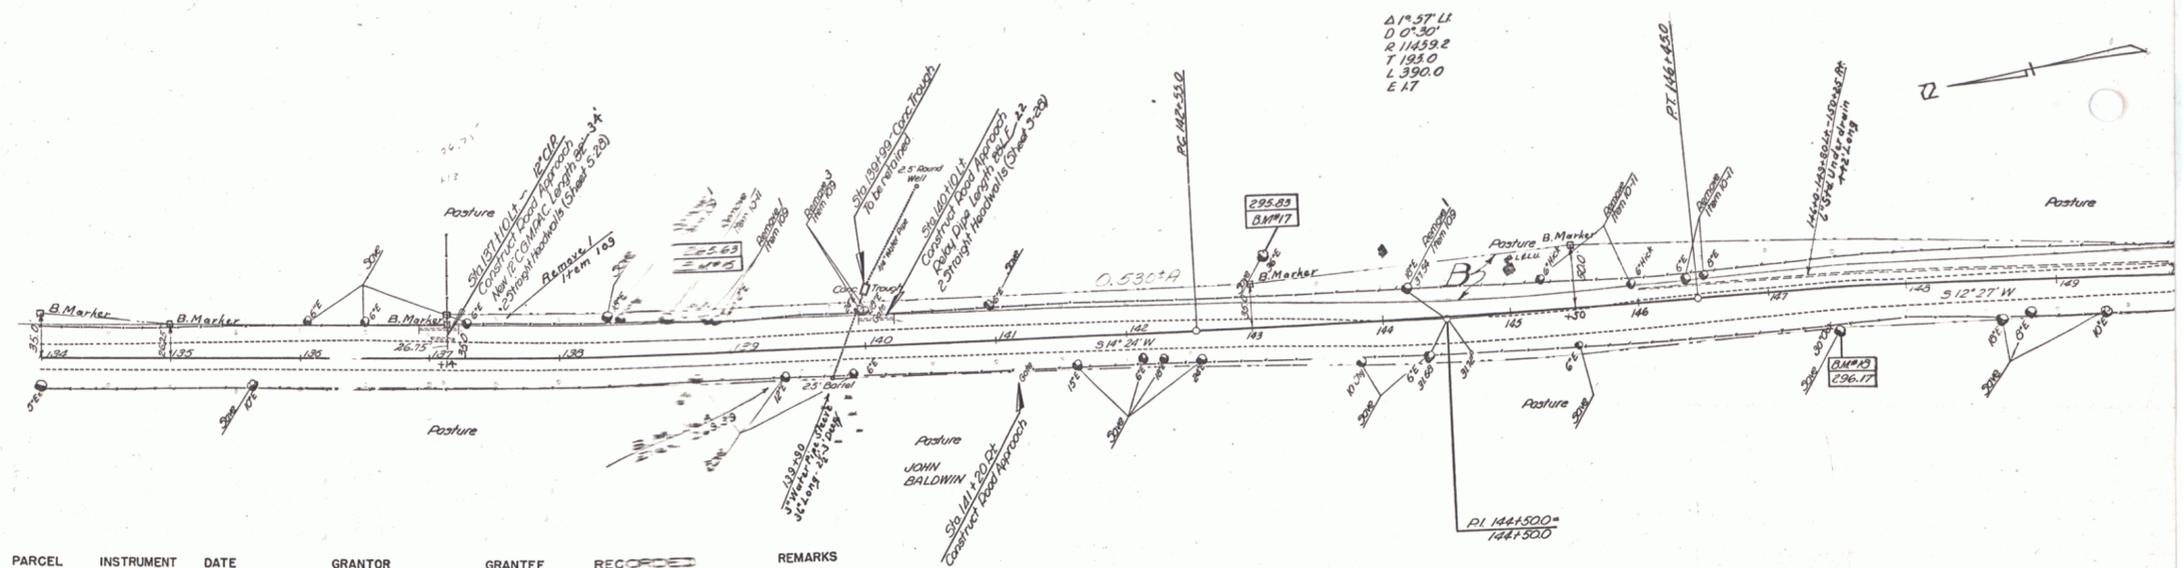

PARCEL	INSTRUMENT	DATE	GRANTOR	GRANTEE	RECORDED	REMARKS
B	W.D.O.E.	11-29-41	ELIE B TRYON	ST OF VT	BOOK 21 PAGE 355-5	DATE 12-27-41

A. S. BALDUCCI

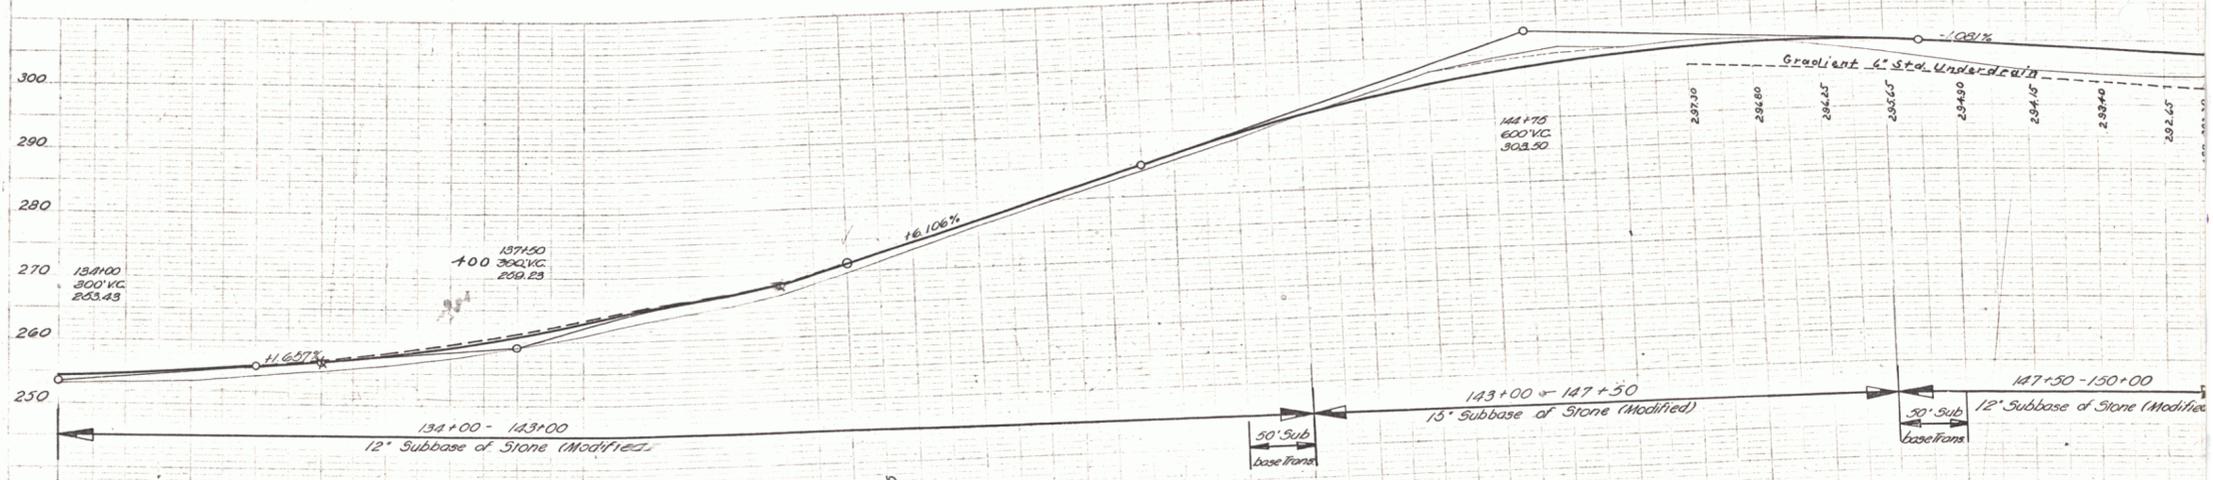

Station	Elevation	Remarks
134	253.43	BM #16
135	255.16	Spike in Root of 10' Elm
136	256.89	Spike in Root of 36' Elm
137	258.62	Spike in Root of 30' Oak Elm
138	260.35	LI of Sta. 138+00
139	262.08	LI of Sta. 143+00
140	263.81	RI of Sta. 147+50
141	265.54	7th. of Sta. 139+30
142	267.27	
143	269.00	
144	270.73	
145	272.46	
146	274.19	
147	275.92	
148	277.65	
149	279.38	
150	281.11	