


PARCEL	INSTRUMENT	DATE	GRANTOR	GRANTEE	RECORDED ORWELL BOOK	ORWELL PAGE	DATE	REMARKS
B	W.D.O.E.	11-20-41	MRS. EDMUND PRESEAU	ST. OF VT.	26	349	12-12-41	
A	W.D.O.E.	11-20-41	JOSEPH ALBION CHRISTIAN	ST. OF VT.	26	347	12-12-41	

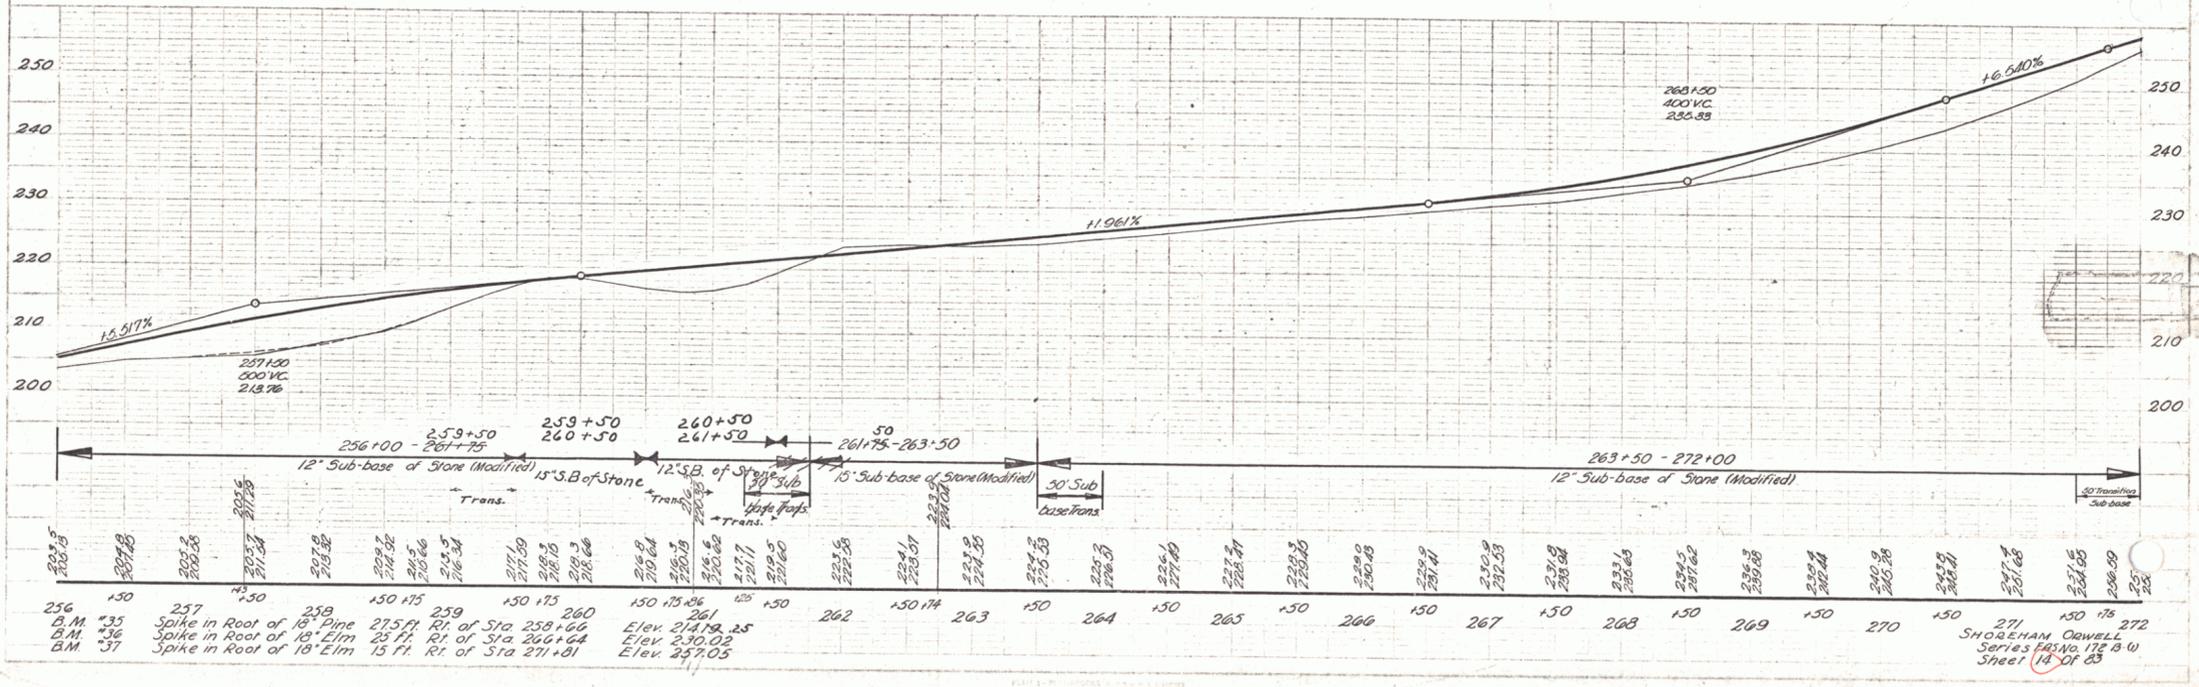

SHOREHAM ORWELL
 Series No. 172 B.W.
 Sheet 14 of 83