


PARCEL	INSTRUMENT	DATE	GRANTOR	GRANTEE	RECORDED BOOK	ORWELL PAGE	DATE	REMARKS
B	WDOE	11-20-41	JOSEPH & ALBINA CHRISTIAN	ST. OF VT.	26	347	12-12-41	
B, 1/2	WDOE	7-15-42	JOSEPH & ALBINA CHRISTIAN	ST. OF VT.	26	413	8-12-42	

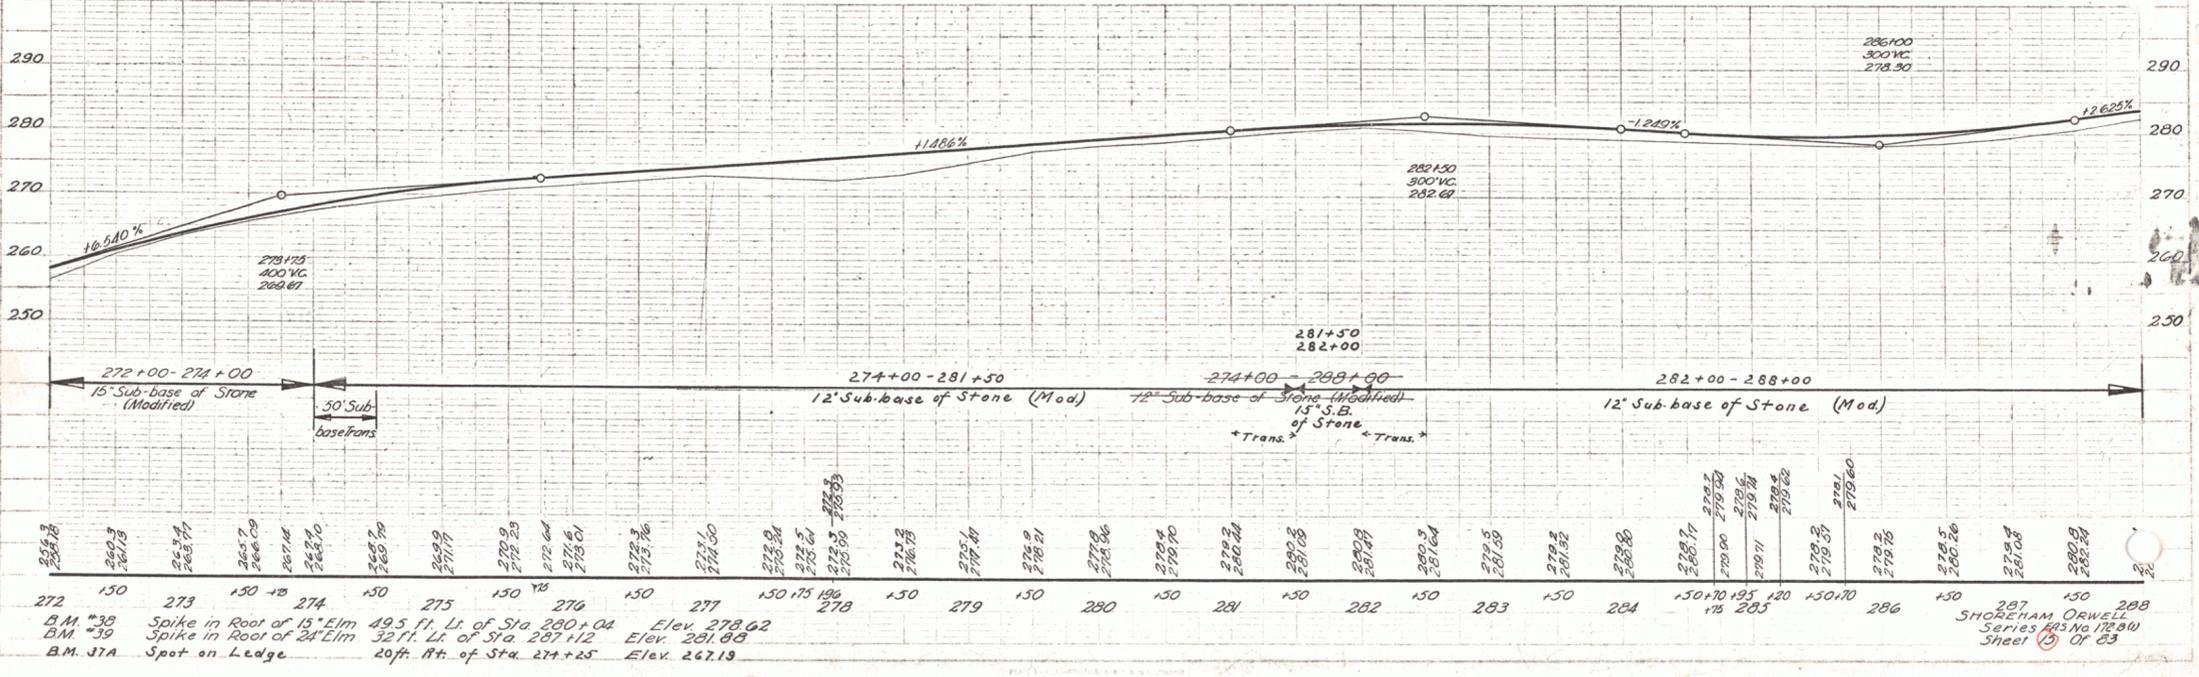

B.M. #38 Spike in Root of 15' Elm 49.5 ft. Lt. of Sta. 280+04 Elev. 278.62  
 B.M. #39 Spike in Root of 24' Elm 32.7 ft. Lt. of Sta. 287+12 Elev. 281.93  
 B.M. #37A Spot on Ledge 20 ft. Rt. of Sta. 274+25 Elev. 267.19

SHORHAM ORWELL  
 SERIES #15 No. 178.910  
 SHEET 13 OF 13