
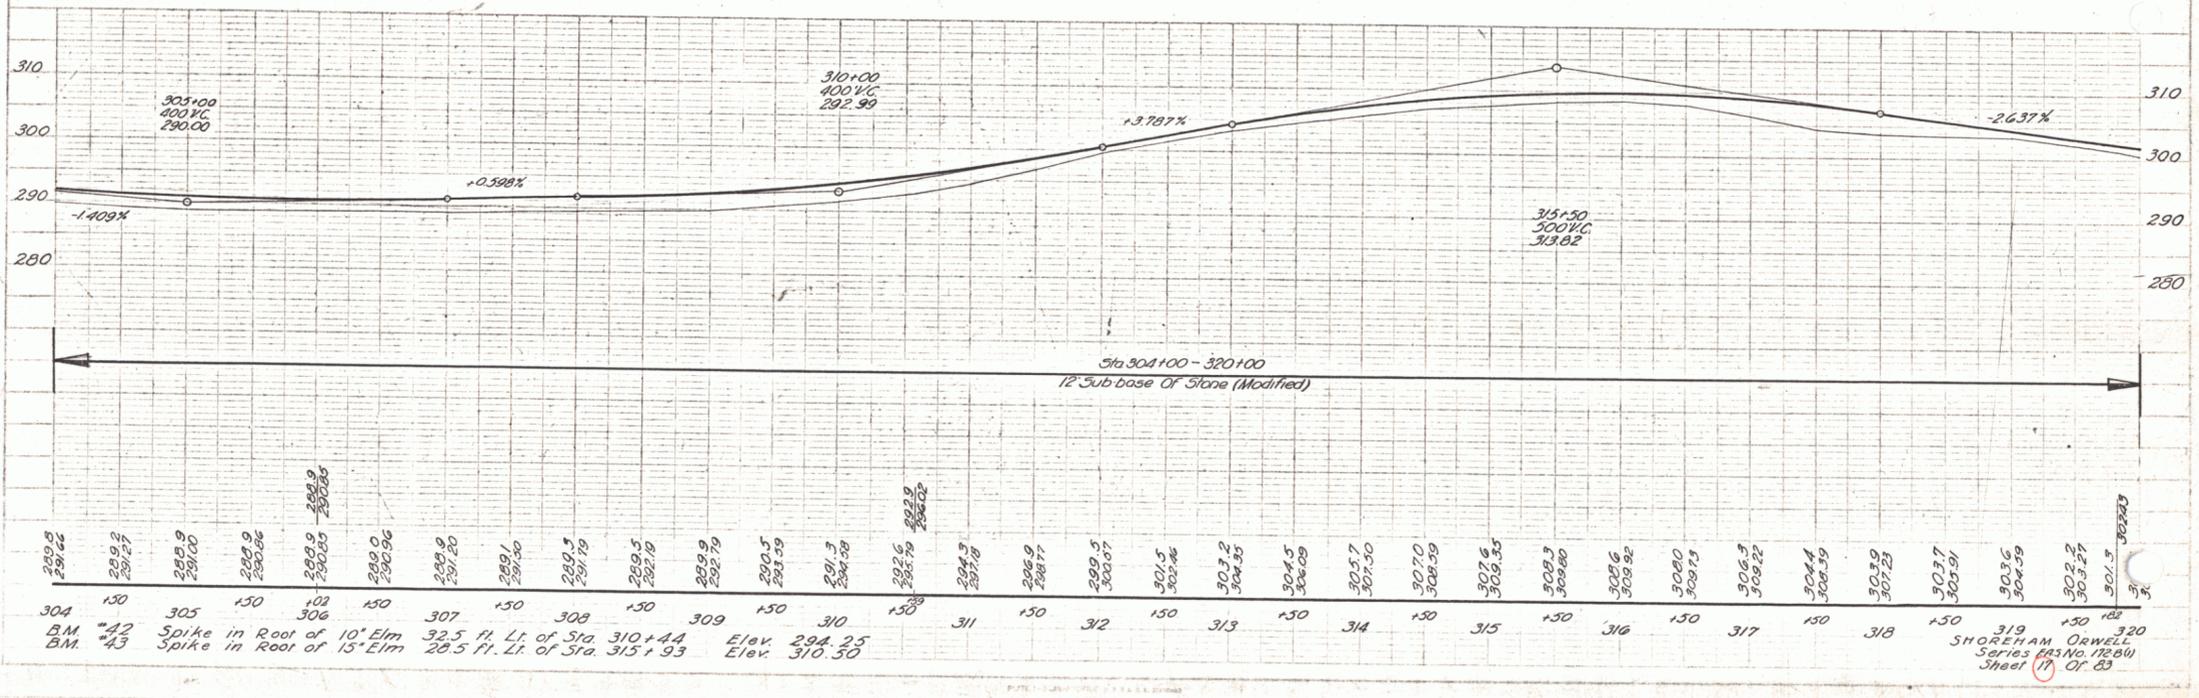


STA 308+90 - 319+95
SAVE TREES

PL. DRAWN	DATE	SHEET	TOTAL SHEETS
17684	1942.17	83	83

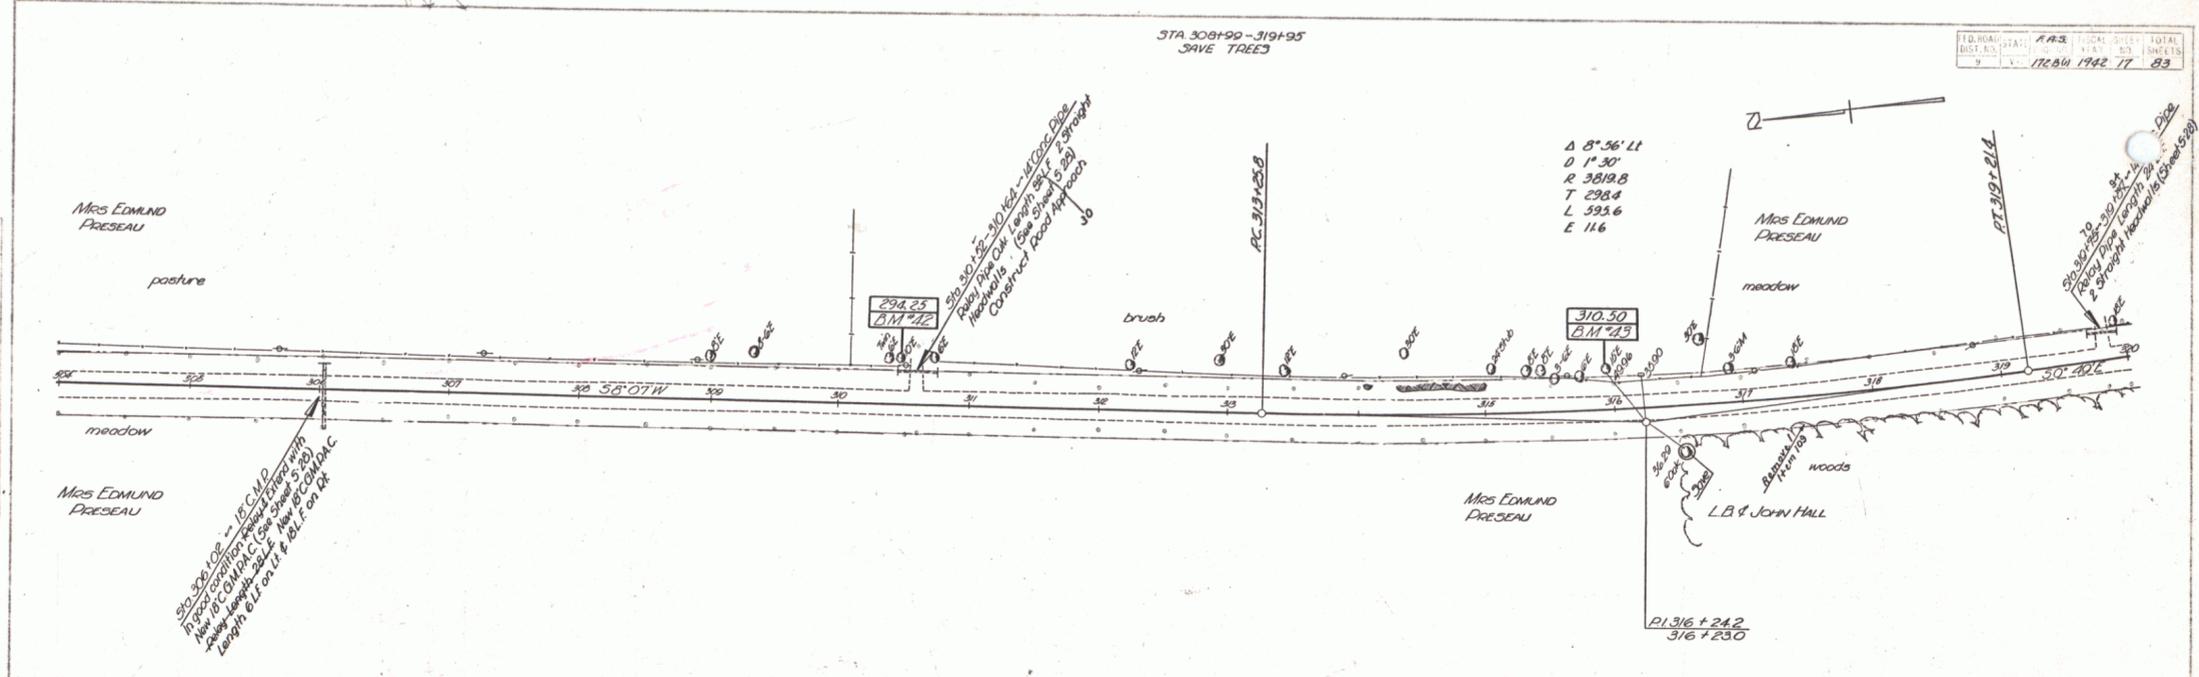

PLAN
SHEET NO. 83
DATE 17684
1942.17

PLAN
SHEET NO. 83
DATE 17684
1942.17

304 B.M. #12 Spike in Root of 10' Elm
305 B.M. #13 Spike in Root of 15' Elm
306 32.5 ft. Lt. of Sta 310+44
307 20.5 ft. Lt. of Sta 315+93
308 Elev. 294.25
309 Elev. 310.50

319 SHOREHAM ORWELL
Series 443 No. 1284
Sheet 17 of 83