


PARCEL	INSTRUMENT	DATE	GRANTOR	GRANTEE	RECORDED
A	W.D.D.E.	12-30-41	EMMA NEEDHAM BROWN	57' OF IT	ORWELL 26 325 12-27-41
A'	W.D.D.E.	11-20-41	ALFRED BOURDEAU	57' OF IT	26 352 12-12-41

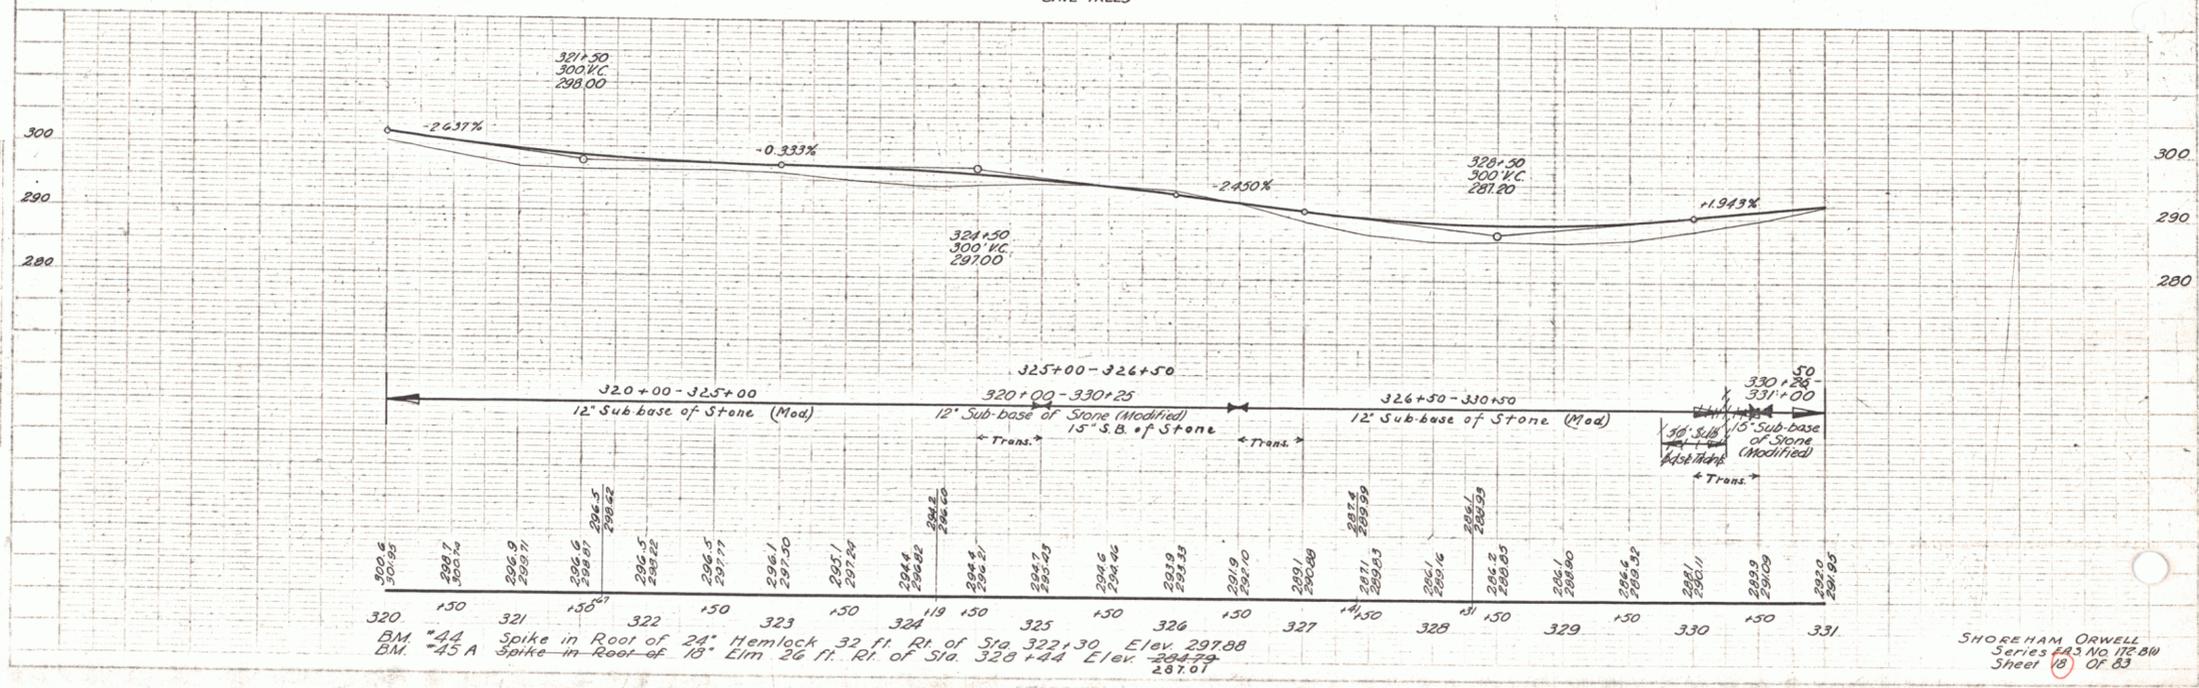

320 150 321 150 322 150 323 150 324 119 150 325 150 326 150 327 150 328 150 329 150 330 150 331

BM #44 Spike in Root of 24" Hemlock 32 ft. Ri. of Sta. 322+30 Elev. 297.88  
 BM #45 A Spike in Root of 18" Elm 26 ft. Ri. of Sta. 328+44 Elev. 287.01

SHOREHAM ORWELL  
 Series 423 No 17280  
 Sheet 18 OF 83

PLAN  
 DATE  
 DRAWN BY  
 CHECKED BY

ASBANE  
 1-2-42