



DIST. NO.	STATE	F.R. PROJ. NO.	FISCAL YEAR	SHEET NO.	TOTAL SHEETS
8	VT	104	1933	4	87

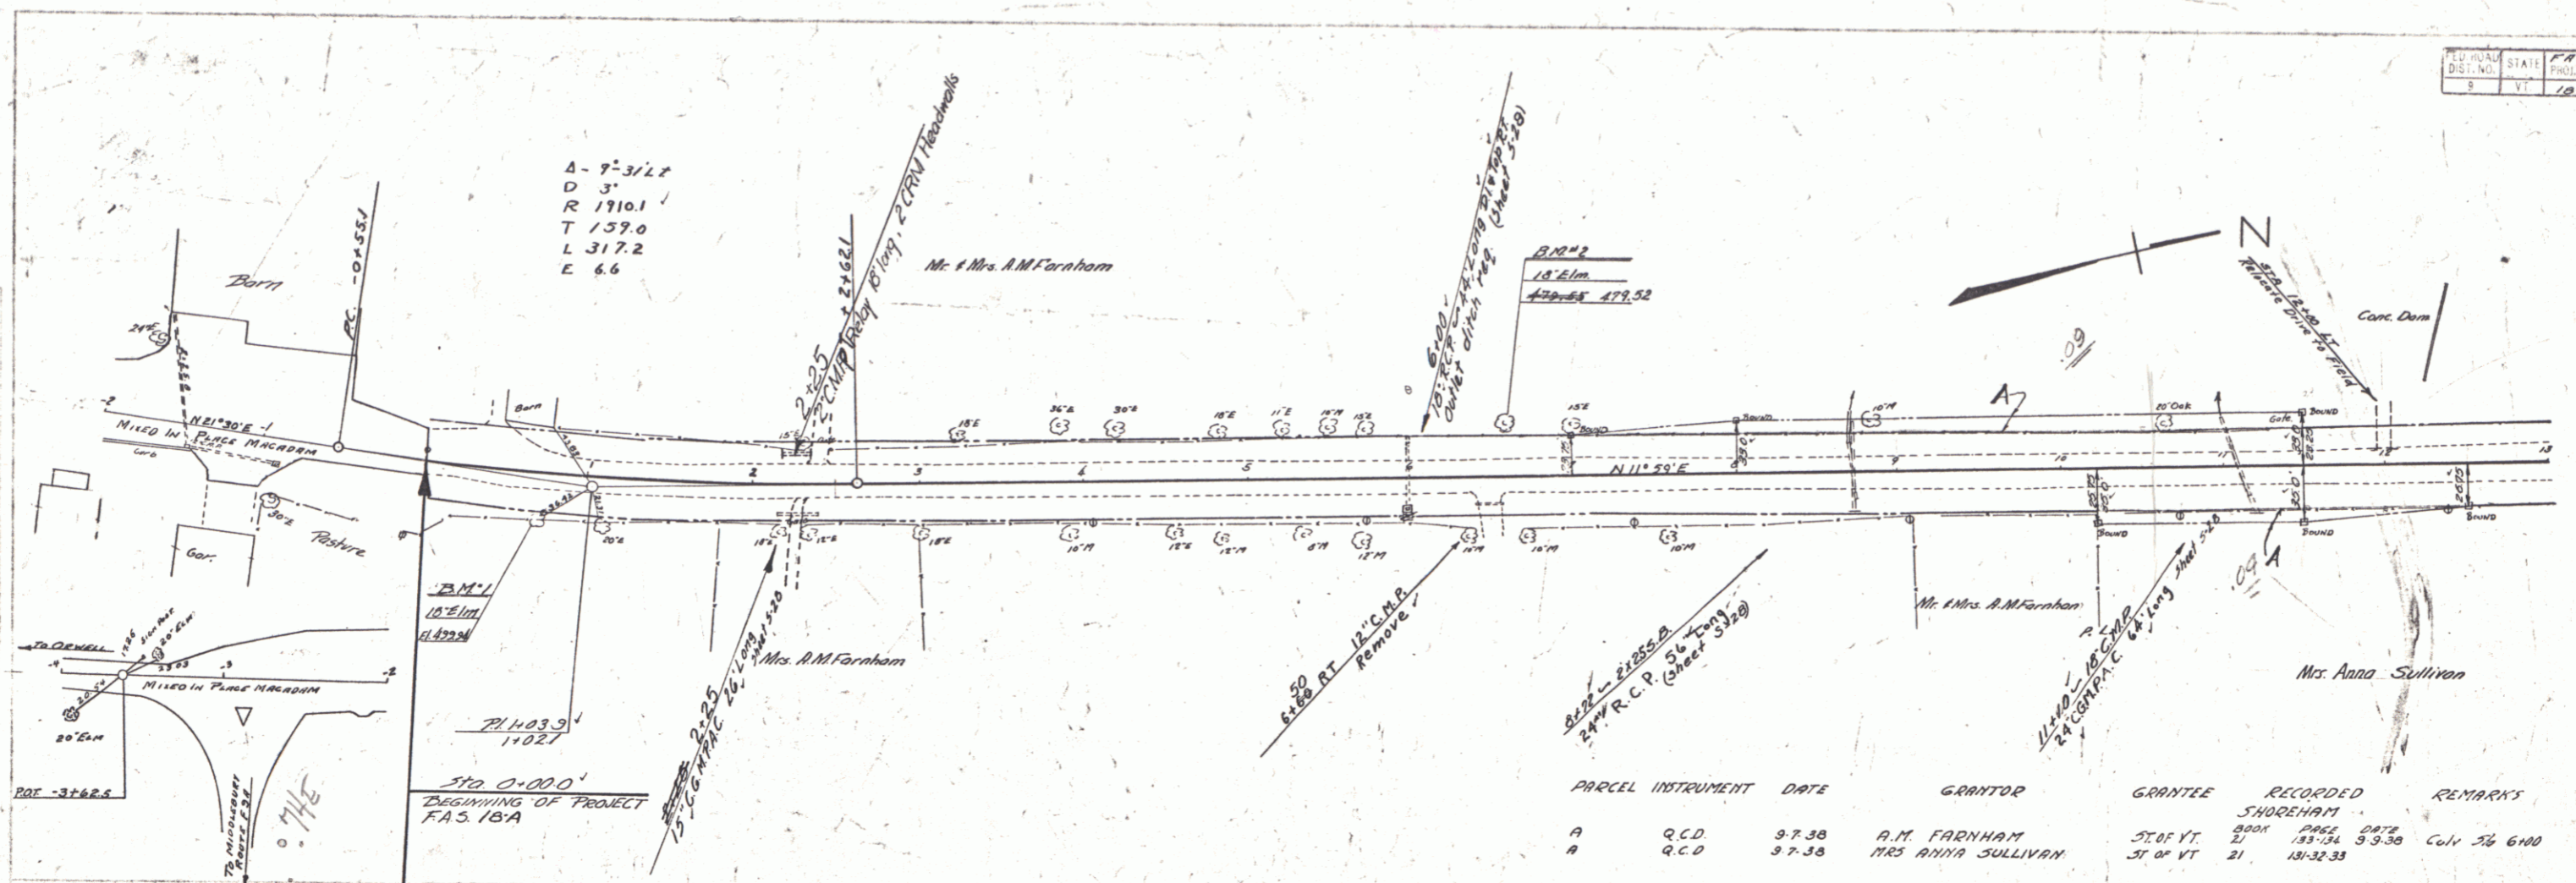

PARCEL	INSTRUMENT	DATE	GRANTOR	GRANTEE	RECORDED	REMARKS
A	Q.C.D.	9-7-30	A.M. FARNHAM	ST OF VT	21	SHOREHAM
A	Q.C.D.	9-7-30	MRS ANNA SULLIVAN	ST OF VT	21	SHOREHAM

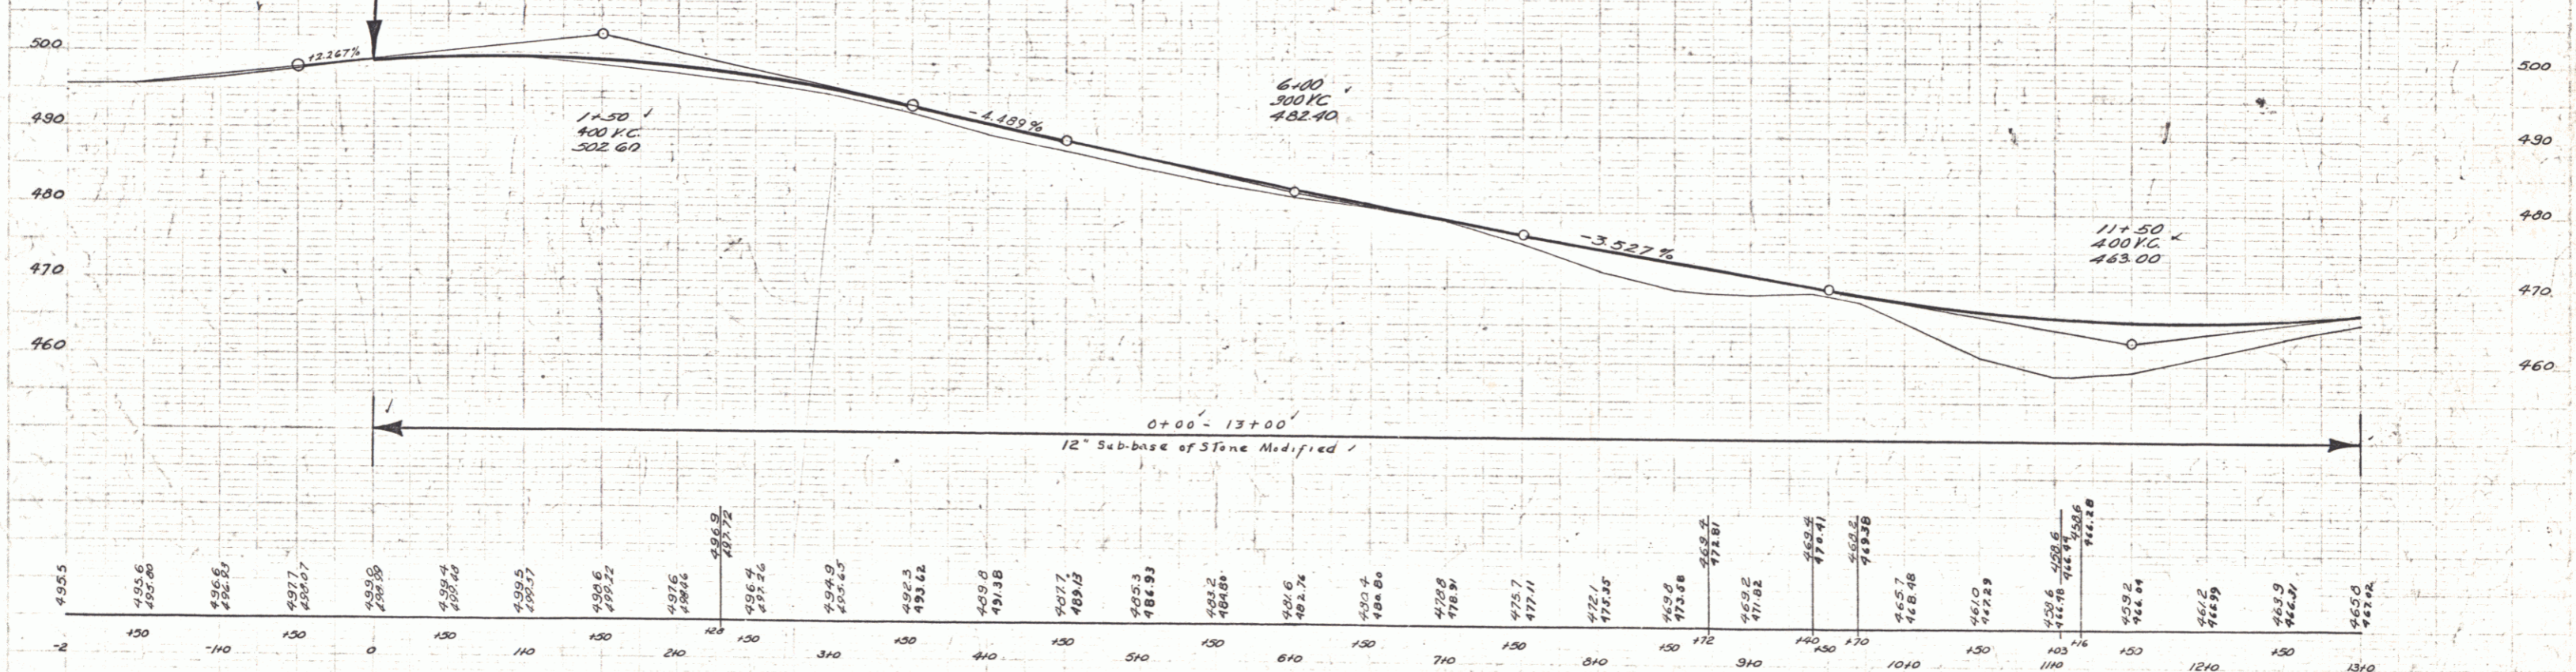

B.M. #1 SPIKE IN ROOT 18" ELM 26.5 FT. RT. STA. 0+71 ELEV. 499.94
 B.M. #2 SPIKE IN ROOT 18" ELM 26 FT. LT. STA. 6+54 ELEV. 479.52

SERIES FAS No 18 A
 SHEET 4 of 97