


PARCEL	INSTRUMENT	DATE	GRANTOR	GRANTEE	RECORDED	REMARKS
B	Q.C.D.	9-7-38	A.M. FARHAM	ST OF VT	181-33-38	3-3-38
B.C.D.	Q.C.D.	9-7-38	MRS ANNA SULLIVAN	ST OF VT	181-33-38	9-9-38

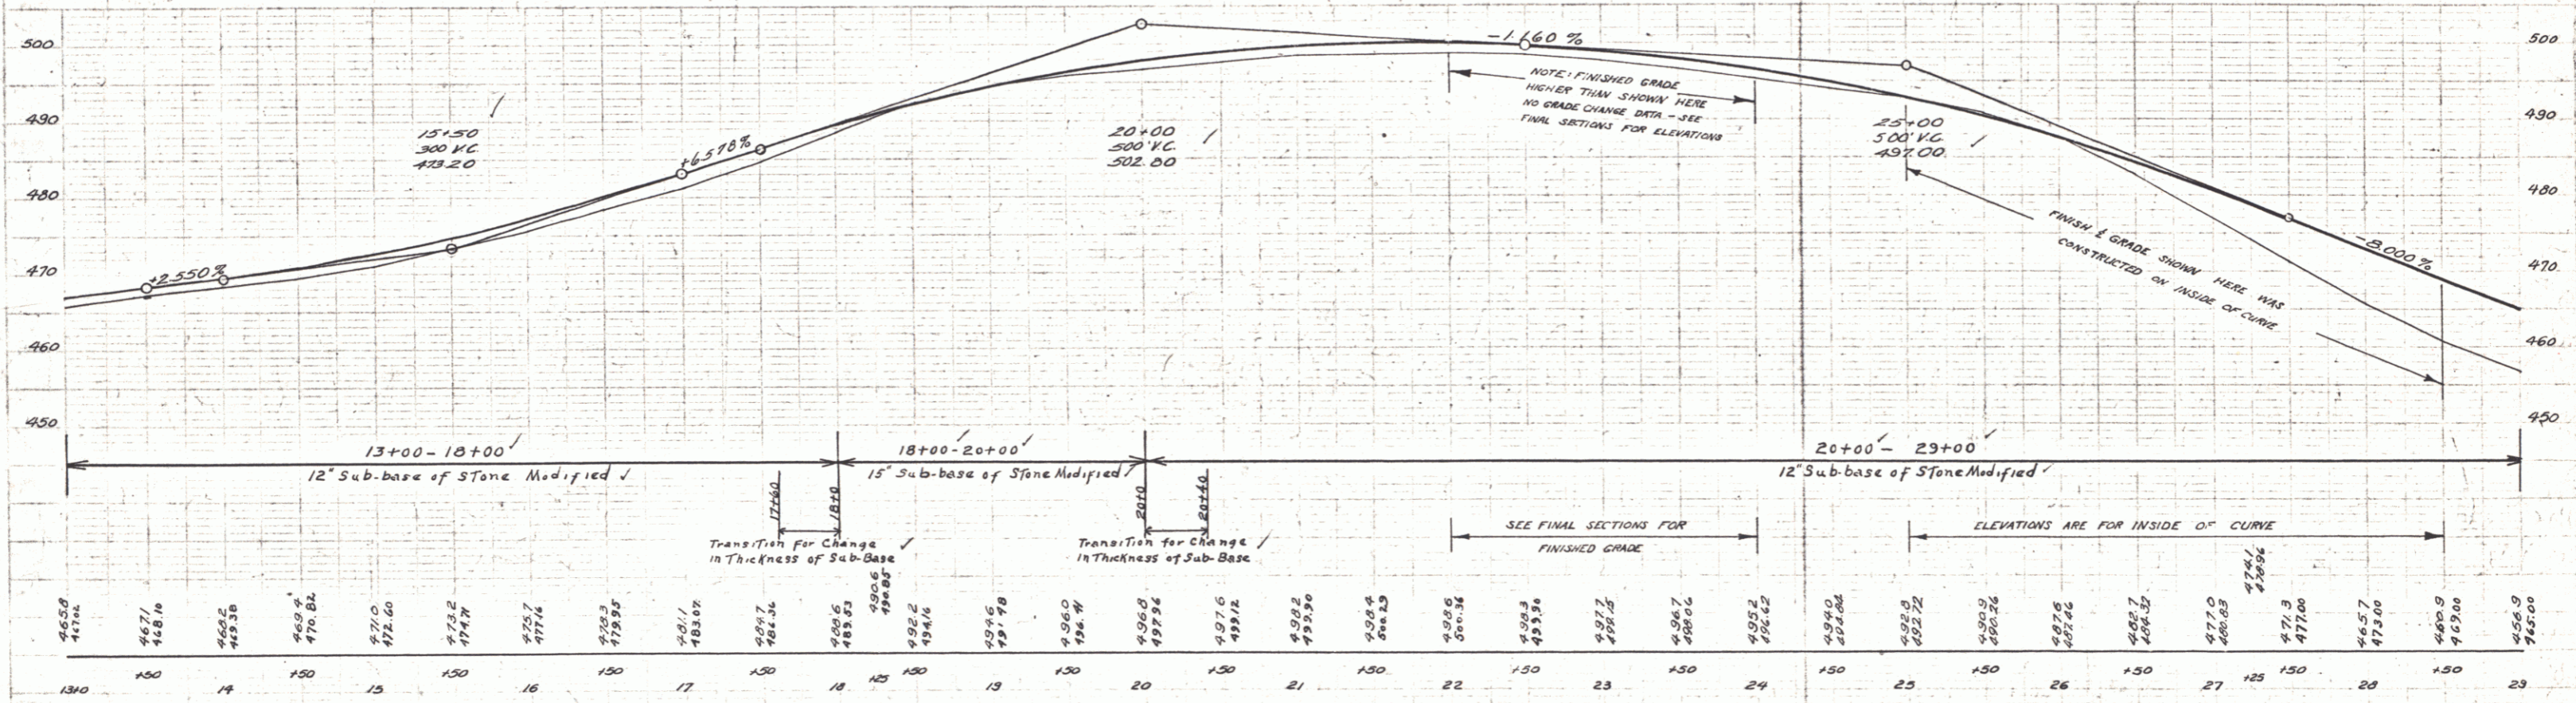

B.M. #3 SPIKE IN ROOT 24" ELM 29 FT. LT. STA. 14+20 ELEV. 466.67
 B.M. #4 SPIKE IN ROOT 12" ELM 29 FT. RT. STA. 19+36 ELEV. 479.00
 B.M. #5 SPIKE IN ROOT 18" ELM 29 FT. LT. STA. 26+79 ELEV. 484.14

SERIES FAS NO 18A
 SHEET 5 OF 8