


PLAN
 BY A.D. Wood
 CHECKED BY A.D. Chubb
 DATE 10/11/38
 SCALE AS SHOWN

PARCEL	INSTRUMENT	DATE	GRANTOR	GRANTEE	RECORDED	REMARKS
BCD	Q.C.D.	9-7-38	MRS BESSIE B MOORE	ST OF VT	SHOREHAM BOOK 21 PAGE 18	DATE 10-30-38

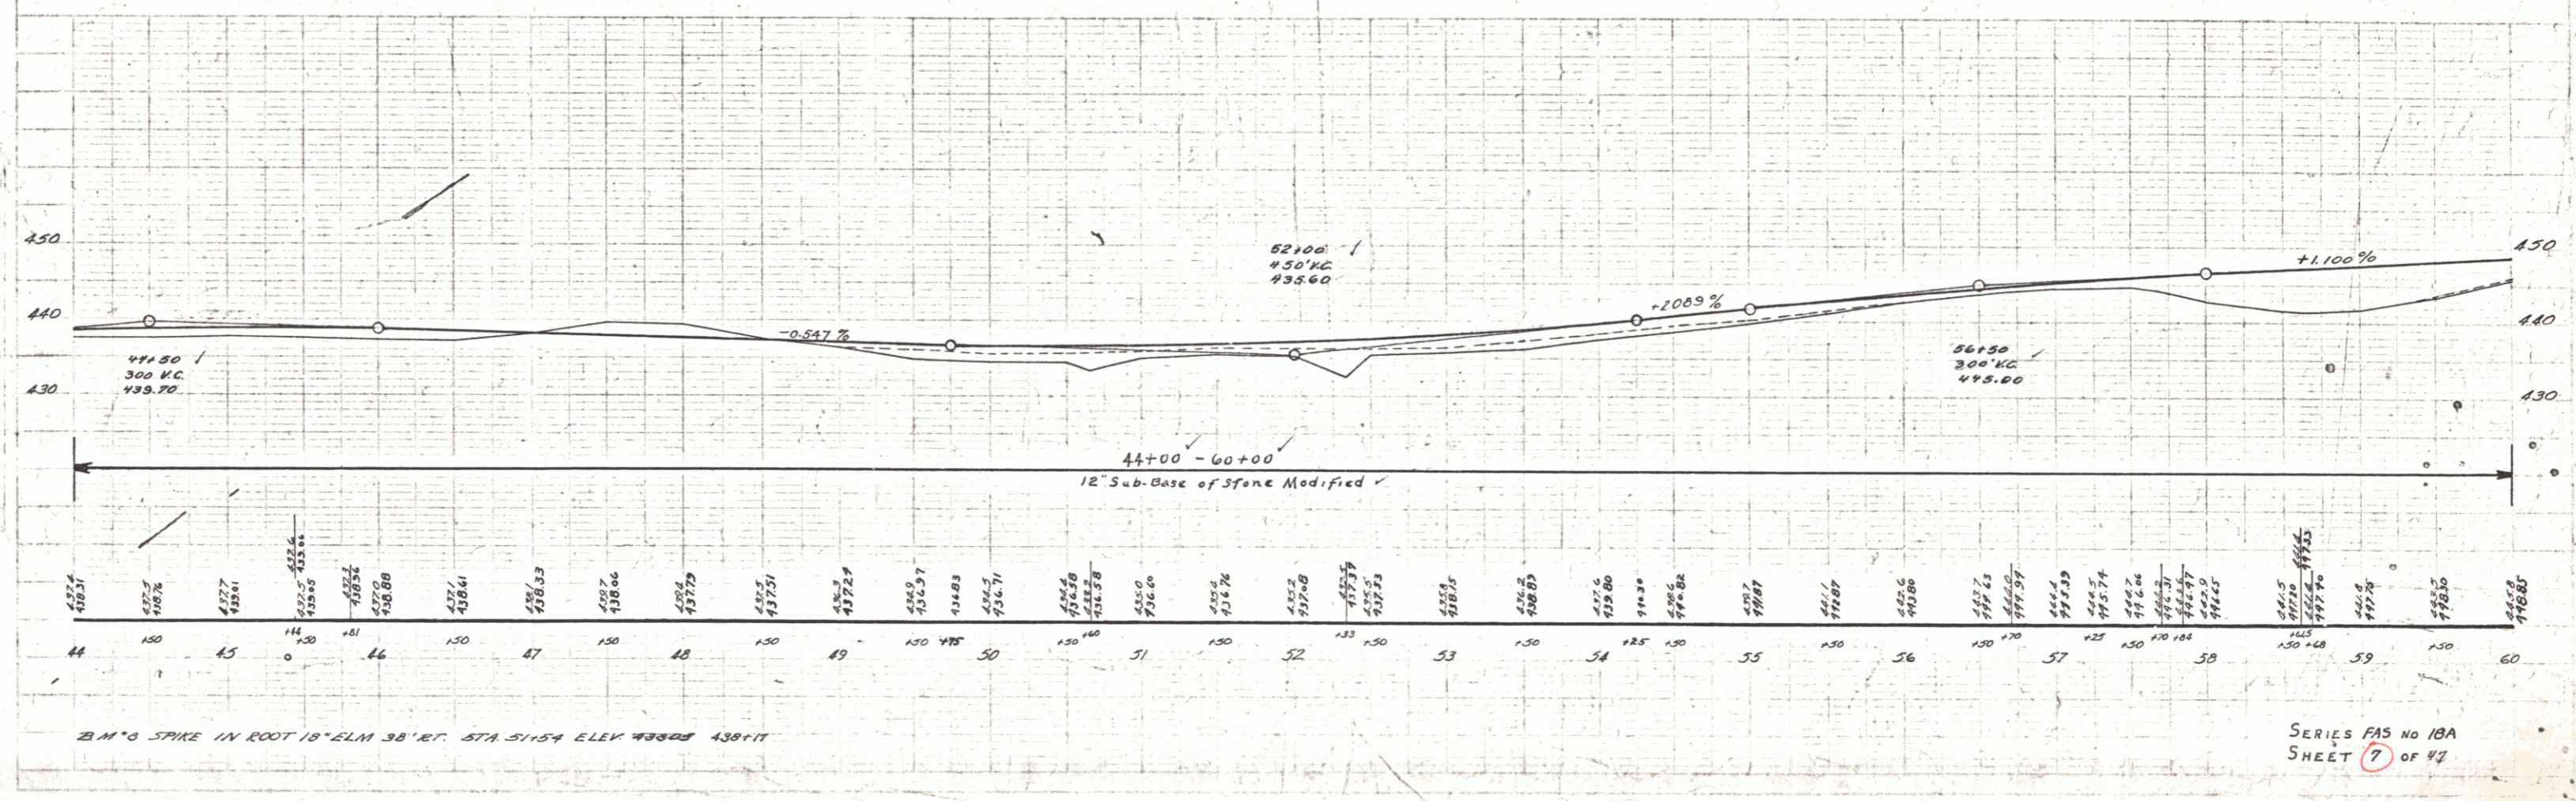

B.M.'S SPIKE IN ROOT 18" ELM 38' RT. STA 51+54 ELEV 438.88