



FED. ROAD DIST. NO.	STATE	FAS PROJ. NO.	FISCAL YEAR	SHEET NO.	TOTAL SHEETS
1	VT	18-A	1939	8	27

A. D. Wood
 R. S. Bailey
 R. J. Bailey

A. D. Wood
 R. S. Bailey
 R. J. Bailey

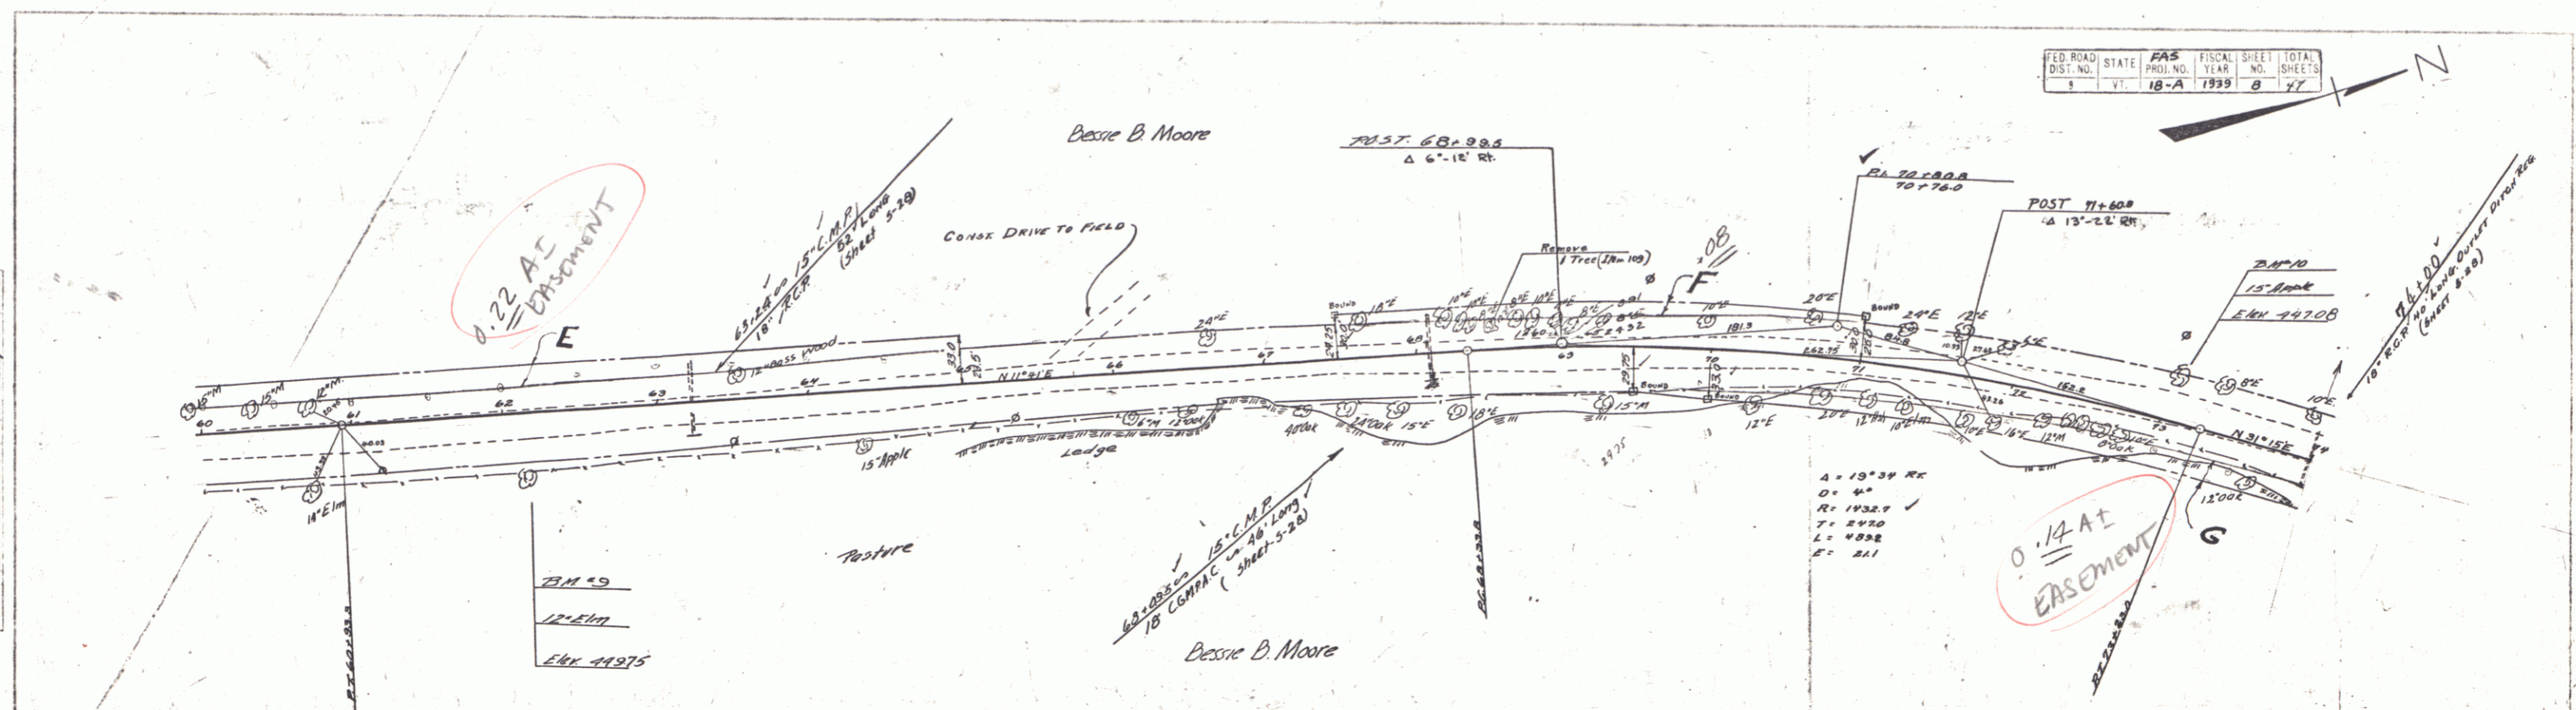

PARCEL	INSTRUMENT	DATE	GRANTOR	GRANTEE	RECORDED	REMARKS
E-F-G	O.C.D.	9-7-38	MRS BESSIE B MOORE	STONY	SHOREHAM BOOK 21 PAGE 182-3536	9-9-38

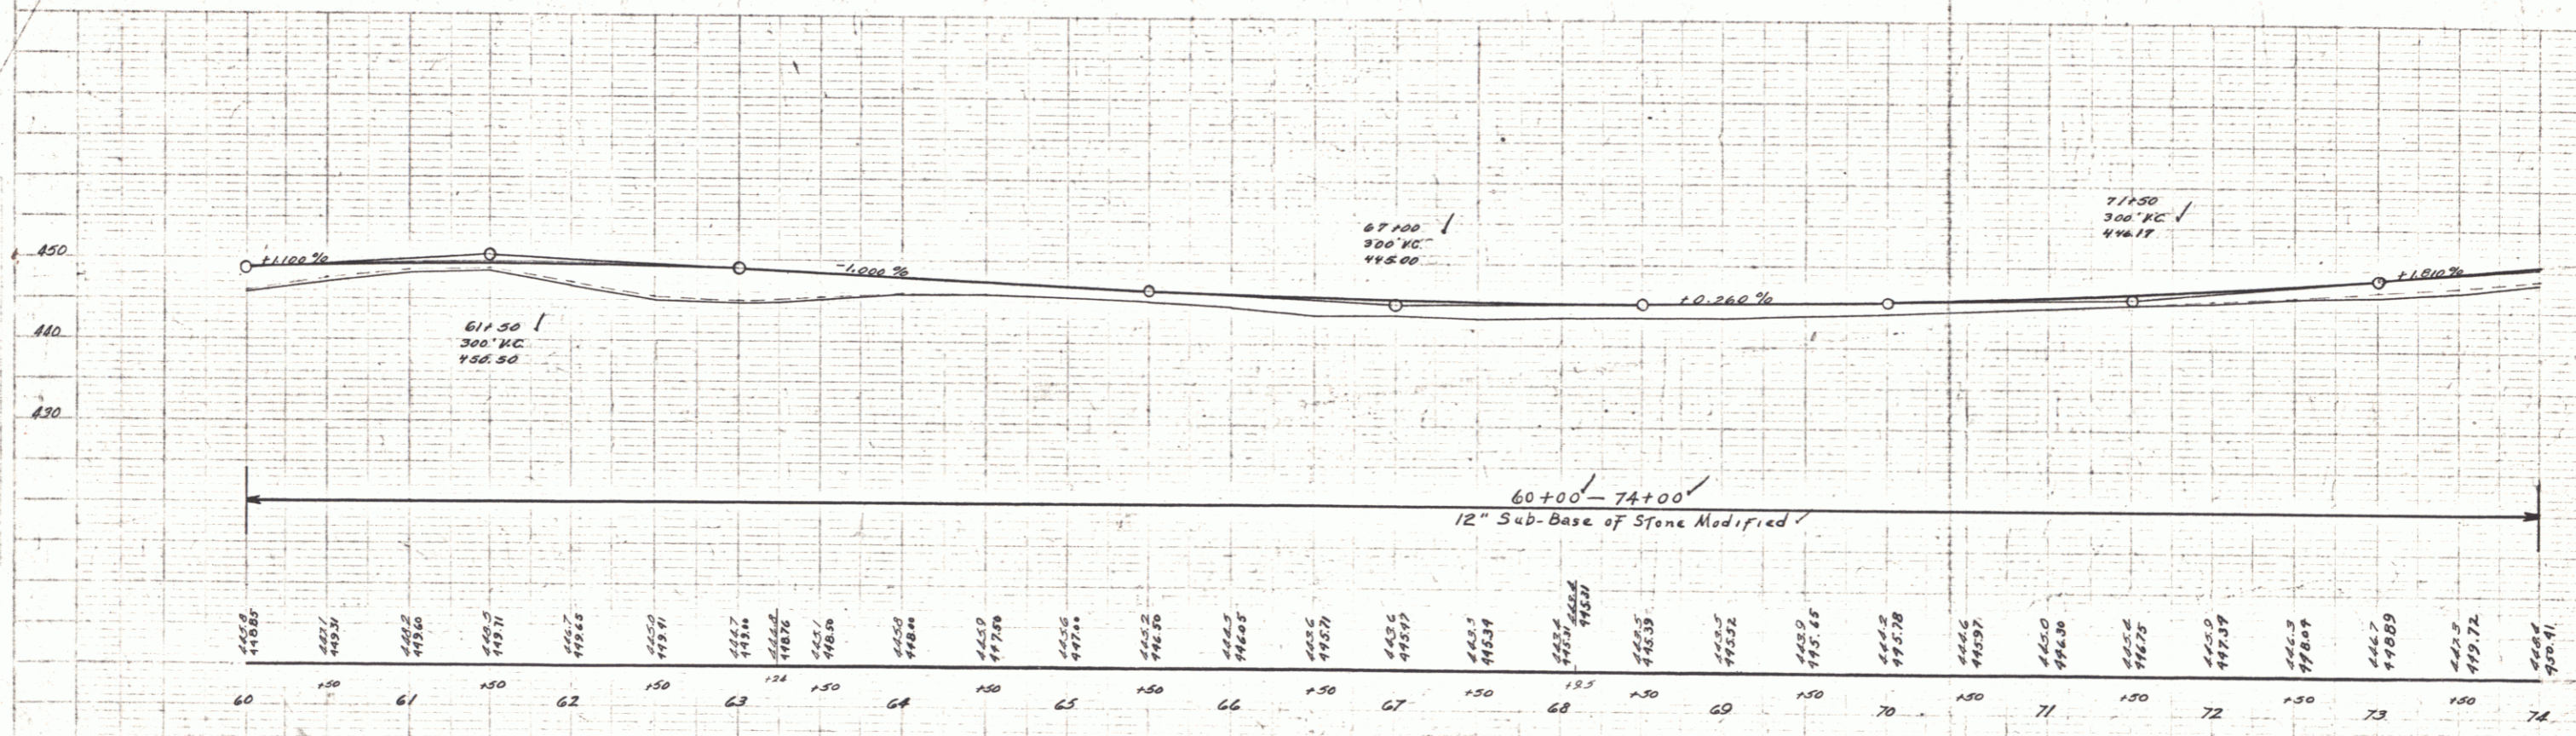

B.M. 19 SPIKE IN ROOT 12" ELM 31' ET. STA 62+14 ELEV 449.75
 B.M. 18 " " " 15" APPLE 24' LT STA 73+02 ELEV 447.08

SERIES FAS NO 18A
 SHEET 8 OF 27