
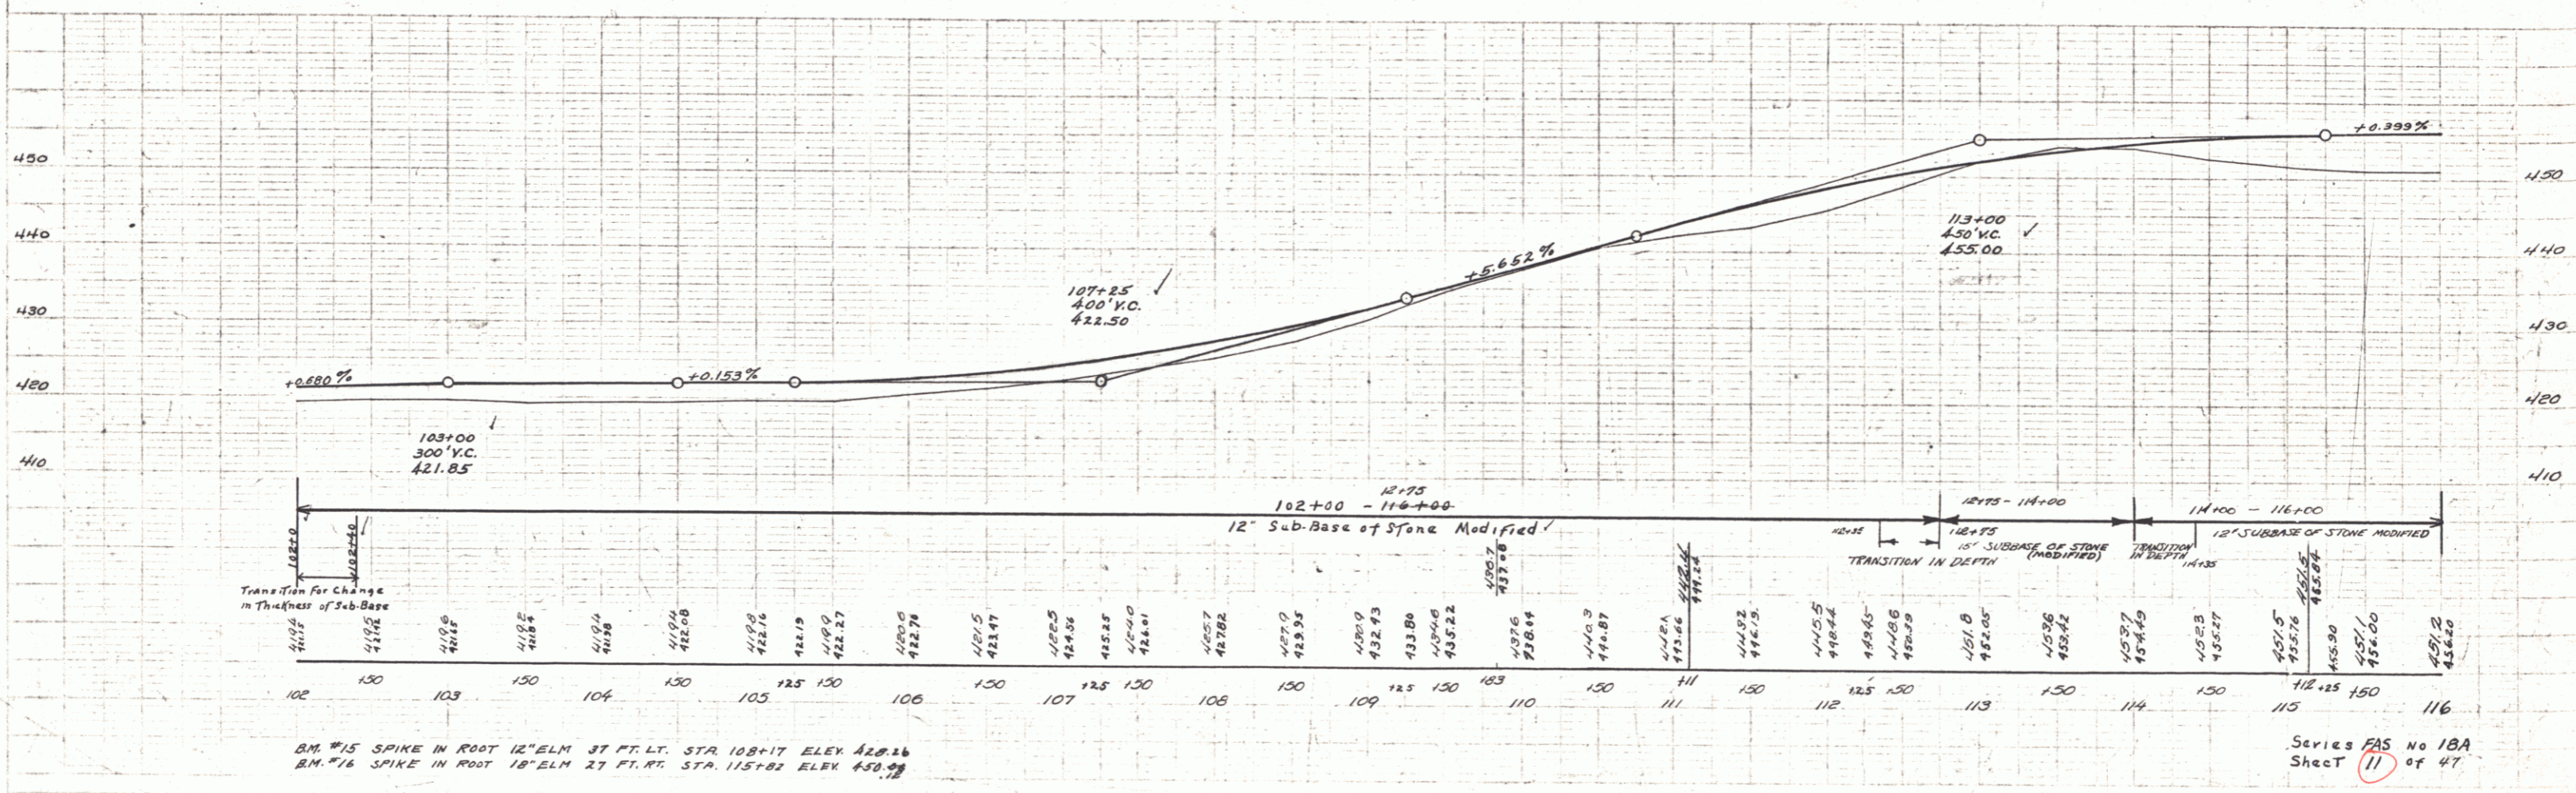


PLAN
 Edith Corwell
 R.V. Carter

VERTICAL
 Edith Corwell
 R.V. Carter

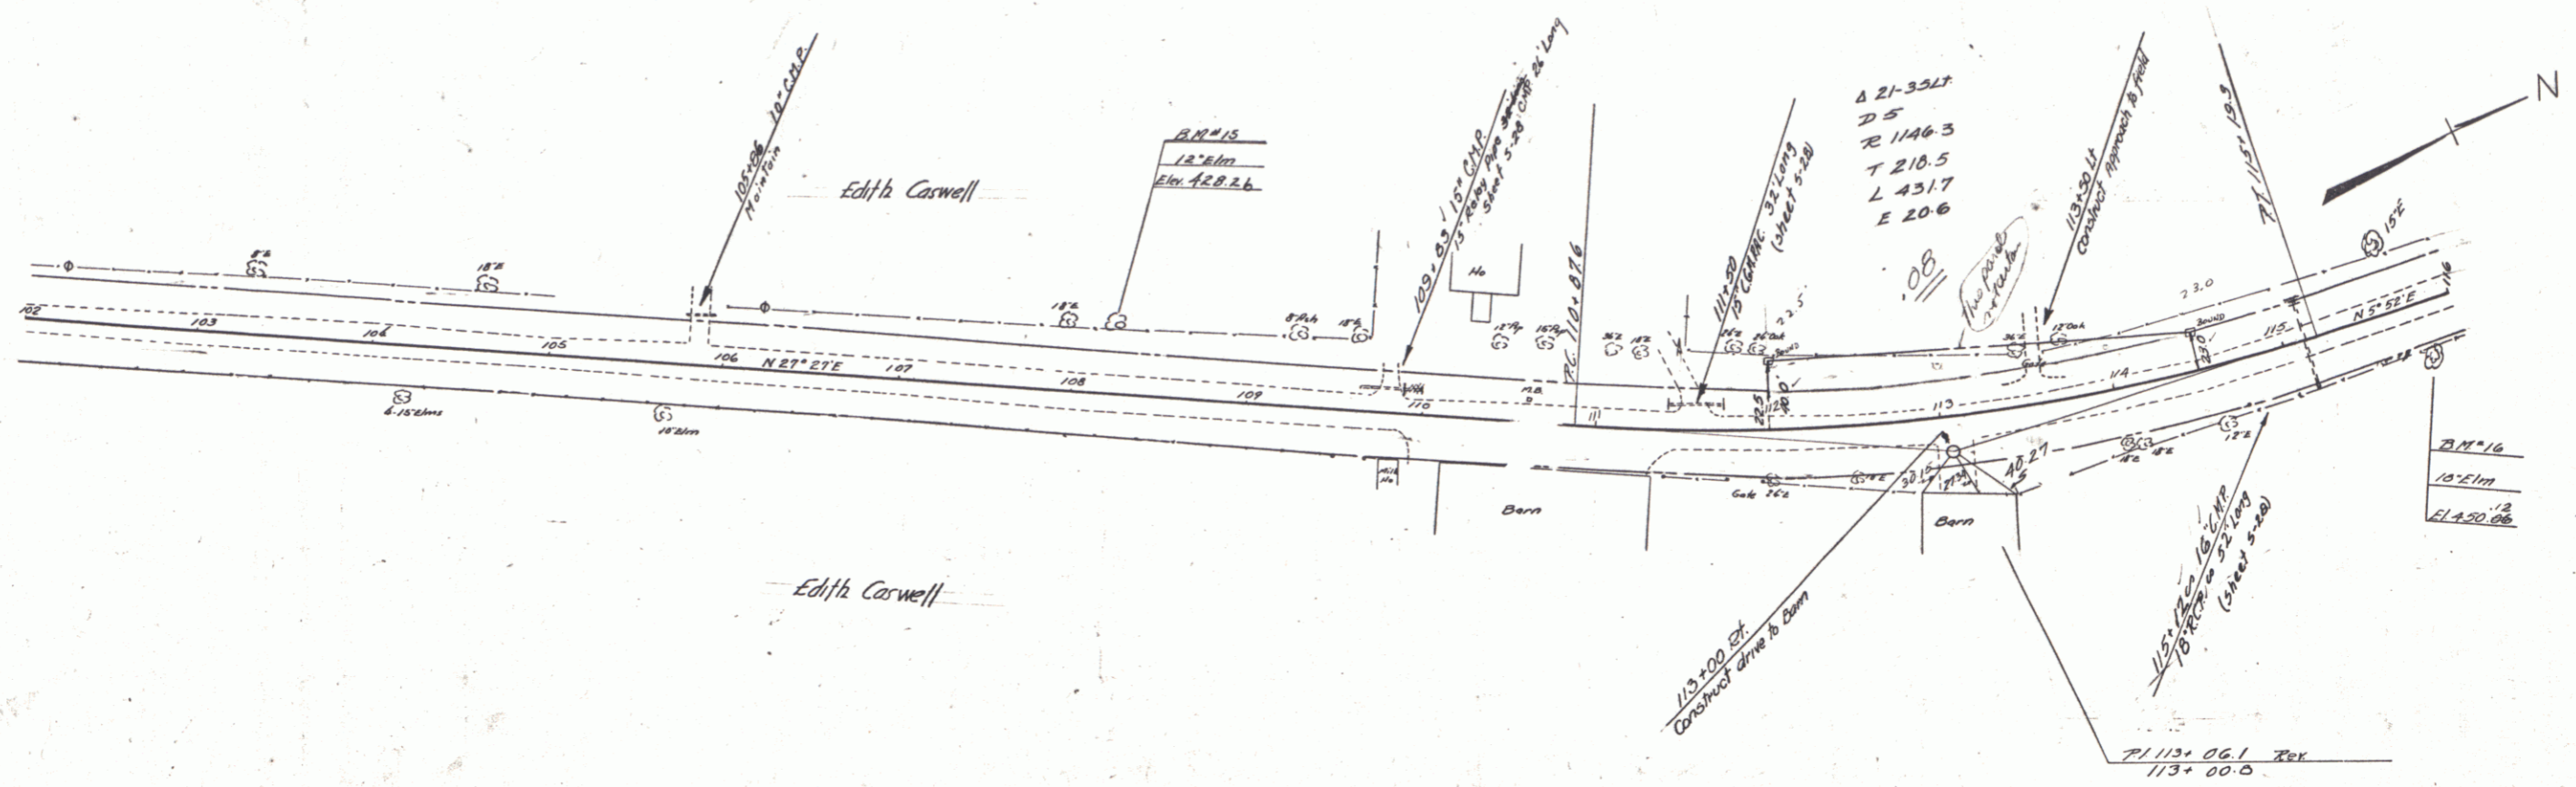

BM #15 SPIKE IN ROOT 12" ELM 37 FT. LT. STA 108+17 ELEV 420.26
 BM #16 SPIKE IN ROOT 18" ELM 27 FT. RT. STA 115+82 ELEV 430.77

Series FAS No 18A
 Sheet 11 of 47