

INDEX OF SHEETS

SHEET NO.	TITLE PAGE
1	TITLE PAGE
2	TYPICAL CROSS-SECTION OF IMPROVEMENT <i>2 1/4" CURVED STONE MIXED-IN-PLACE SURF COURSE WITH CUTBACK ASPHALT & PHONE COAT OF REF. TRK. TRANS 21,30,31.</i>
3	BANKING AND WIDENING TABLES
4-17	PLAN AND PROFILE STA.
18	STANDARD STRUCTURE SHEET, 5-20, PIPE CULVERTS
19	" " " " 5-30, GUARD RAIL
20	" " " " 5-30A, BOUND. MARKS, F.A. MARKS, & STD. UNIFORM
21	" " " " 5-C-2-4, BOX CULVERTS
22	" " " " 5-CW-2-3
23	" " " " 3-10, BARRICADES, SIGNS & LIGHTS
24	" " " " 3-4, ROUNDING OF SLOPES
25	DETAILS OF 10'x6' CONCRETE BOX CULVERTS
26-41	CROSS SECTION SHEETS


STANDARD STRUCTURE SHEET S 28 APPROVED BY THE CHIEF ENGINEER ON JULY 11, 1933; S 30 AUGUST 15, 1933

STATE OF VERMONT
STATE HIGHWAY DEPARTMENT
PLAN AND PROFILE OF PROPOSED
STATE HIGHWAY
 FEDERAL AID SECONDARY PROJECT


TOWNS OF SHOREHAM-BRIDPORT
 ADDISON - ORWELL ROAD

BEGINNING AT A POINT 1747 FEET SOUTH OF THE SHOREHAM-BRIDPORT TOWN LINE AND EXTENDING NORTHERLY 3.405 MILES TO A POINT 791 FEET SOUTH OF ROUTE F-8
 LENGTH OF PROJECT = 17982.1 FT = 3.405 MI.

FED. ROAD DIST. NO.	STATE	F.A.S. PROJ. NO.	FISCAL YEAR	SHEET NO.	TOTAL SHEETS
9	VT.	18-B(1)	1938	1	67

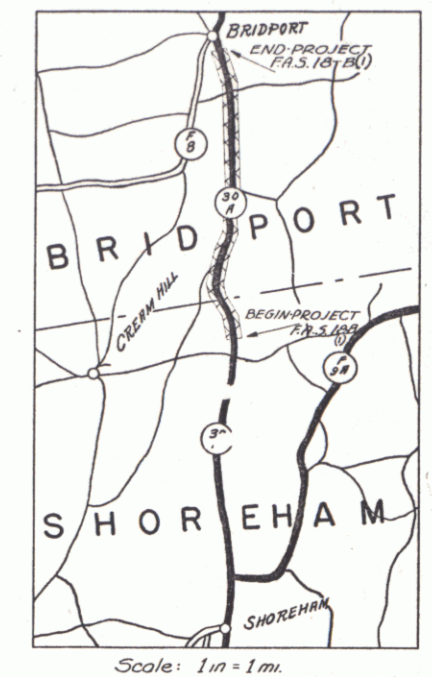

Route: VT 22A
 Project: FAS 18-B(1)
 Date: 07/21/1938
 Plan: OOR568

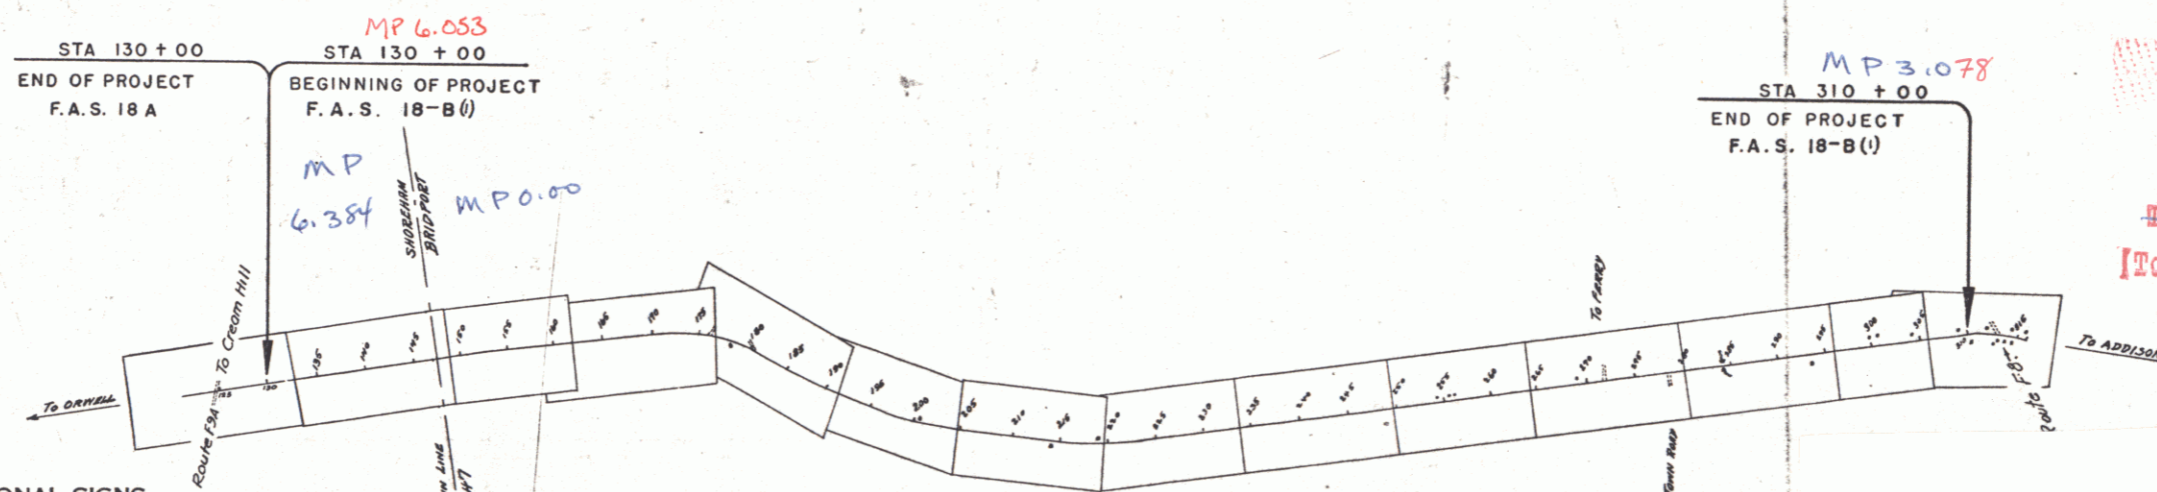

RIGHT-OF-WAY DIVISION
TOWN FILE
 PERPETUAL
 Town of VT 22A
 [To Be Returned To R.O.W. Division]

APPROVED: July 15, 1938
H. Stugardt
 COMMISSIONER OF HIGHWAYS

CONVENTIONAL SIGNS

COUNTY LINE	-----
TOWN LINE	-----
FENCE LINE	-----
STONE WALL	-----
UNFENCED PROPERTY	-----
GUARD RAIL	-----
TRAVELED WAY	-----
RAILROAD	-----
RETAINING WALL	-----
CENTER LINE	-----
SURVEY LINE	-----
CULVERT	-----
DROP INLET	-----
TROLLEY POLE	-----
POWER POLE	-----
TELEPHONE POLE	-----
TREES	-----
HEDGE	-----

CURVE DATA

DEFLECTION ANGLE Δ
DEGREE OF CURVE D
RADIUS OF CURVE R
TANGENT DISTANCE T
LENGTH OF CURVE L
EXTERNAL DISTANCE E
POINT OF INTERSECTION P. I.
POINT OF CURVE P. C.
POINT OF TANGENT P. T.
POINT ON TANGENT P. O. T.

SCALES

Title	1" = 1000'
Typical	1" = 2'
Plan	1" = 30'
Profile	Hor. 1" = 50'
	Ver. 1" = 10'
Cross Sections	1" = 5'

These plans are subject to such revisions as may be required by the Public Roads Administration or Commissioner of Highways. Construction is to be carried on in accordance with the plans & the Standard Road & Bridge Specifications of 1936 as approved Dec. 29, 1936 by the Public Roads Administration including all subsequent approved revisions & such revised specifications & special provisions as are submitted with the plans.

CORRECT: July 21, 1938
 ROAD ENGINEER
 APPROVED: July 21, 1938
 DISTRICT HIGHWAY COMMISSIONER

SERIES FAS NO. 18-B FILED
 SHEET 1 OF 67