
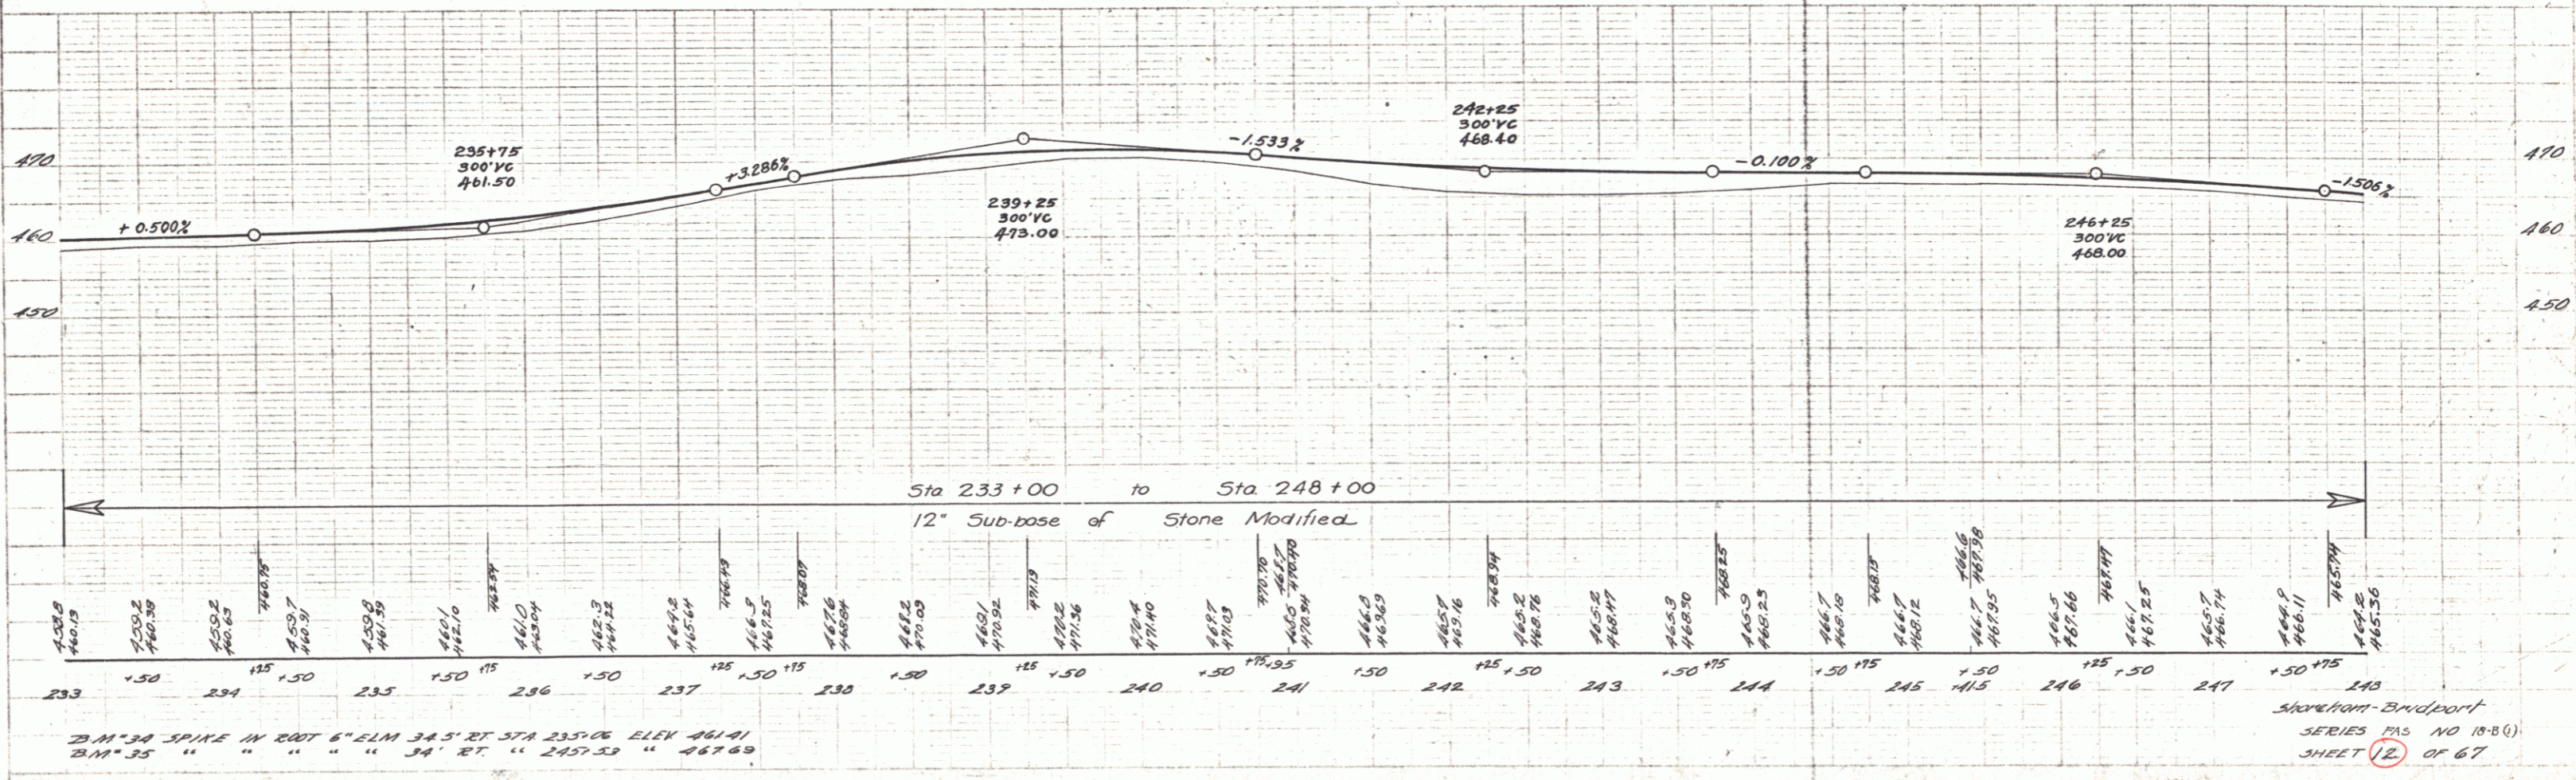


PLAN
 DRAWN BY
 CHECKED BY
 DATE
 TOWN

PROFILE
 DRAWN BY
 CHECKED BY
 DATE
 TOWN

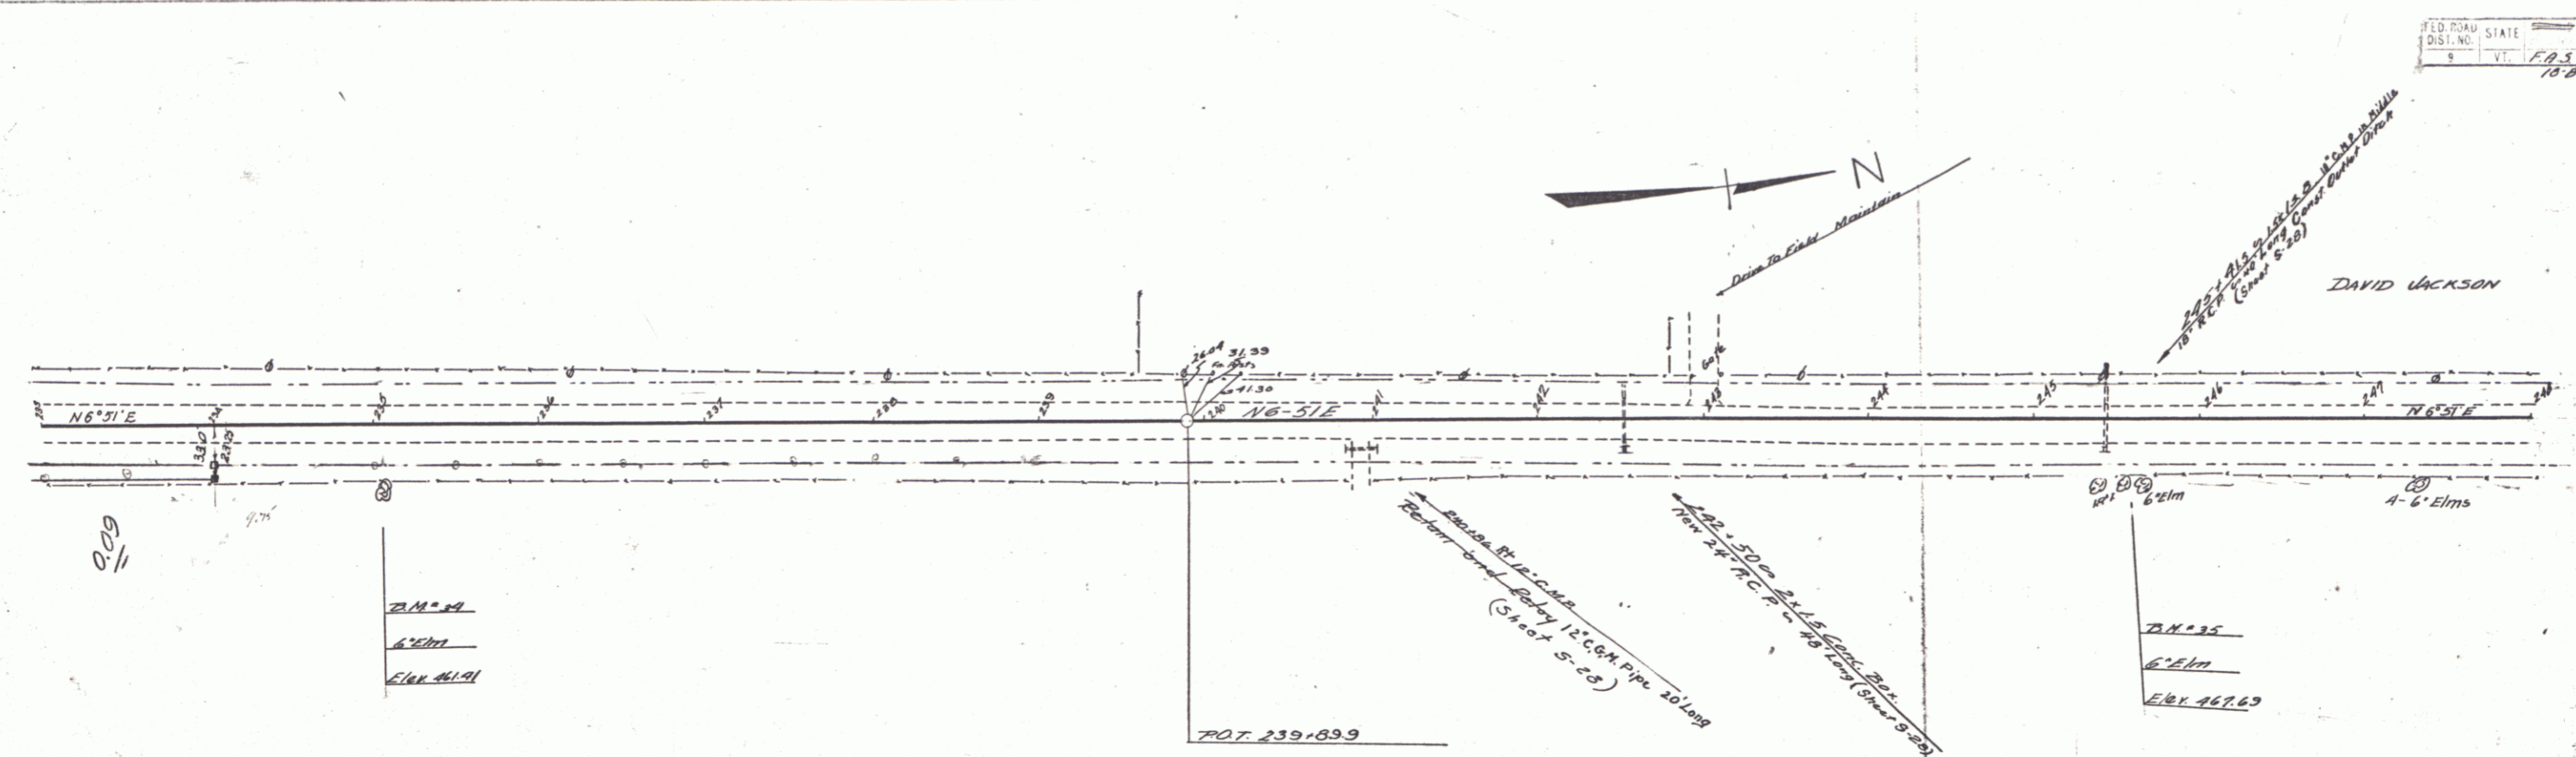

20" M³⁴ SPIKE IN ROOT 6" ELM 34.5' RT STA 235+06 ELEV 461.41
 20" M³⁵ " " " " 34' RT " 245+53 " 467.63

SHREVEPORT-BANDPORT
 SERIES 105 NO 10-B(1)
 SHEET 12 OF 67