
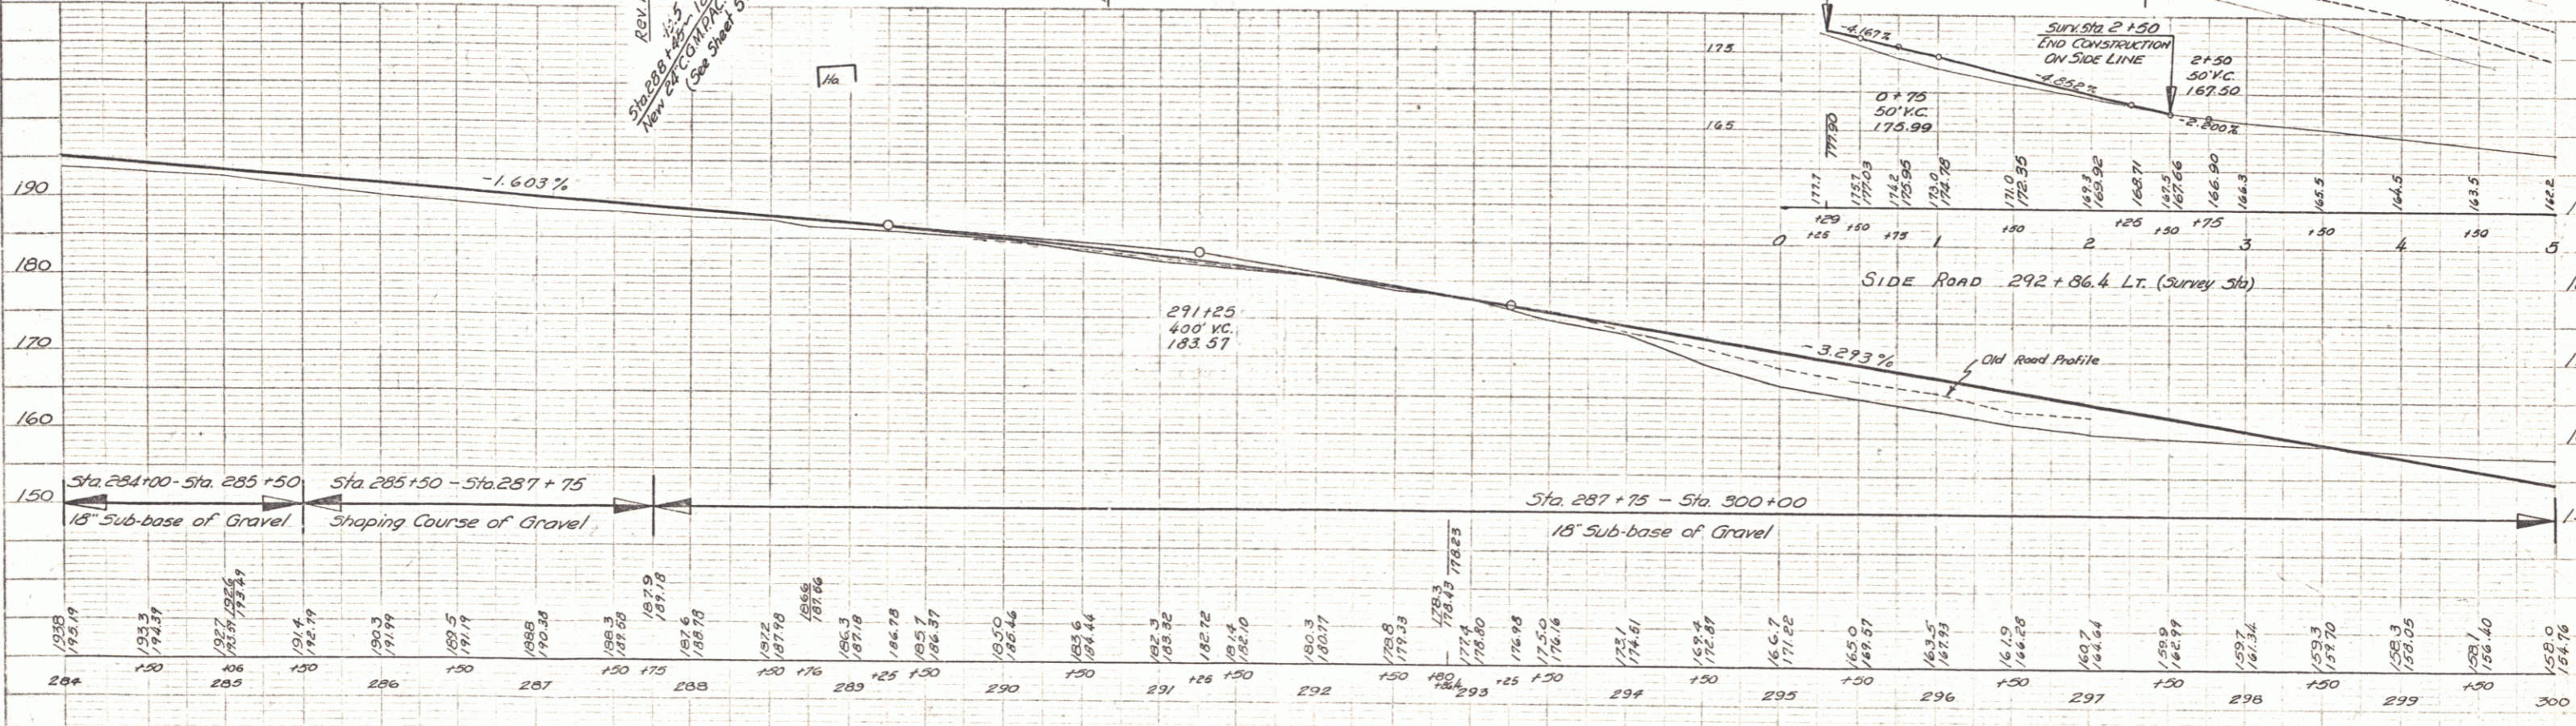


PARCEL	INSTRUMENT	DATE	GRANTOR	GRANTEE	RECORDED BOOK PAGE DATE	REMARKS
JA	W.D.O.E.	10-1-46	LERDY BENSON	ST. OF VT.	20 617-618 10-18-46	
JA'	W.D.O.E.	10-1-46	PHILIAS QUENNEVILLE	" " "	20 620-621 10-18-46	

DIST. NO. STATE PROJ. NO. YEAR No. SHEETS
 5 VT. 518(3) 1946 7 117

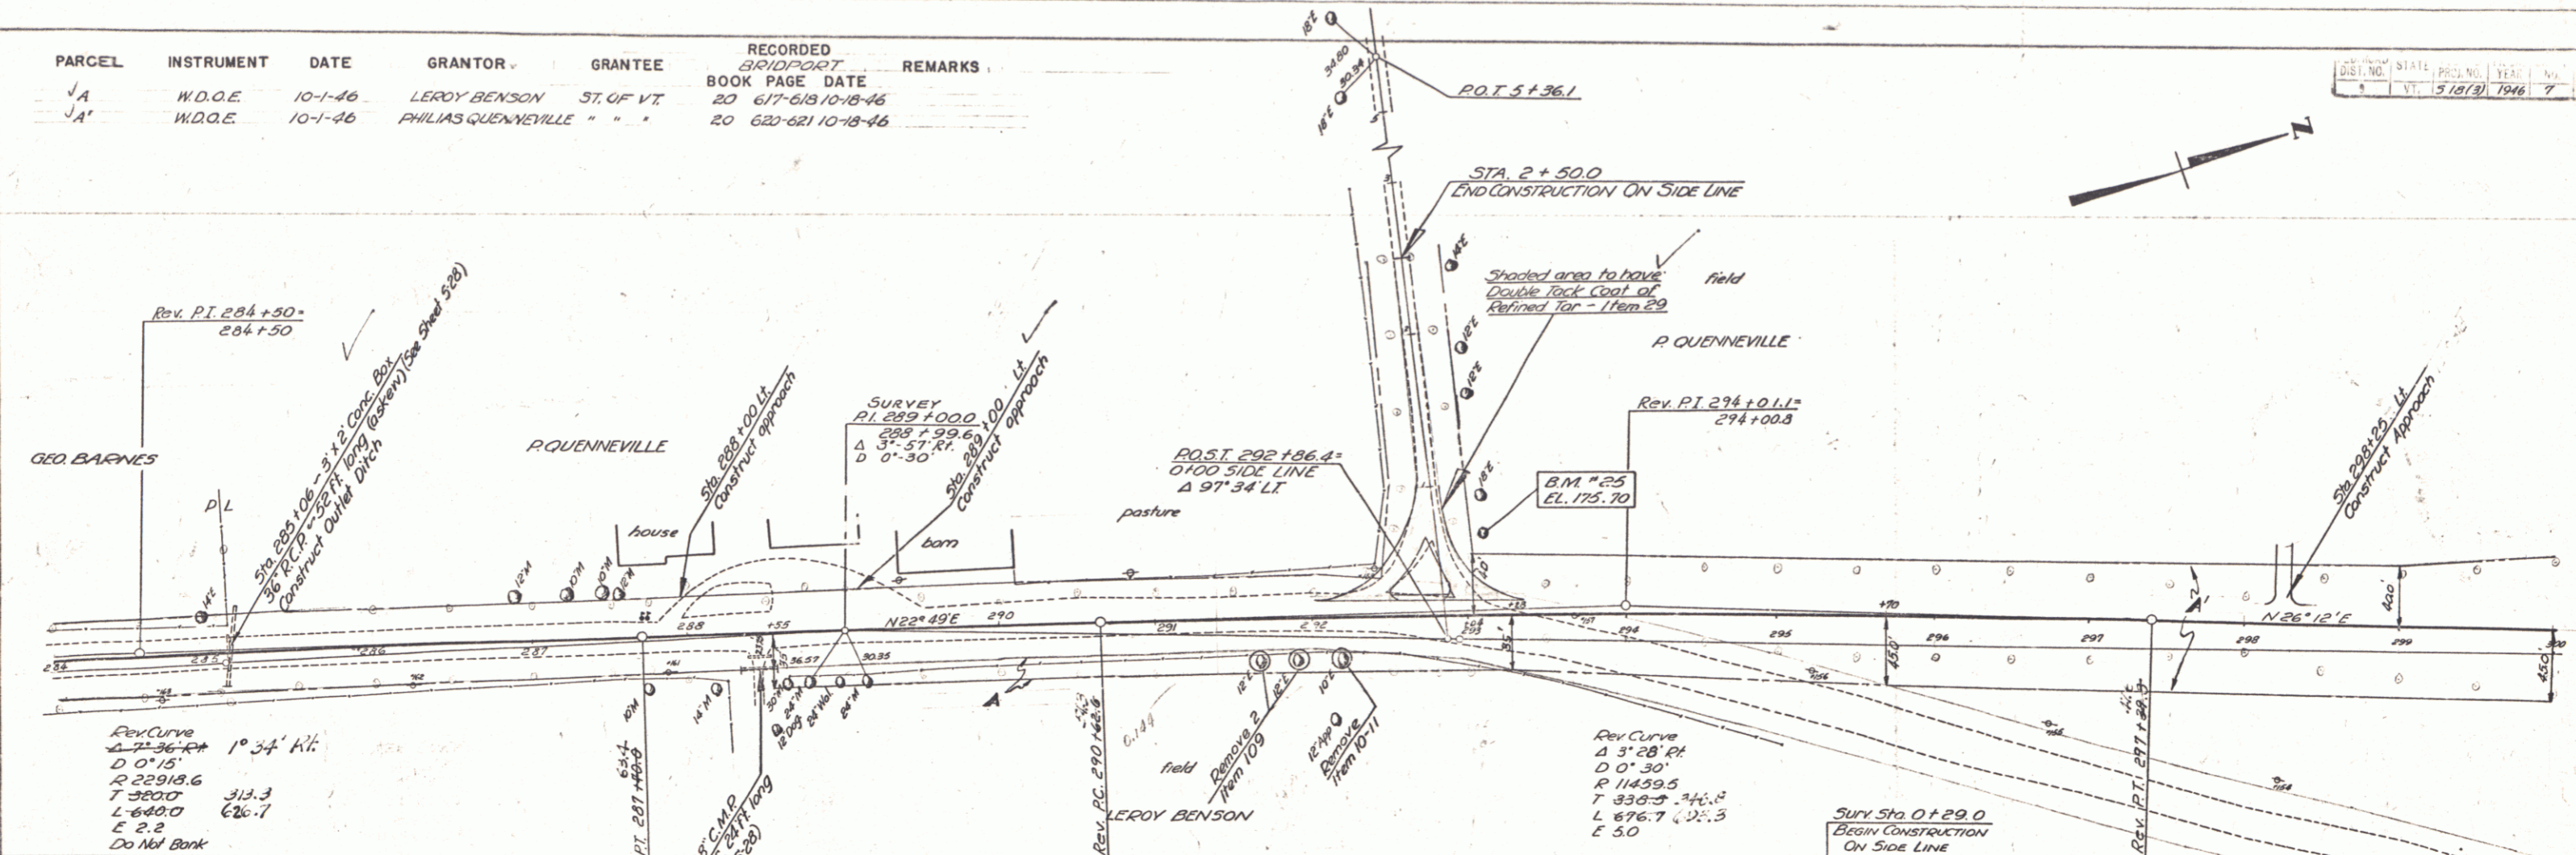

BM # 25 EL 175.70 SIR 18' Elm 65 ft LT Sta 293+07

Bridgeport - Addison
 series 5 no 18(3)
 sheet 7 of 117 sheets

PLAN
 DRAWN BY: [Signature]
 CHECKED BY: [Signature]
 DATE: 10-1-46

PROFILE
 DRAWN BY: [Signature]
 CHECKED BY: [Signature]
 DATE: 10-1-46

PLATE IN FULL-ENGINEERING
 SCALE 1"=40'