
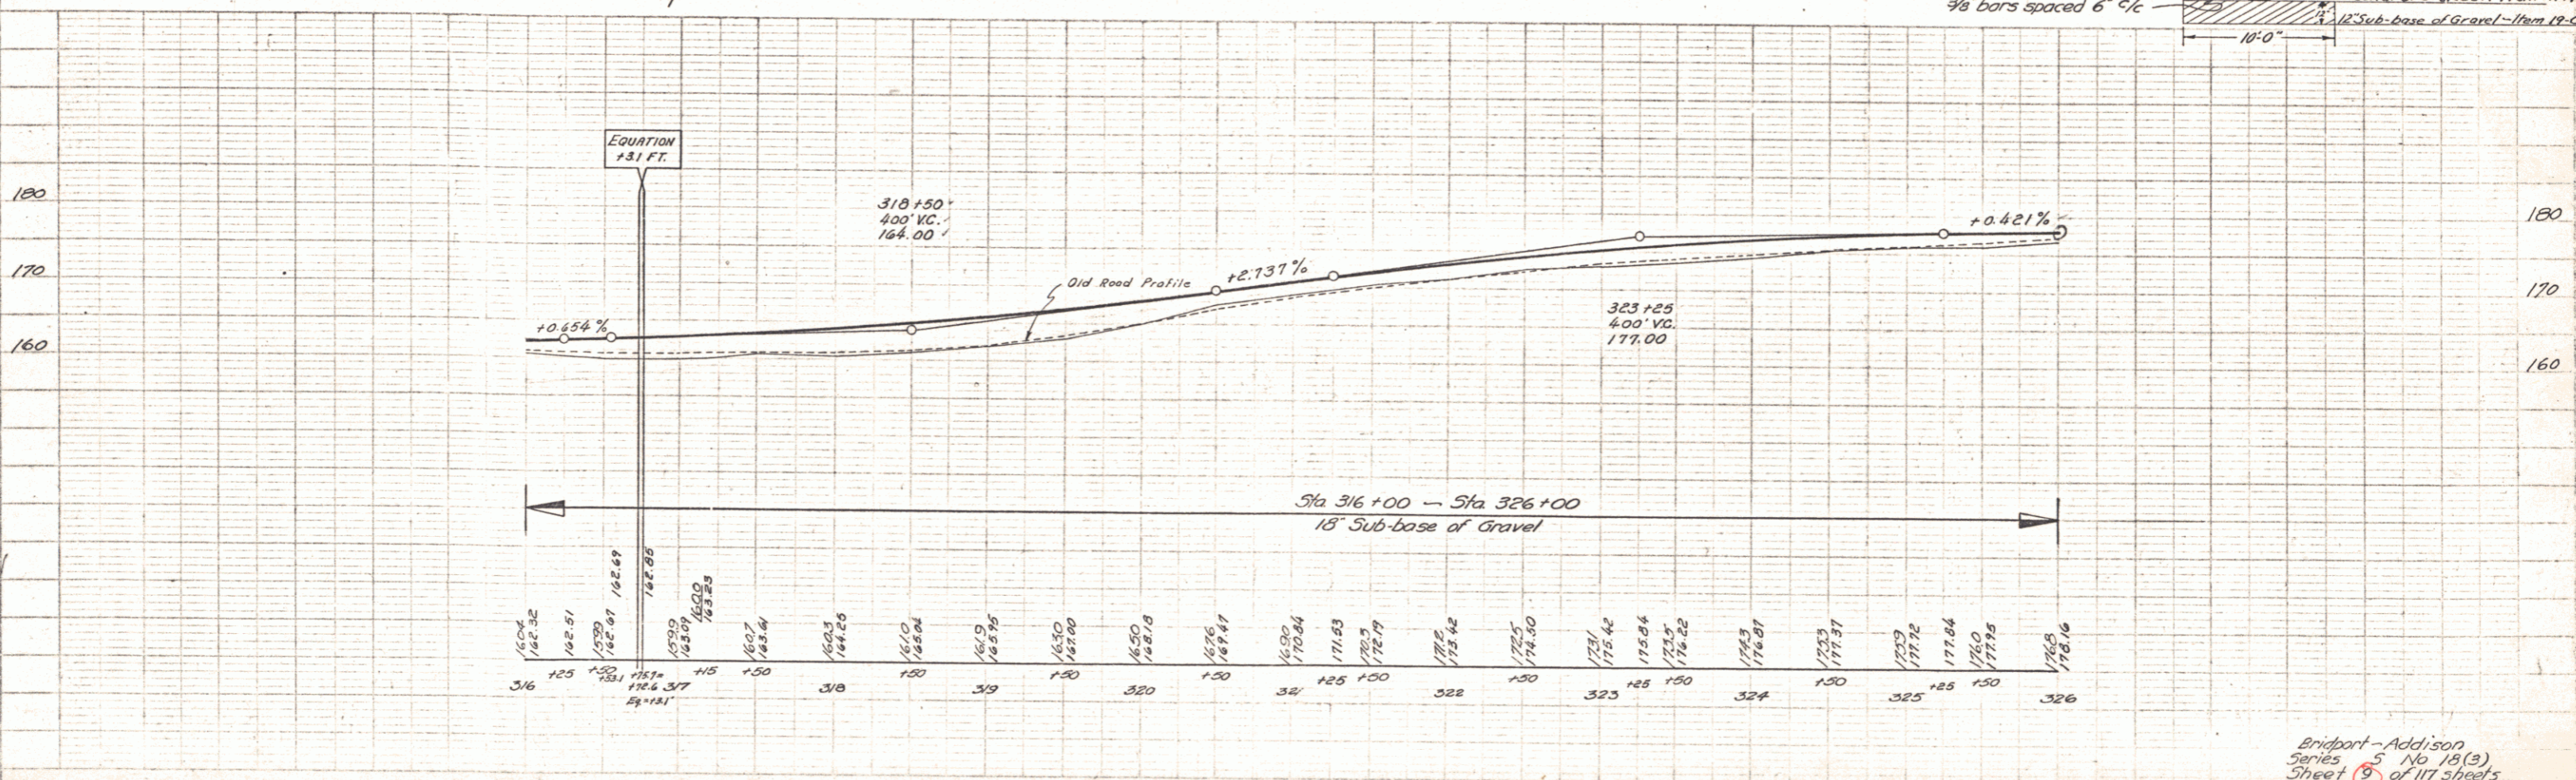


PARCEL	INSTRUMENT	DATE	GRANTOR	GRANTEE	RECORDED	REMARKS
					BOOK	PAGE
A,B,C	W.D.G.E.	10-10-46	W.A. RIVERS	ST. OF VT.	20	624-625
					DATE	10-18-46

FED. ROAD DIST. NO.	STATE	PROJ. NO.	FISCAL YEAR	SHEET NO.	TOTAL SHEETS
5	VT.	18(3)	1946	9	117

PLAN  
 NOTE: SEE ALTIMETER RECORD FOR  
 ELEVATIONS  
 12.16

PROFILE  
 NOTE: SEE ALTIMETER RECORD FOR  
 ELEVATIONS  
 12.16

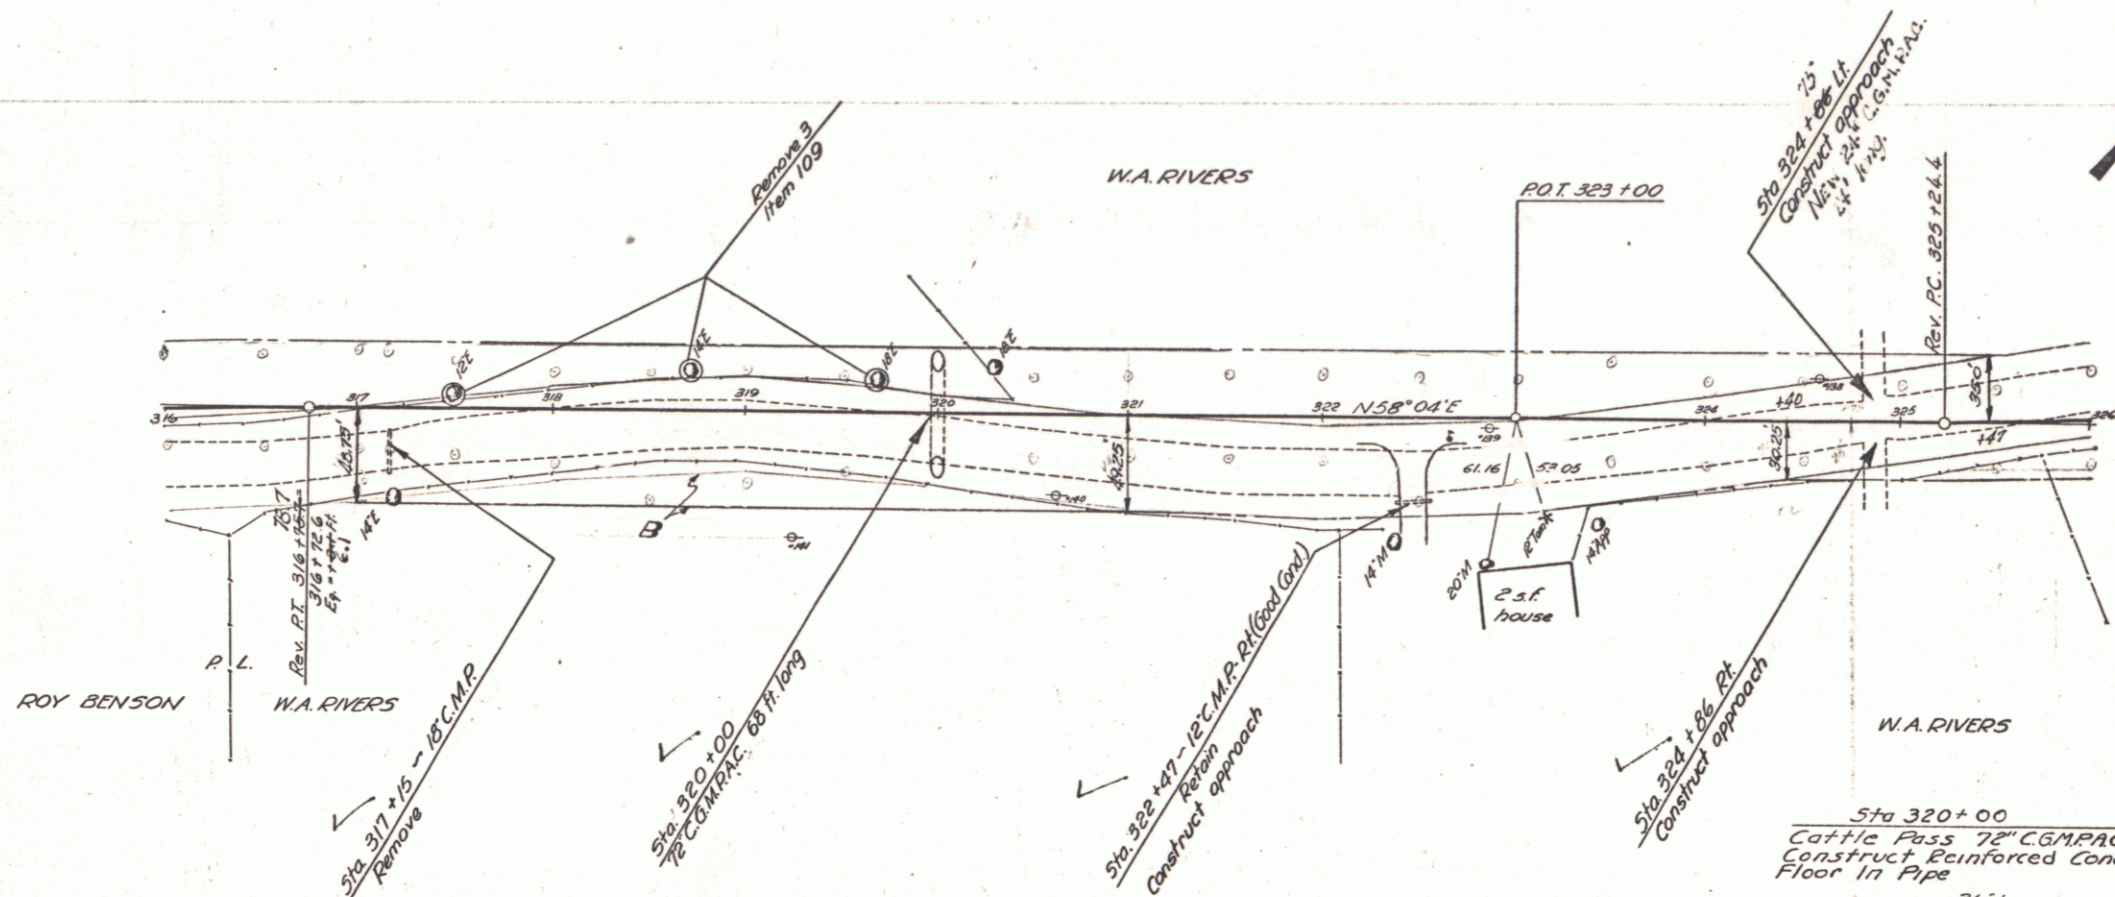

Bridport-Addison  
 Series 5 No 18(3)  
 Sheet 9 of 117 sheets