



PLAN
 SCALE: HORIZ. 1" = 40' VERT. 1" = 10'
 DATE: 10-10-46
 DRAWN BY: [Name]
 CHECKED BY: [Name]

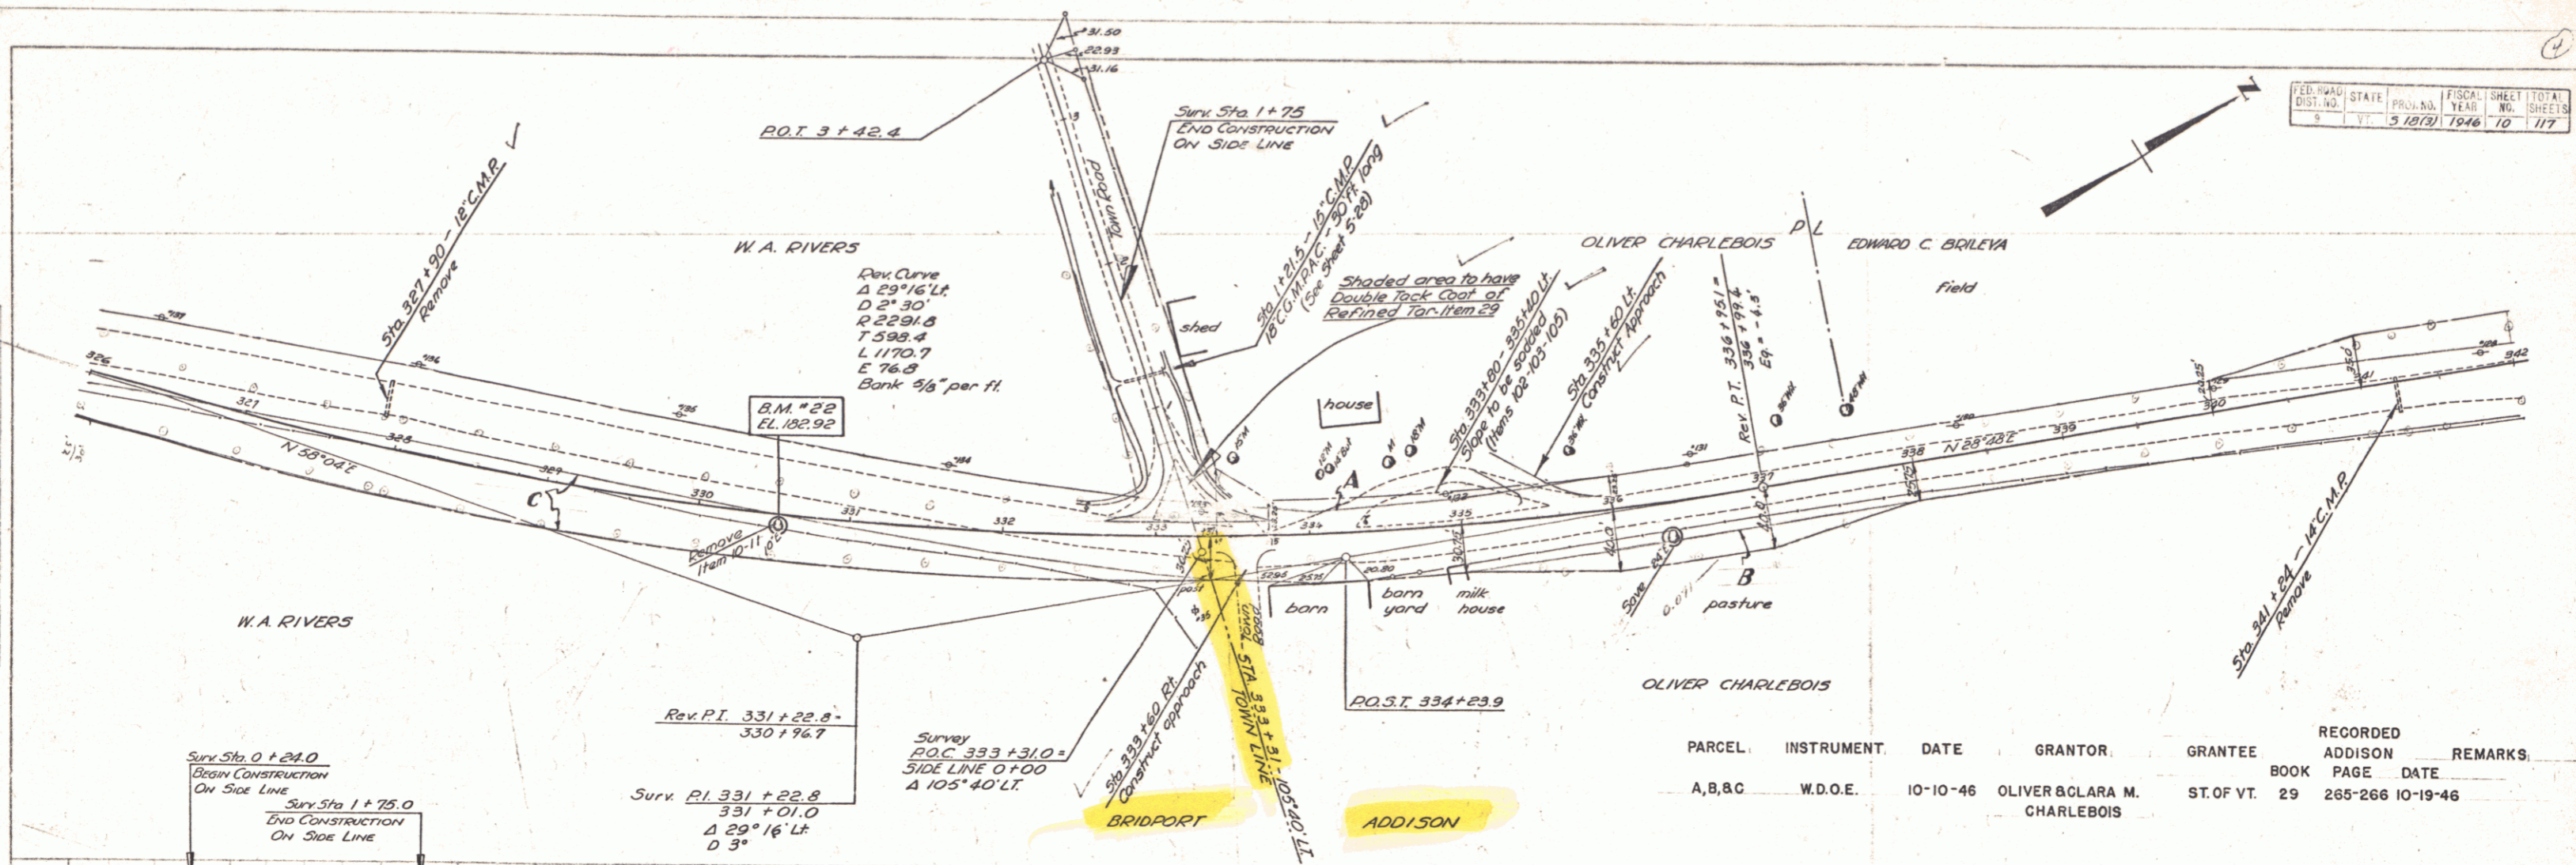

PARCEL	INSTRUMENT	DATE	GRANTOR	GRANTEE	RECORDED ADDITION BOOK	RECORDED ADDITION PAGE	RECORDED ADDITION DATE	REMARKS
A, B, & C	W.D.O.E.	10-10-46	OLIVER & CLARA M. CHARLEBOIS	ST. OF VT.	29	265-266	10-19-46	

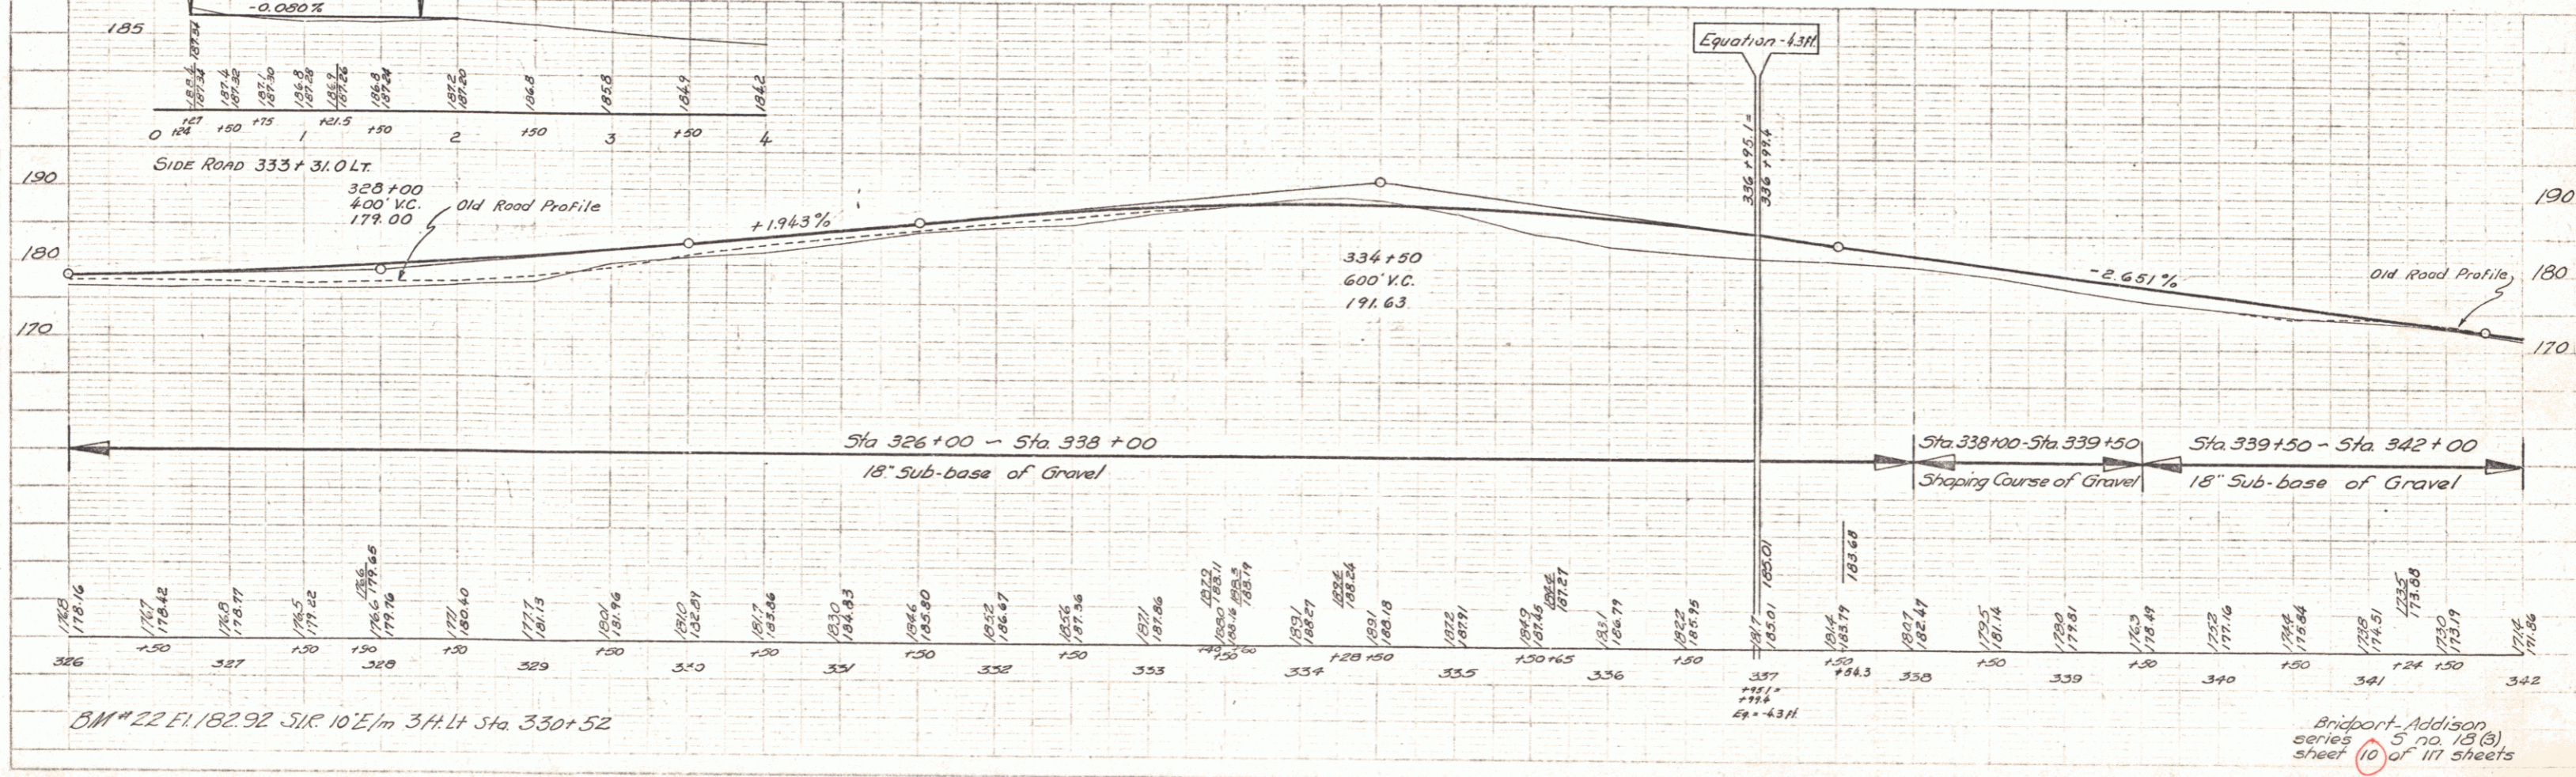

B.M. # 22 E.L. 182.92 Sta. 10.12 m 3 ft. Lt Sta. 330+52

Bridport-Addison series 5 no. 13 (3) sheet 10 of 117 sheets