


PARCEL INSTRUMENT DATE GRANTOR GRANTEE RECORDED ADDISON REMARKS
 B W.D.O.E. 10-1-46 EDWARD C. & ALTA A. TOWN OF ADDISON 29 240-241 10-19-46
 BRILEYA

FED. ROAD DIST. NO.	STATE	PROJ. NO.	FISCAL YEAR	SHEET NO.	TOTAL SHEETS
9	VT	5 1073	1946	11	177

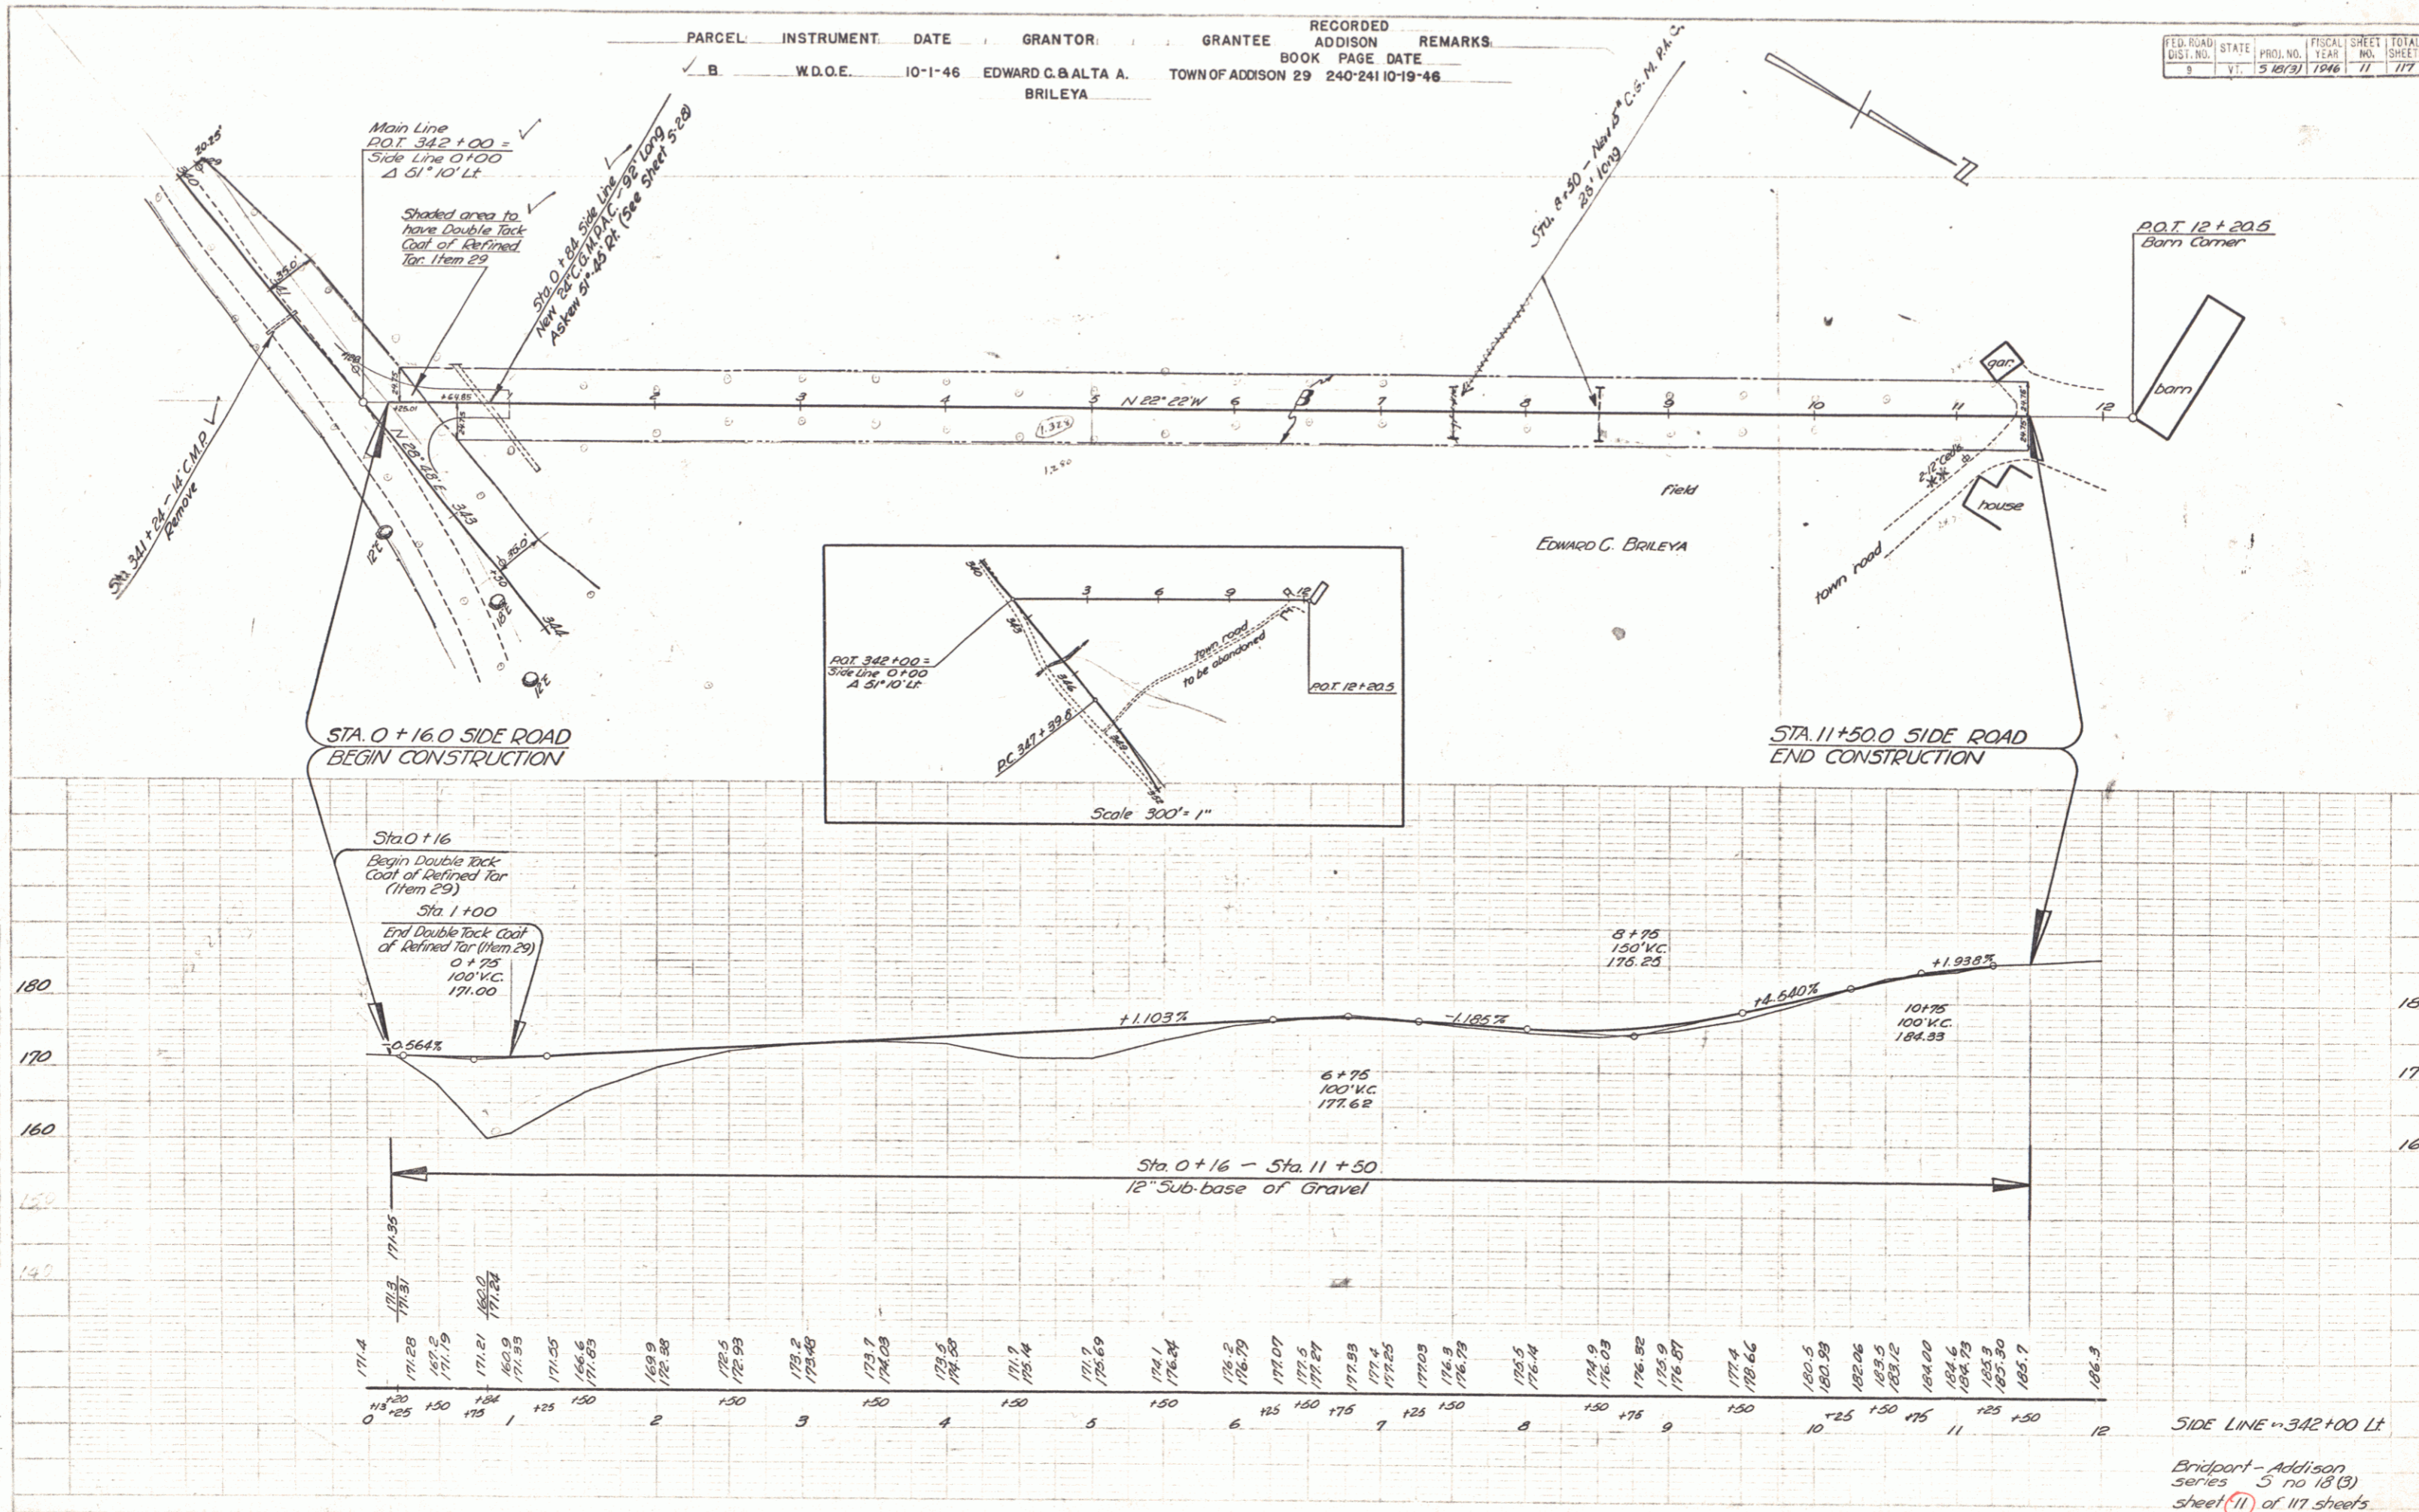

Bridport - Addison series 5 no 18 (B) sheet 11 of 117 sheets