



PARCEL	INSTRUMENT	DATE	GRANTOR	GRANTEE	RECORDED BRIDPORT	REMARKS
A1	W.D.O.E.	10-18-46	WADE A. WALKER	ST. OF VT.	20 615-616	10-18-46
A2	W.D.O.E.	11-21-46	L.R. & HAZEL B. PAYNE	" " "	20 625-629	11-23-46

5 18(3) 1946 4 117

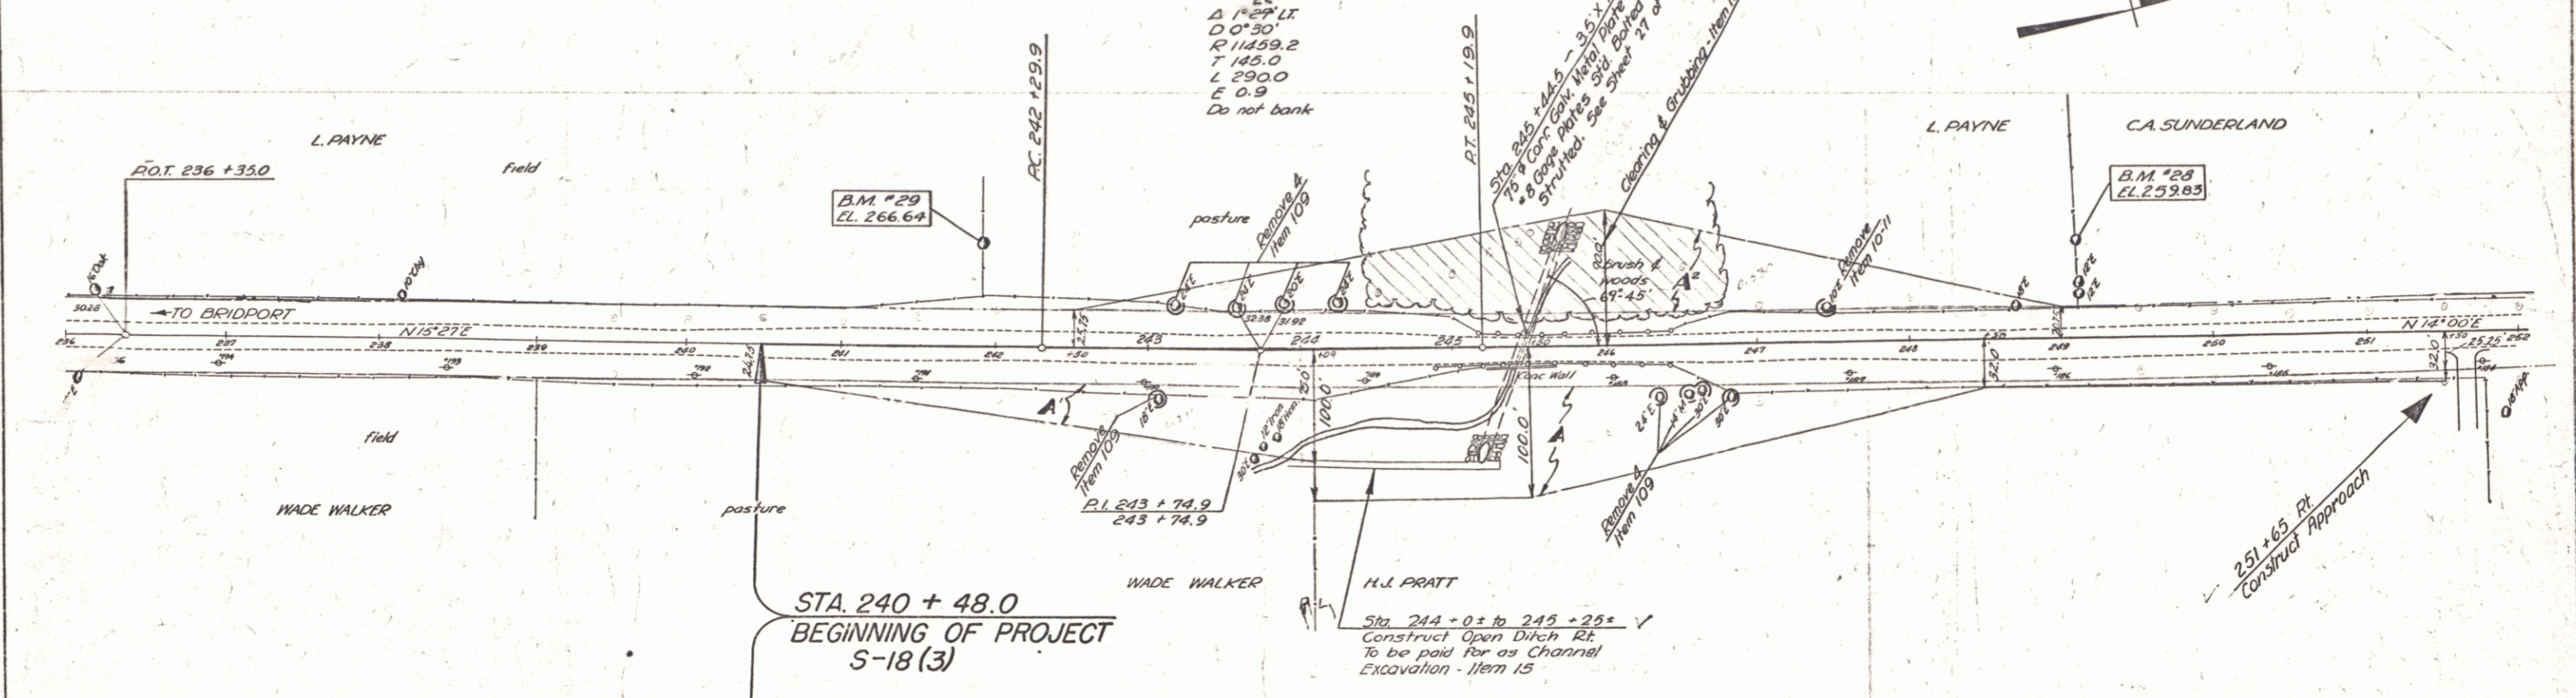

STA. 240 + 48.0
BEGINNING OF PROJECT
5-18(3)

H.J. PRATT
Sta 244 + 0 ± to 245 + 25 ±
Construct Open Ditch. Etc.
To be paid for as Channel
Excavation - Item 15

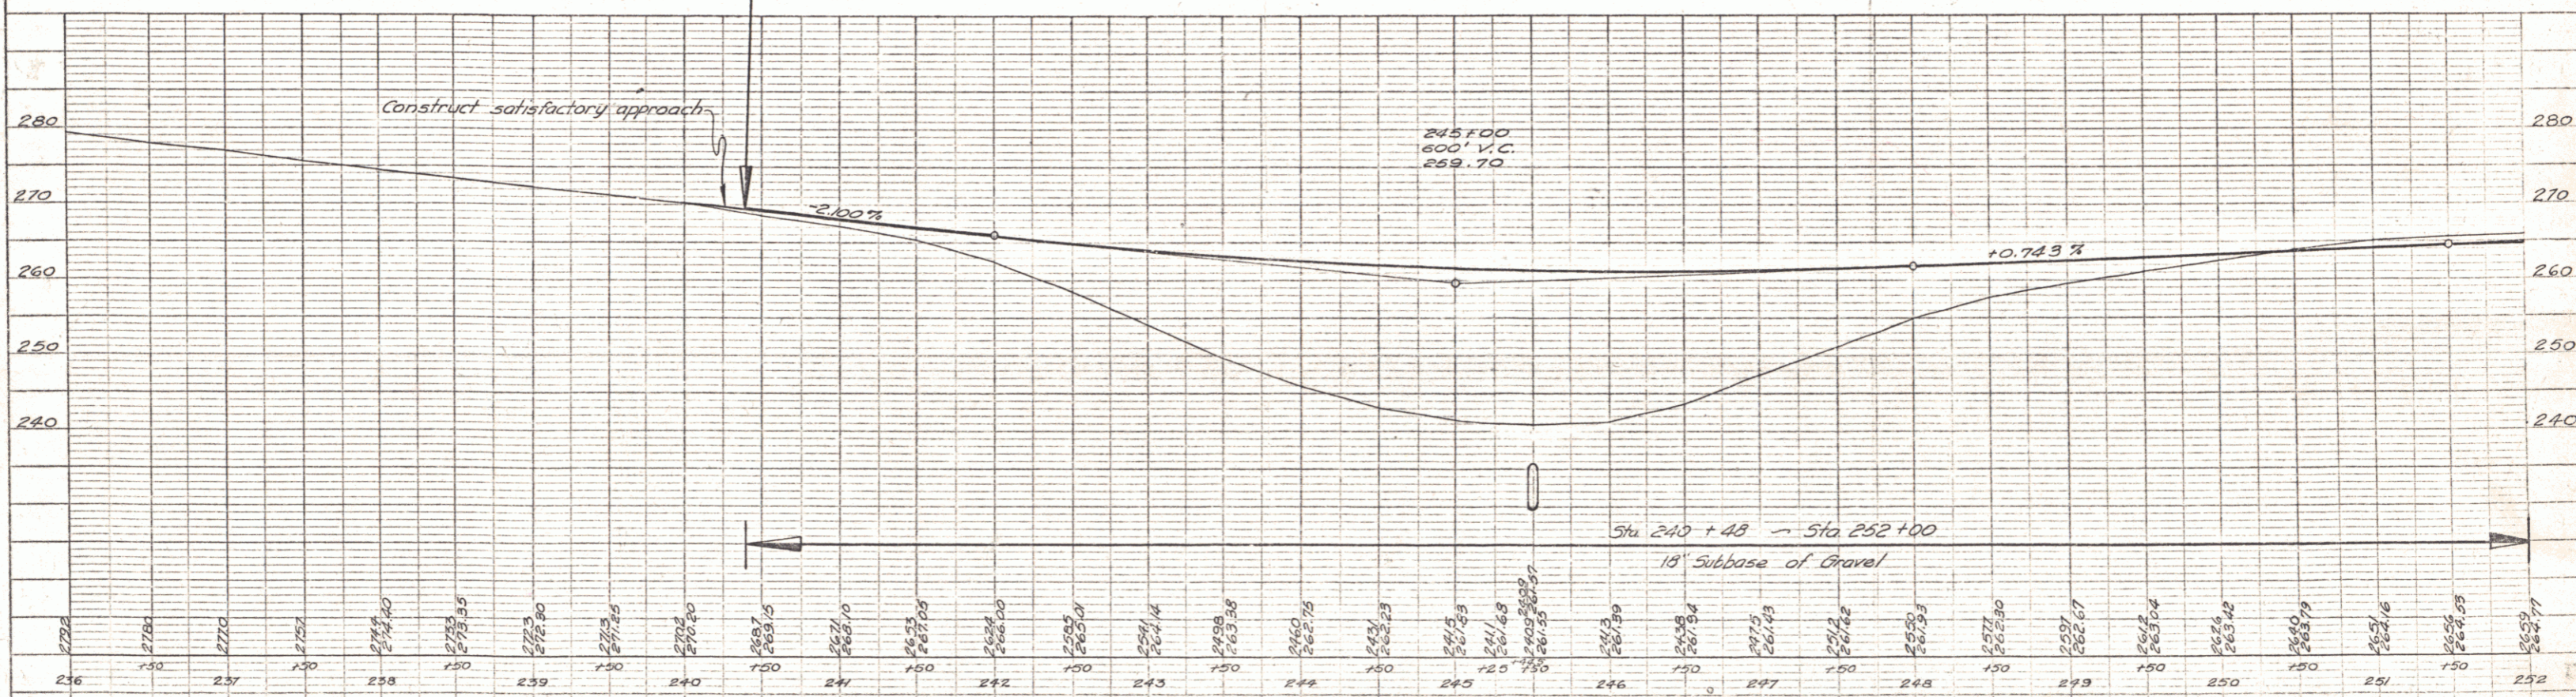


BM * 28 EL 259.83 S1R 18° E 65 FT LI Sta 249+10
BM * 29 EL 266.64 S1R 16° E 65 FT LI Sta 241+90

Bridport - Addison
series 5 no. 13(3)
sheet 4 of 117 sheets



PLAN
DRAWN BY
CHECKED BY
DATE

PROFILE
DRAWN BY
CHECKED BY
DATE

PLATE 1-211-100118 C. O. R. & S. ENGINEERS
BRIDPORT, VERMONT

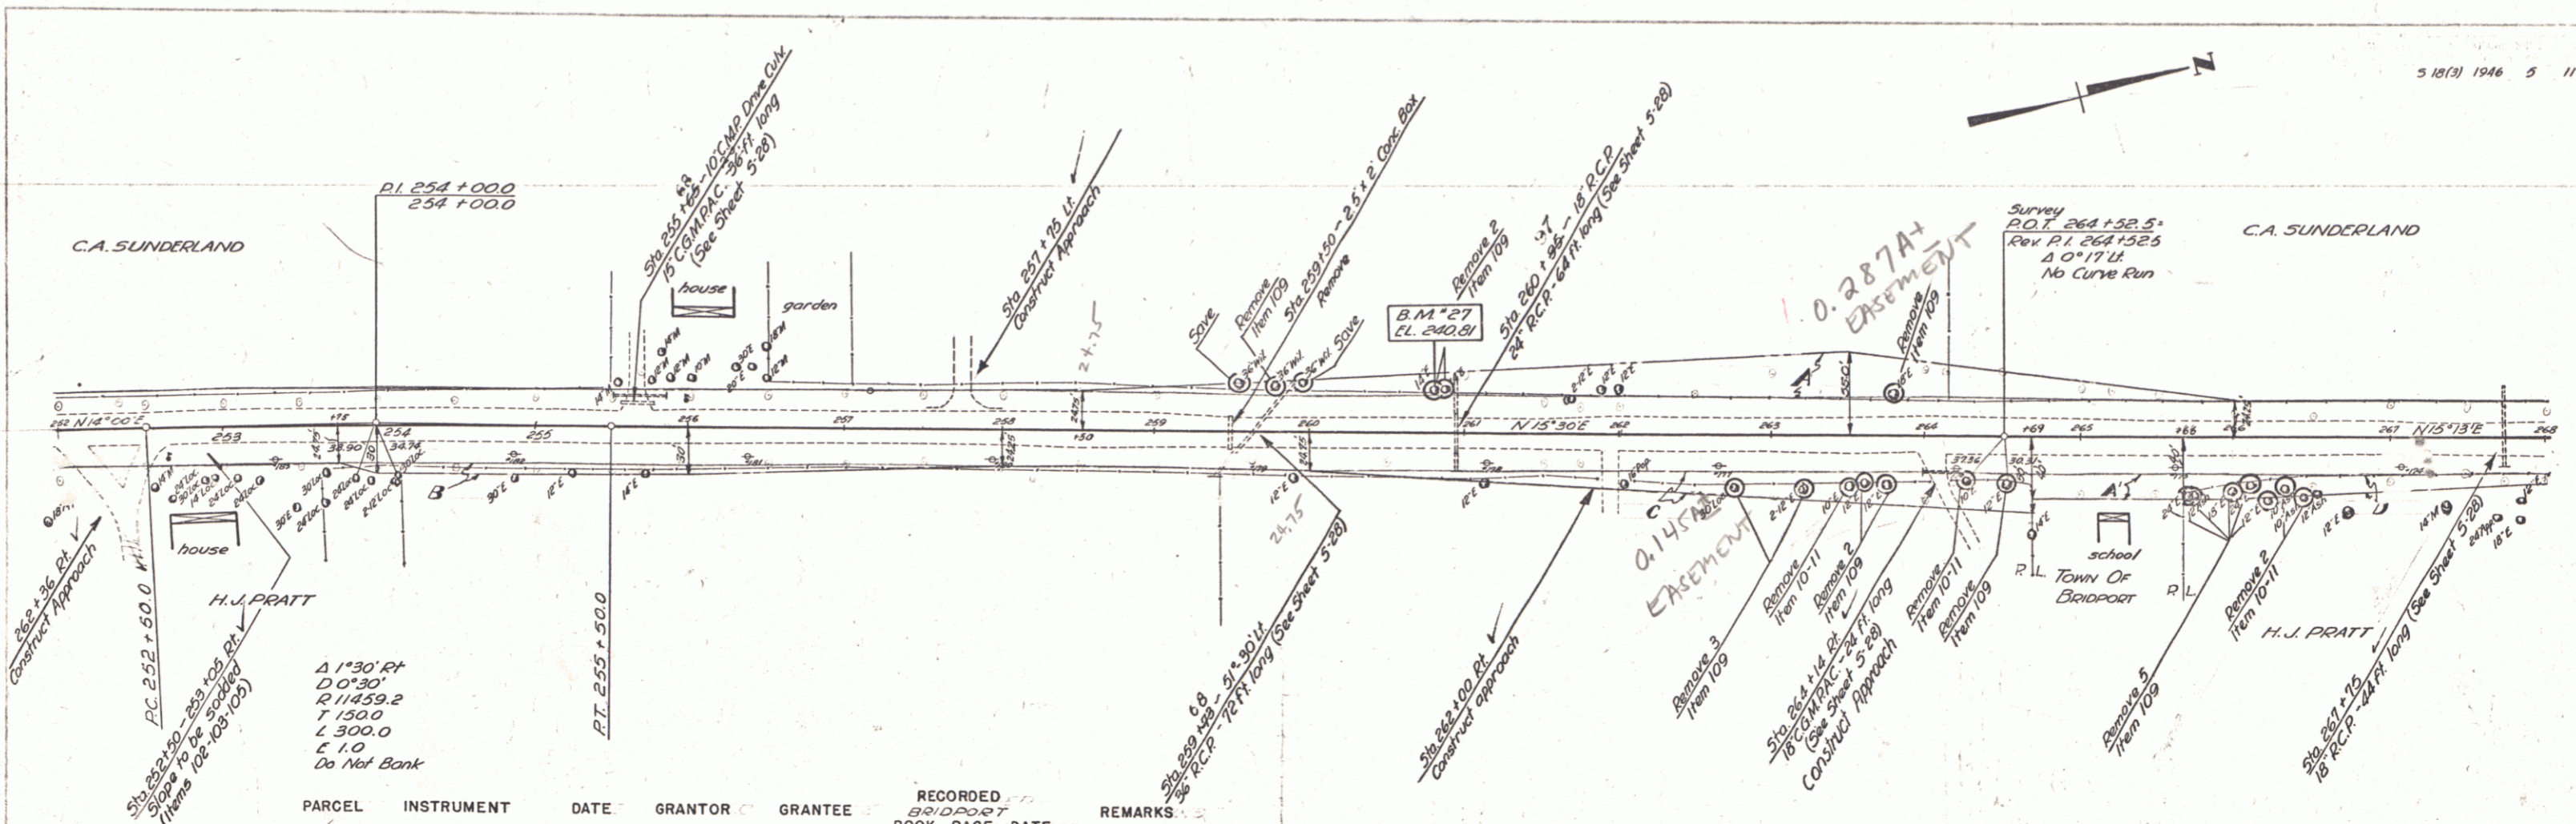

11-45
 12-45
 1-46
 2-46
 3-46
 4-46
 5-46
 6-46
 7-46
 8-46
 9-46
 10-46
 11-46
 12-46
 1-47
 2-47
 3-47
 4-47
 5-47
 6-47
 7-47
 8-47
 9-47
 10-47
 11-47
 12-47
 1-48
 2-48
 3-48
 4-48
 5-48
 6-48
 7-48
 8-48
 9-48
 10-48
 11-48
 12-48
 1-49
 2-49
 3-49
 4-49
 5-49
 6-49
 7-49
 8-49
 9-49
 10-49
 11-49
 12-49
 1-50
 2-50
 3-50
 4-50
 5-50
 6-50
 7-50
 8-50
 9-50
 10-50
 11-50
 12-50
 1-51
 2-51
 3-51
 4-51
 5-51
 6-51
 7-51
 8-51
 9-51
 10-51
 11-51
 12-51
 1-52
 2-52
 3-52
 4-52
 5-52
 6-52
 7-52
 8-52
 9-52
 10-52
 11-52
 12-52
 1-53
 2-53
 3-53
 4-53
 5-53
 6-53
 7-53
 8-53
 9-53
 10-53
 11-53
 12-53
 1-54
 2-54
 3-54
 4-54
 5-54
 6-54
 7-54
 8-54
 9-54
 10-54
 11-54
 12-54
 1-55
 2-55
 3-55
 4-55
 5-55
 6-55
 7-55
 8-55
 9-55
 10-55
 11-55
 12-55
 1-56
 2-56
 3-56
 4-56
 5-56
 6-56
 7-56
 8-56
 9-56
 10-56
 11-56
 12-56
 1-57
 2-57
 3-57
 4-57
 5-57
 6-57
 7-57
 8-57
 9-57
 10-57
 11-57
 12-57
 1-58
 2-58
 3-58
 4-58
 5-58
 6-58
 7-58
 8-58
 9-58
 10-58
 11-58
 12-58
 1-59
 2-59
 3-59
 4-59
 5-59
 6-59
 7-59
 8-59
 9-59
 10-59
 11-59
 12-59
 1-60
 2-60
 3-60
 4-60
 5-60
 6-60
 7-60
 8-60
 9-60
 10-60
 11-60
 12-60
 1-61
 2-61
 3-61
 4-61
 5-61
 6-61
 7-61
 8-61
 9-61
 10-61
 11-61
 12-61
 1-62
 2-62
 3-62
 4-62
 5-62
 6-62
 7-62
 8-62
 9-62
 10-62
 11-62
 12-62
 1-63
 2-63
 3-63
 4-63
 5-63
 6-63
 7-63
 8-63
 9-63
 10-63
 11-63
 12-63
 1-64
 2-64
 3-64
 4-64
 5-64
 6-64
 7-64
 8-64
 9-64
 10-64
 11-64
 12-64
 1-65
 2-65
 3-65
 4-65
 5-65
 6-65
 7-65
 8-65
 9-65
 10-65
 11-65
 12-65
 1-66
 2-66
 3-66
 4-66
 5-66
 6-66
 7-66
 8-66
 9-66
 10-66
 11-66
 12-66
 1-67
 2-67
 3-67
 4-67
 5-67
 6-67
 7-67
 8-67
 9-67
 10-67
 11-67
 12-67
 1-68
 2-68
 3-68
 4-68
 5-68
 6-68
 7-68
 8-68
 9-68
 10-68
 11-68
 12-68
 1-69
 2-69
 3-69
 4-69
 5-69
 6-69
 7-69
 8-69
 9-69
 10-69
 11-69
 12-69
 1-70
 2-70
 3-70
 4-70
 5-70
 6-70
 7-70
 8-70
 9-70
 10-70
 11-70
 12-70
 1-71
 2-71
 3-71
 4-71
 5-71
 6-71
 7-71
 8-71
 9-71
 10-71
 11-71
 12-71
 1-72
 2-72
 3-72
 4-72
 5-72
 6-72
 7-72
 8-72
 9-72
 10-72
 11-72
 12-72
 1-73
 2-73
 3-73
 4-73
 5-73
 6-73
 7-73
 8-73
 9-73
 10-73
 11-73
 12-73
 1-74
 2-74
 3-74
 4-74
 5-74
 6-74
 7-74
 8-74
 9-74
 10-74
 11-74
 12-74
 1-75
 2-75
 3-75
 4-75
 5-75
 6-75
 7-75
 8-75
 9-75
 10-75
 11-75
 12-75
 1-76
 2-76
 3-76
 4-76
 5-76
 6-76
 7-76
 8-76
 9-76
 10-76
 11-76
 12-76
 1-77
 2-77
 3-77
 4-77
 5-77
 6-77
 7-77
 8-77
 9-77
 10-77
 11-77
 12-77
 1-78
 2-78
 3-78
 4-78
 5-78
 6-78
 7-78
 8-78
 9-78
 10-78
 11-78
 12-78
 1-79
 2-79
 3-79
 4-79
 5-79
 6-79
 7-79
 8-79
 9-79
 10-79
 11-79
 12-79
 1-80
 2-80
 3-80
 4-80
 5-80
 6-80
 7-80
 8-80
 9-80
 10-80
 11-80
 12-80
 1-81
 2-81
 3-81
 4-81
 5-81
 6-81
 7-81
 8-81
 9-81
 10-81
 11-81
 12-81
 1-82
 2-82
 3-82
 4-82
 5-82
 6-82
 7-82
 8-82
 9-82
 10-82
 11-82
 12-82
 1-83
 2-83
 3-83
 4-83
 5-83
 6-83
 7-83
 8-83
 9-83
 10-83
 11-83
 12-83
 1-84
 2-84
 3-84
 4-84
 5-84
 6-84
 7-84
 8-84
 9-84
 10-84
 11-84
 12-84
 1-85
 2-85
 3-85
 4-85
 5-85
 6-85
 7-85
 8-85
 9-85
 10-85
 11-85
 12-85
 1-86
 2-86
 3-86
 4-86
 5-86
 6-86
 7-86
 8-86
 9-86
 10-86
 11-86
 12-86
 1-87
 2-87
 3-87
 4-87
 5-87
 6-87
 7-87
 8-87
 9-87
 10-87
 11-87
 12-87
 1-88
 2-88
 3-88
 4-88
 5-88
 6-88
 7-88
 8-88
 9-88
 10-88
 11-88
 12-88
 1-89
 2-89
 3-89
 4-89
 5-89
 6-89
 7-89
 8-89
 9-89
 10-89
 11-89
 12-89
 1-90
 2-90
 3-90
 4-90
 5-90
 6-90
 7-90
 8-90
 9-90
 10-90
 11-90
 12-90
 1-91
 2-91
 3-91
 4-91
 5-91
 6-91
 7-91
 8-91
 9-91
 10-91
 11-91
 12-91
 1-92
 2-92
 3-92
 4-92
 5-92
 6-92
 7-92
 8-92
 9-92
 10-92
 11-92
 12-92
 1-93
 2-93
 3-93
 4-93
 5-93
 6-93
 7-93
 8-93
 9-93
 10-93
 11-93
 12-93
 1-94
 2-94
 3-94
 4-94
 5-94
 6-94
 7-94
 8-94
 9-94
 10-94
 11-94
 12-94
 1-95
 2-95
 3-95
 4-95
 5-95
 6-95
 7-95
 8-95
 9-95
 10-95
 11-95
 12-95
 1-96
 2-96
 3-96
 4-96
 5-96
 6-96
 7-96
 8-96
 9-96
 10-96
 11-96
 12-96
 1-97
 2-97
 3-97
 4-97
 5-97
 6-97
 7-97
 8-97
 9-97
 10-97
 11-97
 12-97
 1-98
 2-98
 3-98
 4-98
 5-98
 6-98
 7-98
 8-98
 9-98
 10-98
 11-98
 12-98
 1-99
 2-99
 3-99
 4-99
 5-99
 6-99
 7-99
 8-99
 9-99
 10-99
 11-99
 12-99
 1-100
 2-100
 3-100
 4-100
 5-100
 6-100
 7-100
 8-100
 9-100
 10-100
 11-100
 12-100
 1-101
 2-101
 3-101
 4-101
 5-101
 6-101
 7-101
 8-101
 9-101
 10-101
 11-101
 12-101
 1-102
 2-102
 3-102
 4-102
 5-102
 6-102
 7-102
 8-102
 9-102
 10-102
 11-102
 12-102
 1-103
 2-103
 3-103
 4-103
 5-103
 6-103
 7-103
 8-103
 9-103
 10-103
 11-103
 12-103
 1-104
 2-104
 3-104
 4-104
 5-104
 6-104
 7-104
 8-104
 9-104
 10-104
 11-104
 12-104
 1-105
 2-105
 3-105
 4-105
 5-105
 6-105
 7-105
 8-105
 9-105
 10-105
 11-105
 12-105
 1-106
 2-106
 3-106
 4-106
 5-106
 6-106
 7-106
 8-106
 9-106
 10-106
 11-106
 12-106
 1-107
 2-107
 3-107
 4-107
 5-107
 6-107
 7-107
 8-107
 9-107
 10-107
 11-107
 12-107
 1-108
 2-108
 3-108
 4-108
 5-108
 6-108
 7-108
 8-108
 9-108
 10-108
 11-108
 12-108
 1-109
 2-109
 3-109
 4-109
 5-109
 6-109
 7-109
 8-109
 9-109
 10-109
 11-109
 12-109
 1-110
 2-110
 3-110
 4-110
 5-110
 6-110
 7-110
 8-110
 9-110
 10-110
 11-110
 12-110
 1-111
 2-111
 3-111
 4-111
 5-111
 6-111
 7-111
 8-111
 9-111
 10-111
 11-111
 12-111
 1-112
 2-112
 3-112
 4-112
 5-112
 6-112
 7-112
 8-112
 9-112
 10-112
 11-112
 12-112
 1-113
 2-113
 3-113
 4-113
 5-113
 6-113
 7-113
 8-113
 9-113
 10-113
 11-113
 12-113
 1-114
 2-114
 3-114
 4-114
 5-114
 6-114
 7-114
 8-114
 9-114
 10-114
 11-114
 12-114
 1-115
 2-115
 3-115
 4-115
 5-115
 6-115
 7-115
 8-115
 9-115
 10-115
 11-115
 12-115
 1-116
 2-116
 3-116
 4-116
 5-116
 6-116
 7-116
 8-116
 9-116
 10-116
 11-116
 12-116
 1-117
 2-117
 3-117
 4-117
 5-117
 6-117
 7-117
 8-117
 9-117
 10-117
 11-117
 12-117
 1-118
 2-118
 3-118
 4-118
 5-118
 6-118
 7-118
 8-118
 9-118
 10-118
 11-118
 12-118
 1-119
 2-119
 3-119
 4-119
 5-119
 6-119
 7-119
 8-119
 9-119
 10-119
 11-119
 12-119
 1-120
 2-120
 3-120
 4-120
 5-120
 6-120
 7-120
 8-120
 9-120
 10-120
 11-120
 12-120
 1-121
 2-121
 3-121
 4-121
 5-121
 6-121
 7-121
 8-121
 9-121
 10-121
 11-121
 12-121
 1-122
 2-122
 3-122
 4-122
 5-122
 6-122
 7-122
 8-122
 9-122
 10-122
 11-122
 12-122
 1-123
 2-123
 3-123
 4-123
 5-123
 6-123
 7-123
 8-123
 9-123
 10-123
 11-123
 12-123
 1-124
 2-124
 3-124
 4-124
 5-124
 6-124
 7-124
 8-124
 9-124
 10-124
 11-124
 12-124
 1-125
 2-125
 3-125
 4-125
 5-125
 6-125
 7-125
 8-125
 9-125
 10-125
 11-125
 12-125
 1-126
 2-126
 3-126
 4-126
 5-126
 6-126
 7-126
 8-126
 9-126
 10-126
 11-126
 12-126
 1-127
 2-127
 3-127
 4-127
 5-127
 6-127
 7-127
 8-127
 9-127
 10-127
 11-127
 12-127
 1-128
 2-128
 3-128
 4-128
 5-128
 6-128
 7-128
 8-128
 9-128
 10-128
 11-128
 12-128
 1-129
 2-129
 3-129
 4-129
 5-129
 6-129
 7-129
 8-129
 9-129
 10-129
 11-129
 12-129
 1-130
 2-130
 3-130
 4-130
 5-130
 6-130
 7-130
 8-130
 9-130
 10-130
 11-130
 12-130
 1-131
 2-131
 3-131
 4-131
 5-131
 6-131
 7-131
 8-131
 9-131
 10-131
 11-131
 12-131
 1-132
 2-132
 3-132
 4-132
 5-132
 6-132
 7-132
 8-132
 9-132
 10-132
 11-132
 12-132
 1-133
 2-133
 3-133
 4-133
 5-133
 6-133
 7-133
 8-133
 9-133
 10-133
 11-133
 12-133
 1-134
 2-134
 3-134
 4-134
 5-134
 6-134
 7-134
 8-134
 9-134
 10-134
 11-134
 12-134
 1-135
 2-135
 3-135
 4-135
 5-135
 6-135
 7-135
 8-135
 9-135
 10-135
 11-135
 12-135
 1-136
 2-136
 3-136
 4-136
 5-136
 6-136
 7-136
 8-136
 9-136
 10-136
 11-136
 12-136
 1-137
 2-137
 3-137
 4-137
 5-137
 6-137
 7-137
 8-137
 9-137
 10-137
 11-137
 12-137
 1-138
 2-138
 3-138
 4-138
 5-138
 6-138
 7-138
 8-138
 9-138
 10-138
 11-138
 12-138
 1-139
 2-139
 3-139
 4-139
 5-139
 6-139
 7-139
 8-139
 9-139
 10-139
 11-139
 12-139
 1-140
 2-140
 3-140
 4-140
 5-140
 6-140
 7-140
 8-140
 9-140
 10-140
 11-140
 12-140
 1-141
 2-141
 3-141
 4-141
 5-141
 6-141
 7-141
 8-141
 9-141
 10-141
 11-141
 12-141
 1-142
 2-142
 3-142
 4-142
 5-142
 6-142
 7-142
 8-142
 9-142
 10-142
 11-142
 12-142
 1-143
 2-143
 3-143
 4-143
 5-143
 6-143
 7-143
 8-143
 9-143
 10-143
 11-143
 12-143
 1-144
 2-144
 3-144
 4-144
 5-144
 6-144
 7-144
 8-144
 9-144
 10-144
 11-144
 12-144
 1-145
 2-145
 3-145
 4-145
 5-145
 6-145
 7-145
 8-145
 9-145
 10-145
 11-145
 12-145
 1-146
 2-146
 3-146
 4-146
 5-146
 6-146
 7-146
 8-146
 9-146
 10-146
 11-146
 12-146
 1-147
 2-147
 3-147
 4-147
 5-147
 6-147
 7-147
 8-147
 9-147
 10-147
 11-147
 12-147
 1-148
 2-148
 3-148
 4-148
 5-148
 6-148
 7-148
 8-148
 9-148
 10-148
 11-148
 12-148
 1-149
 2-149
 3-149
 4-

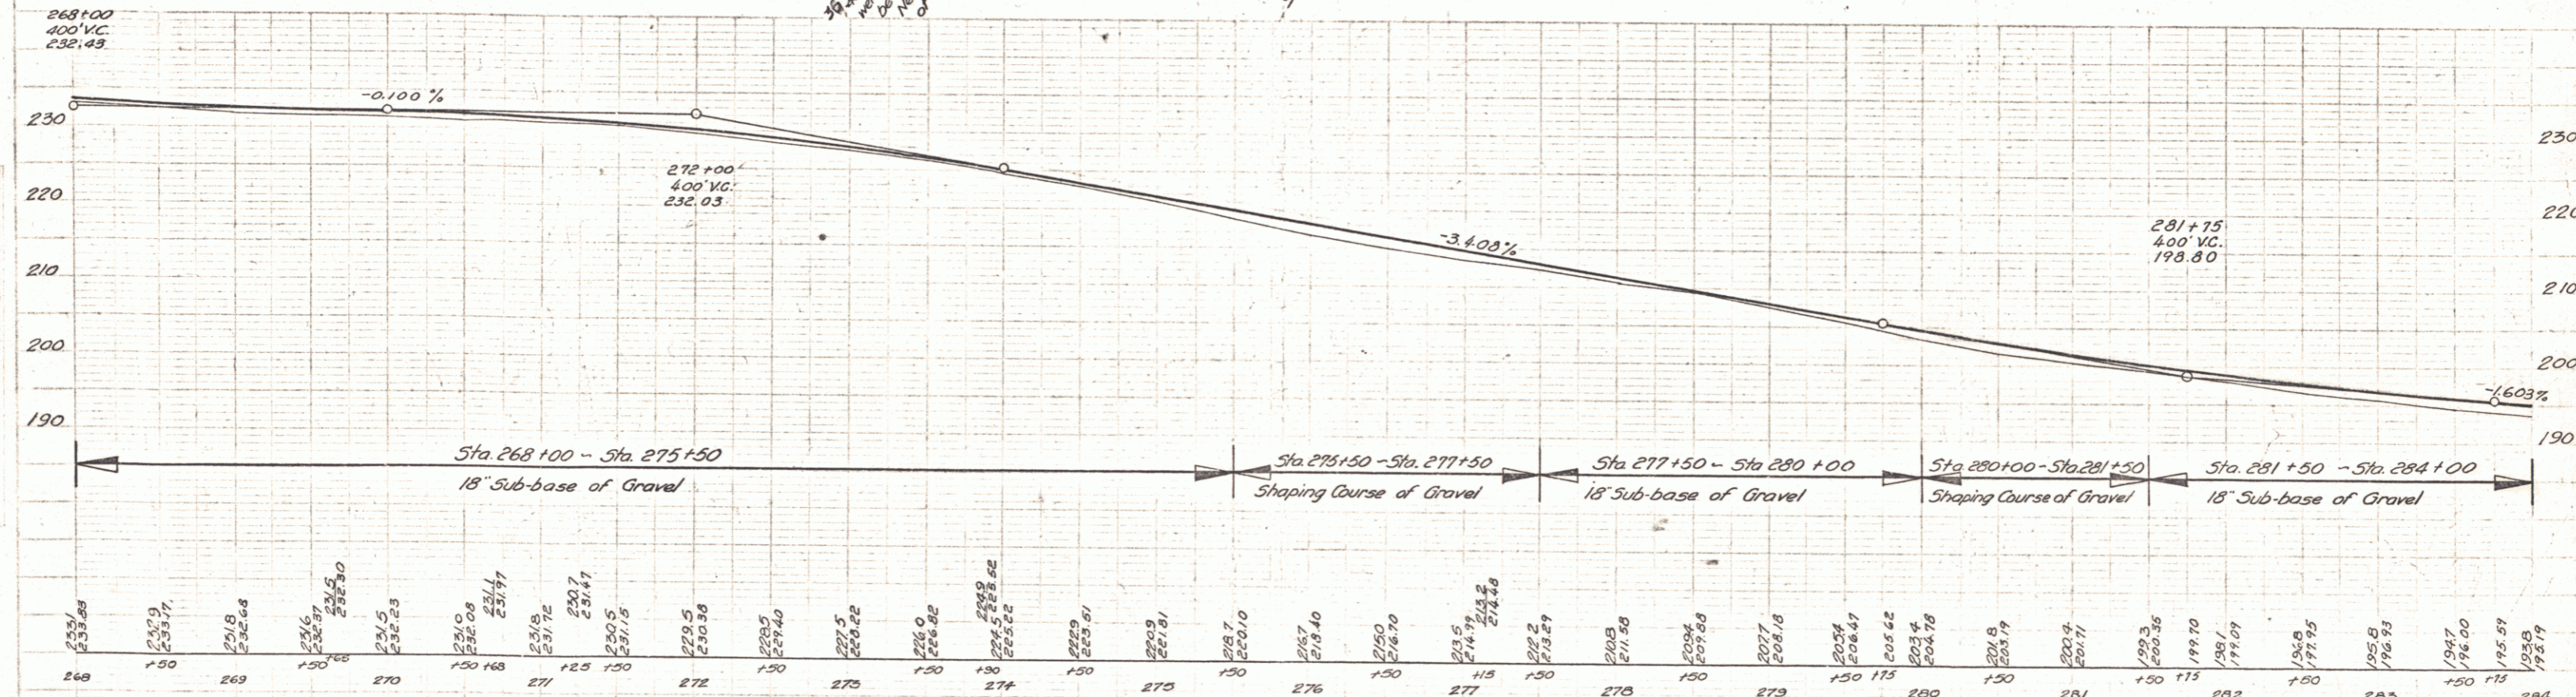
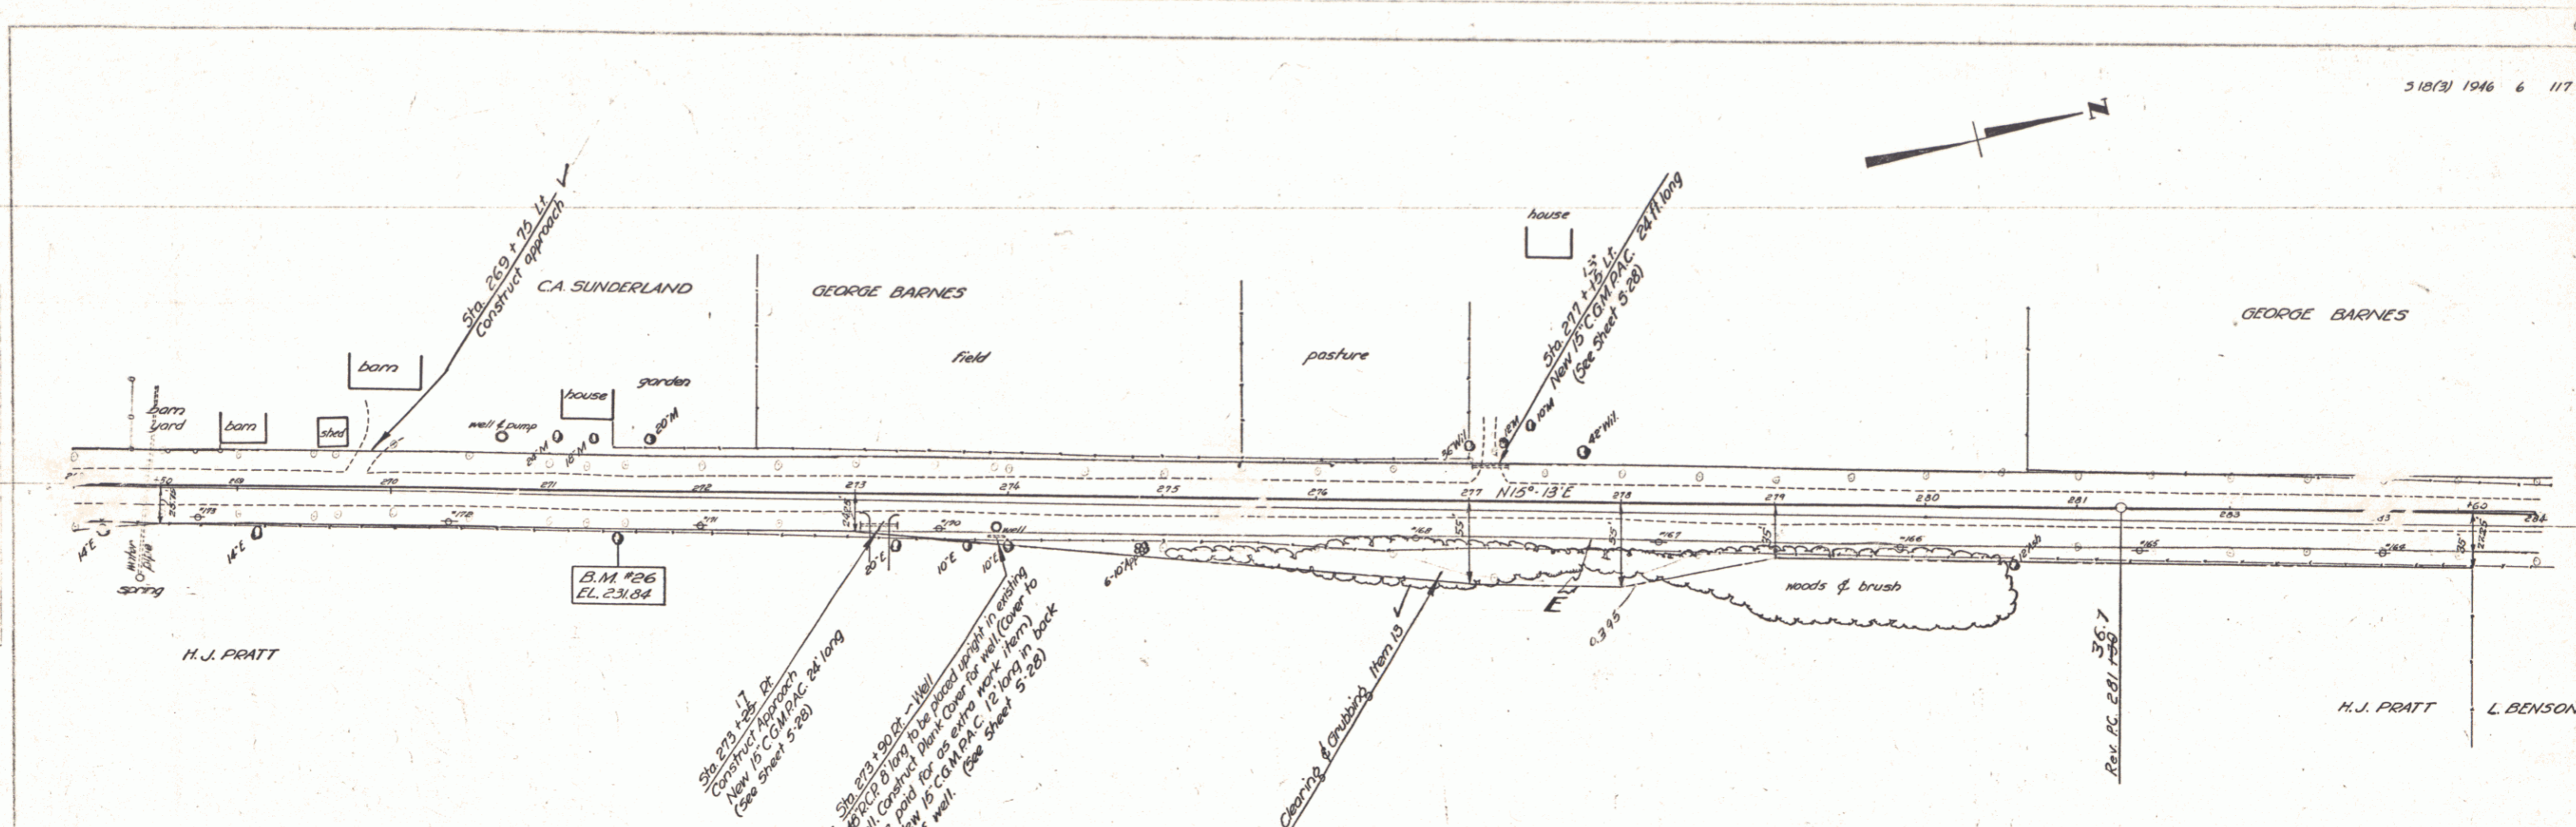


B.M. # 26 EL 231.84 S.I.R.I.A. Elm 25 Ft. Rt. Sta. 271+45

Bridport-Addison Series 5, No. 13(B) Sheet 6 of 117 sheets

PARCEL	INSTRUMENT	DATE	GRANTOR	GRANTEE	RECORDED BOOK PAGE DATE	REMARKS
JA	W.D.O.E.	10-1-46	LERDY BENSON	ST. OF VT.	20 617-618 10-18-46	
JA'	W.D.O.E.	10-1-46	PHILIAS QUENNEVILLE	" " "	20 620-621 10-18-46	

DIST. NO.	STATE	PROJ. NO.	YEAR	SHEET NO.	TOTAL SHEETS
5	VT.	518(3)	1946	7	117

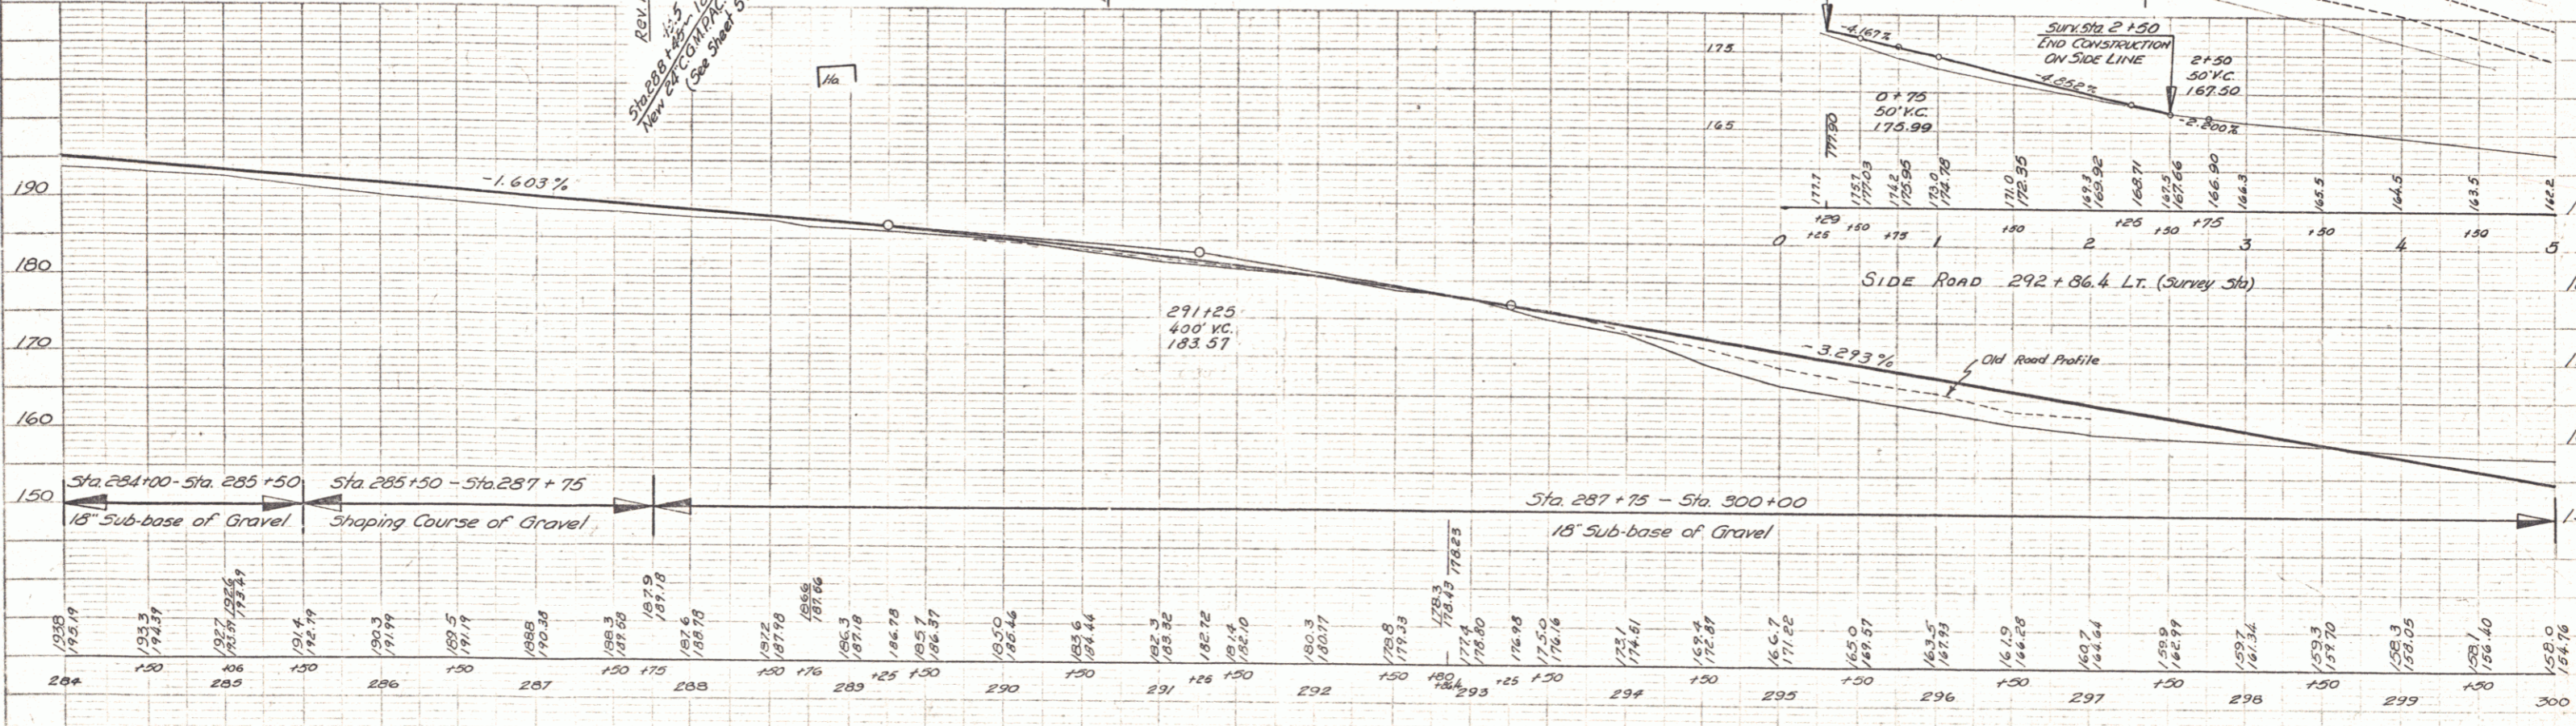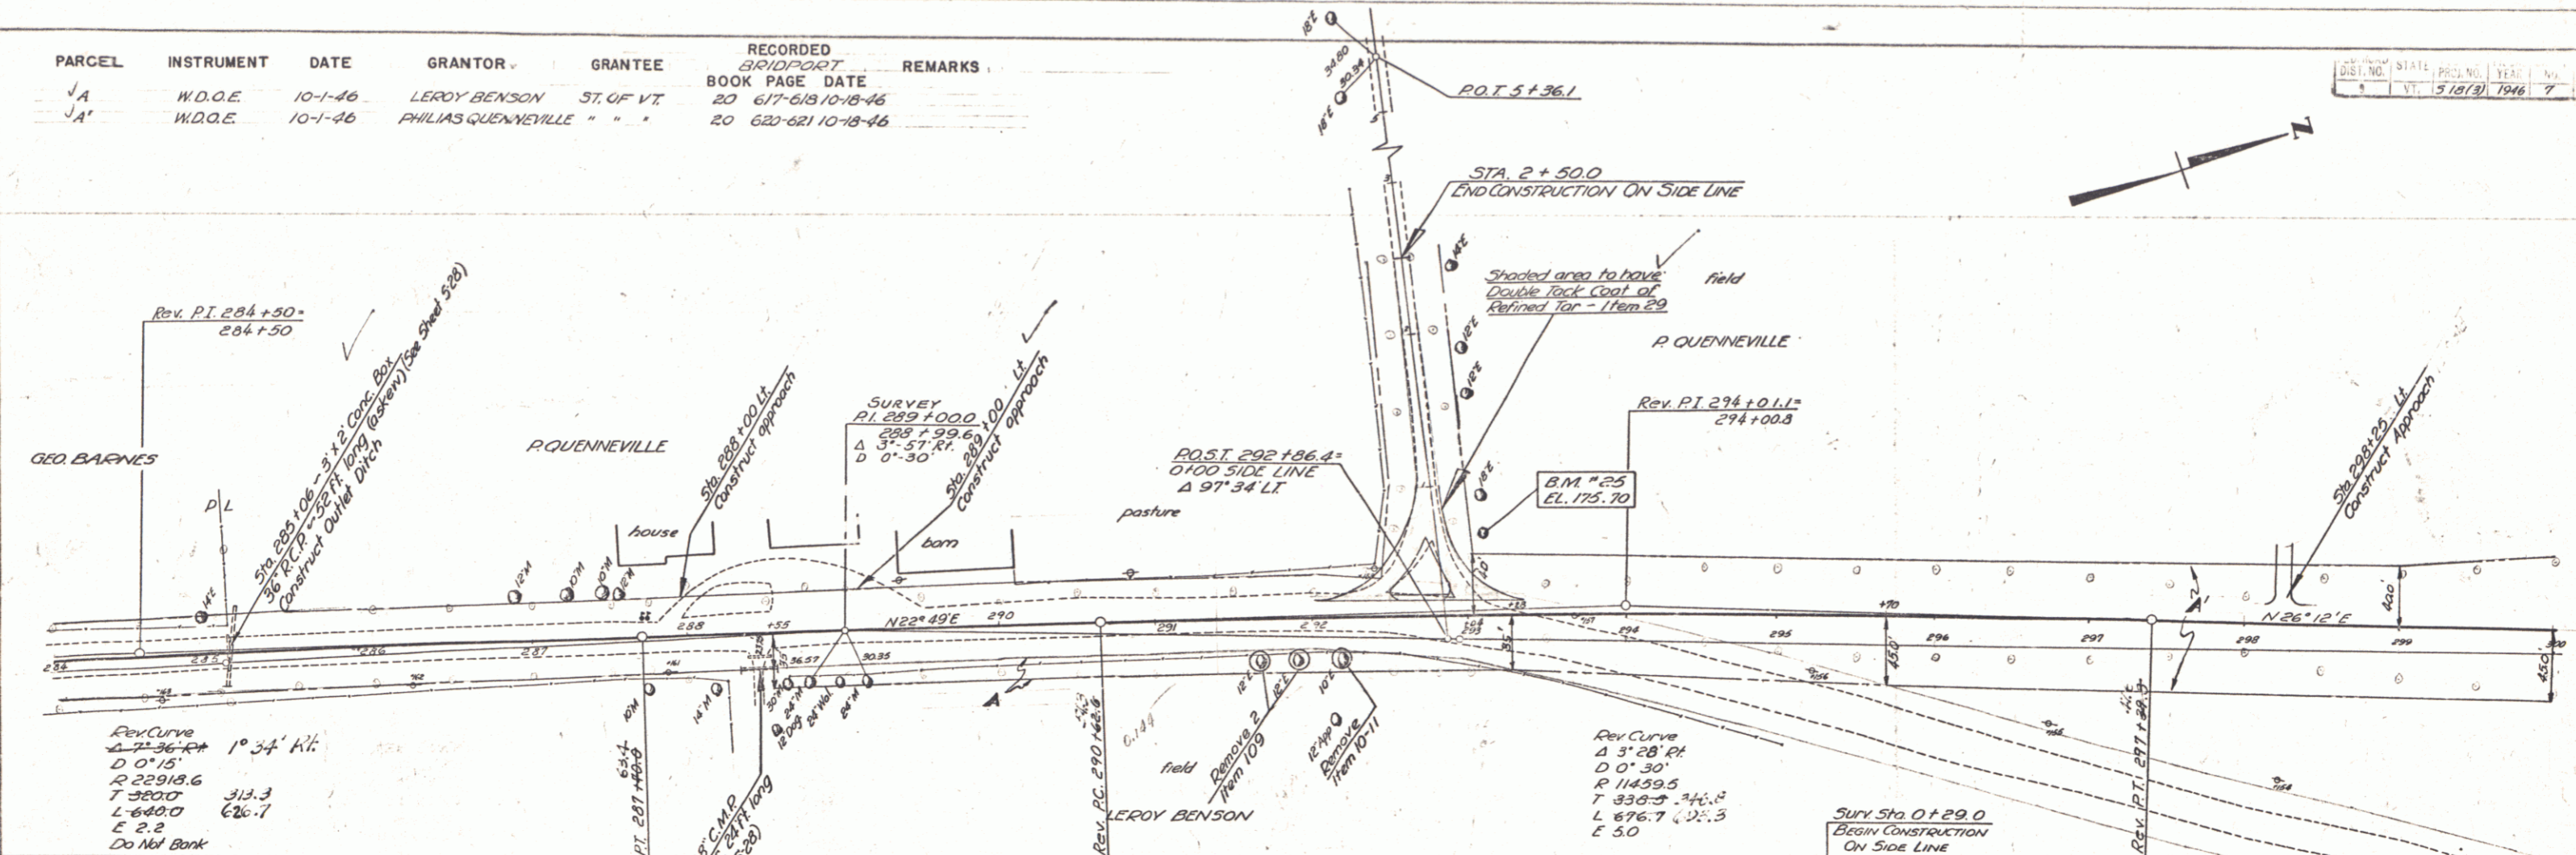



BM # 25 EL 175.70 SIR 18' Elm 651' LT Sta 293+07

Bridgeport - Addison series 5 no 18(3) sheet 7 of 117 sheets

PLAN
 DRAWN BY: [Signature]
 CHECKED BY: [Signature]
 DATE: 10-1-46

PROFILE
 DRAWN BY: [Signature]
 CHECKED BY: [Signature]
 DATE: 10-1-46

PLATE ENCL. 1011A, 1011B, 1011C, 1011D
 K. & C. CO. No. 245-C

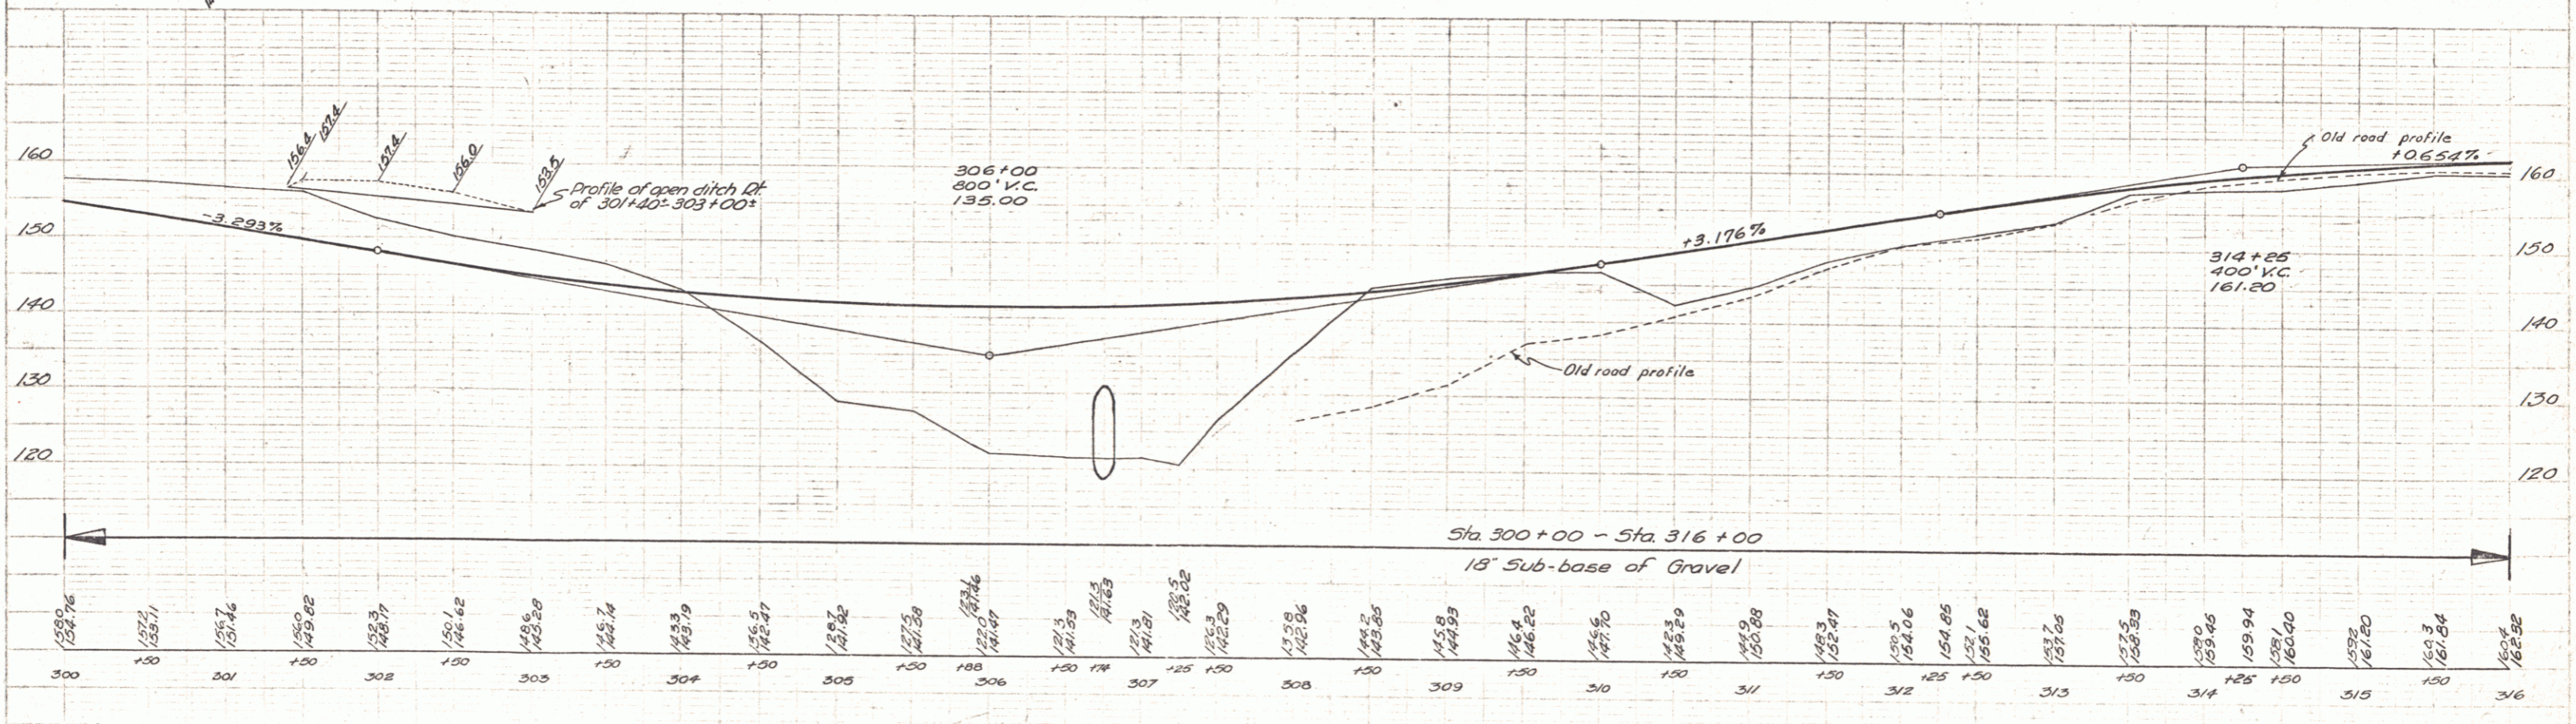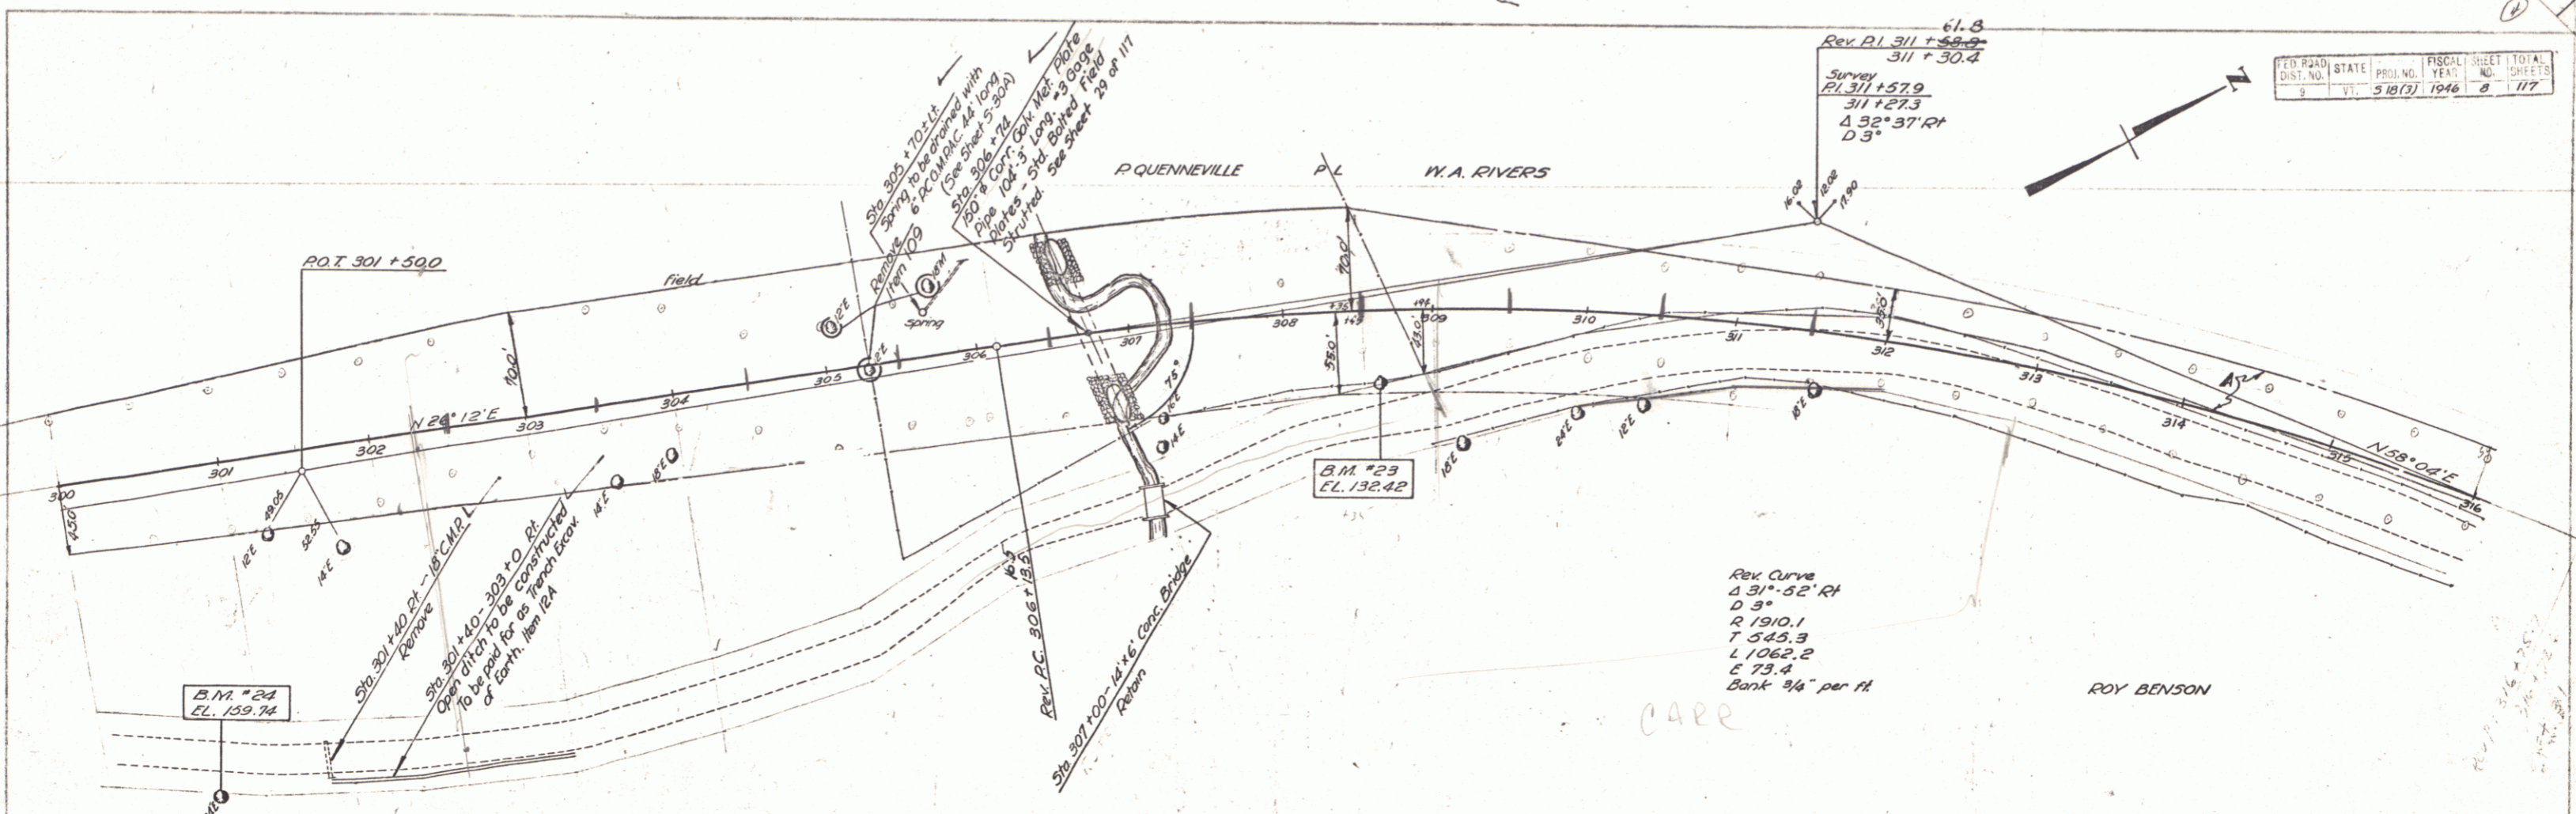


B.M. #23 EL. 132.42 S.I.R. 12' E. 100' RT Sta 308+59
 B.M. #24 EL. 159.74 S.I.R. 14' E. 100' RT Sta 300+62

Bridgeport - Addison
 series 5 no. 18 (3)
 sheet 8 of 117 sheets

PARCEL INSTRUMENT DATE GRANTOR GRANTEE RECORDED ADDISON REMARKS
 B W.D.O.E. 10-1-46 EDWARD C. & ALTA A. TOWN OF ADDISON 29 240-241 10-19-46
 BRILEYA

FED. ROAD DIST. NO.	STATE	PROJ. NO.	FISCAL YEAR	SHEET NO.	TOTAL SHEETS
9	VT	5 1073	1946	11	177

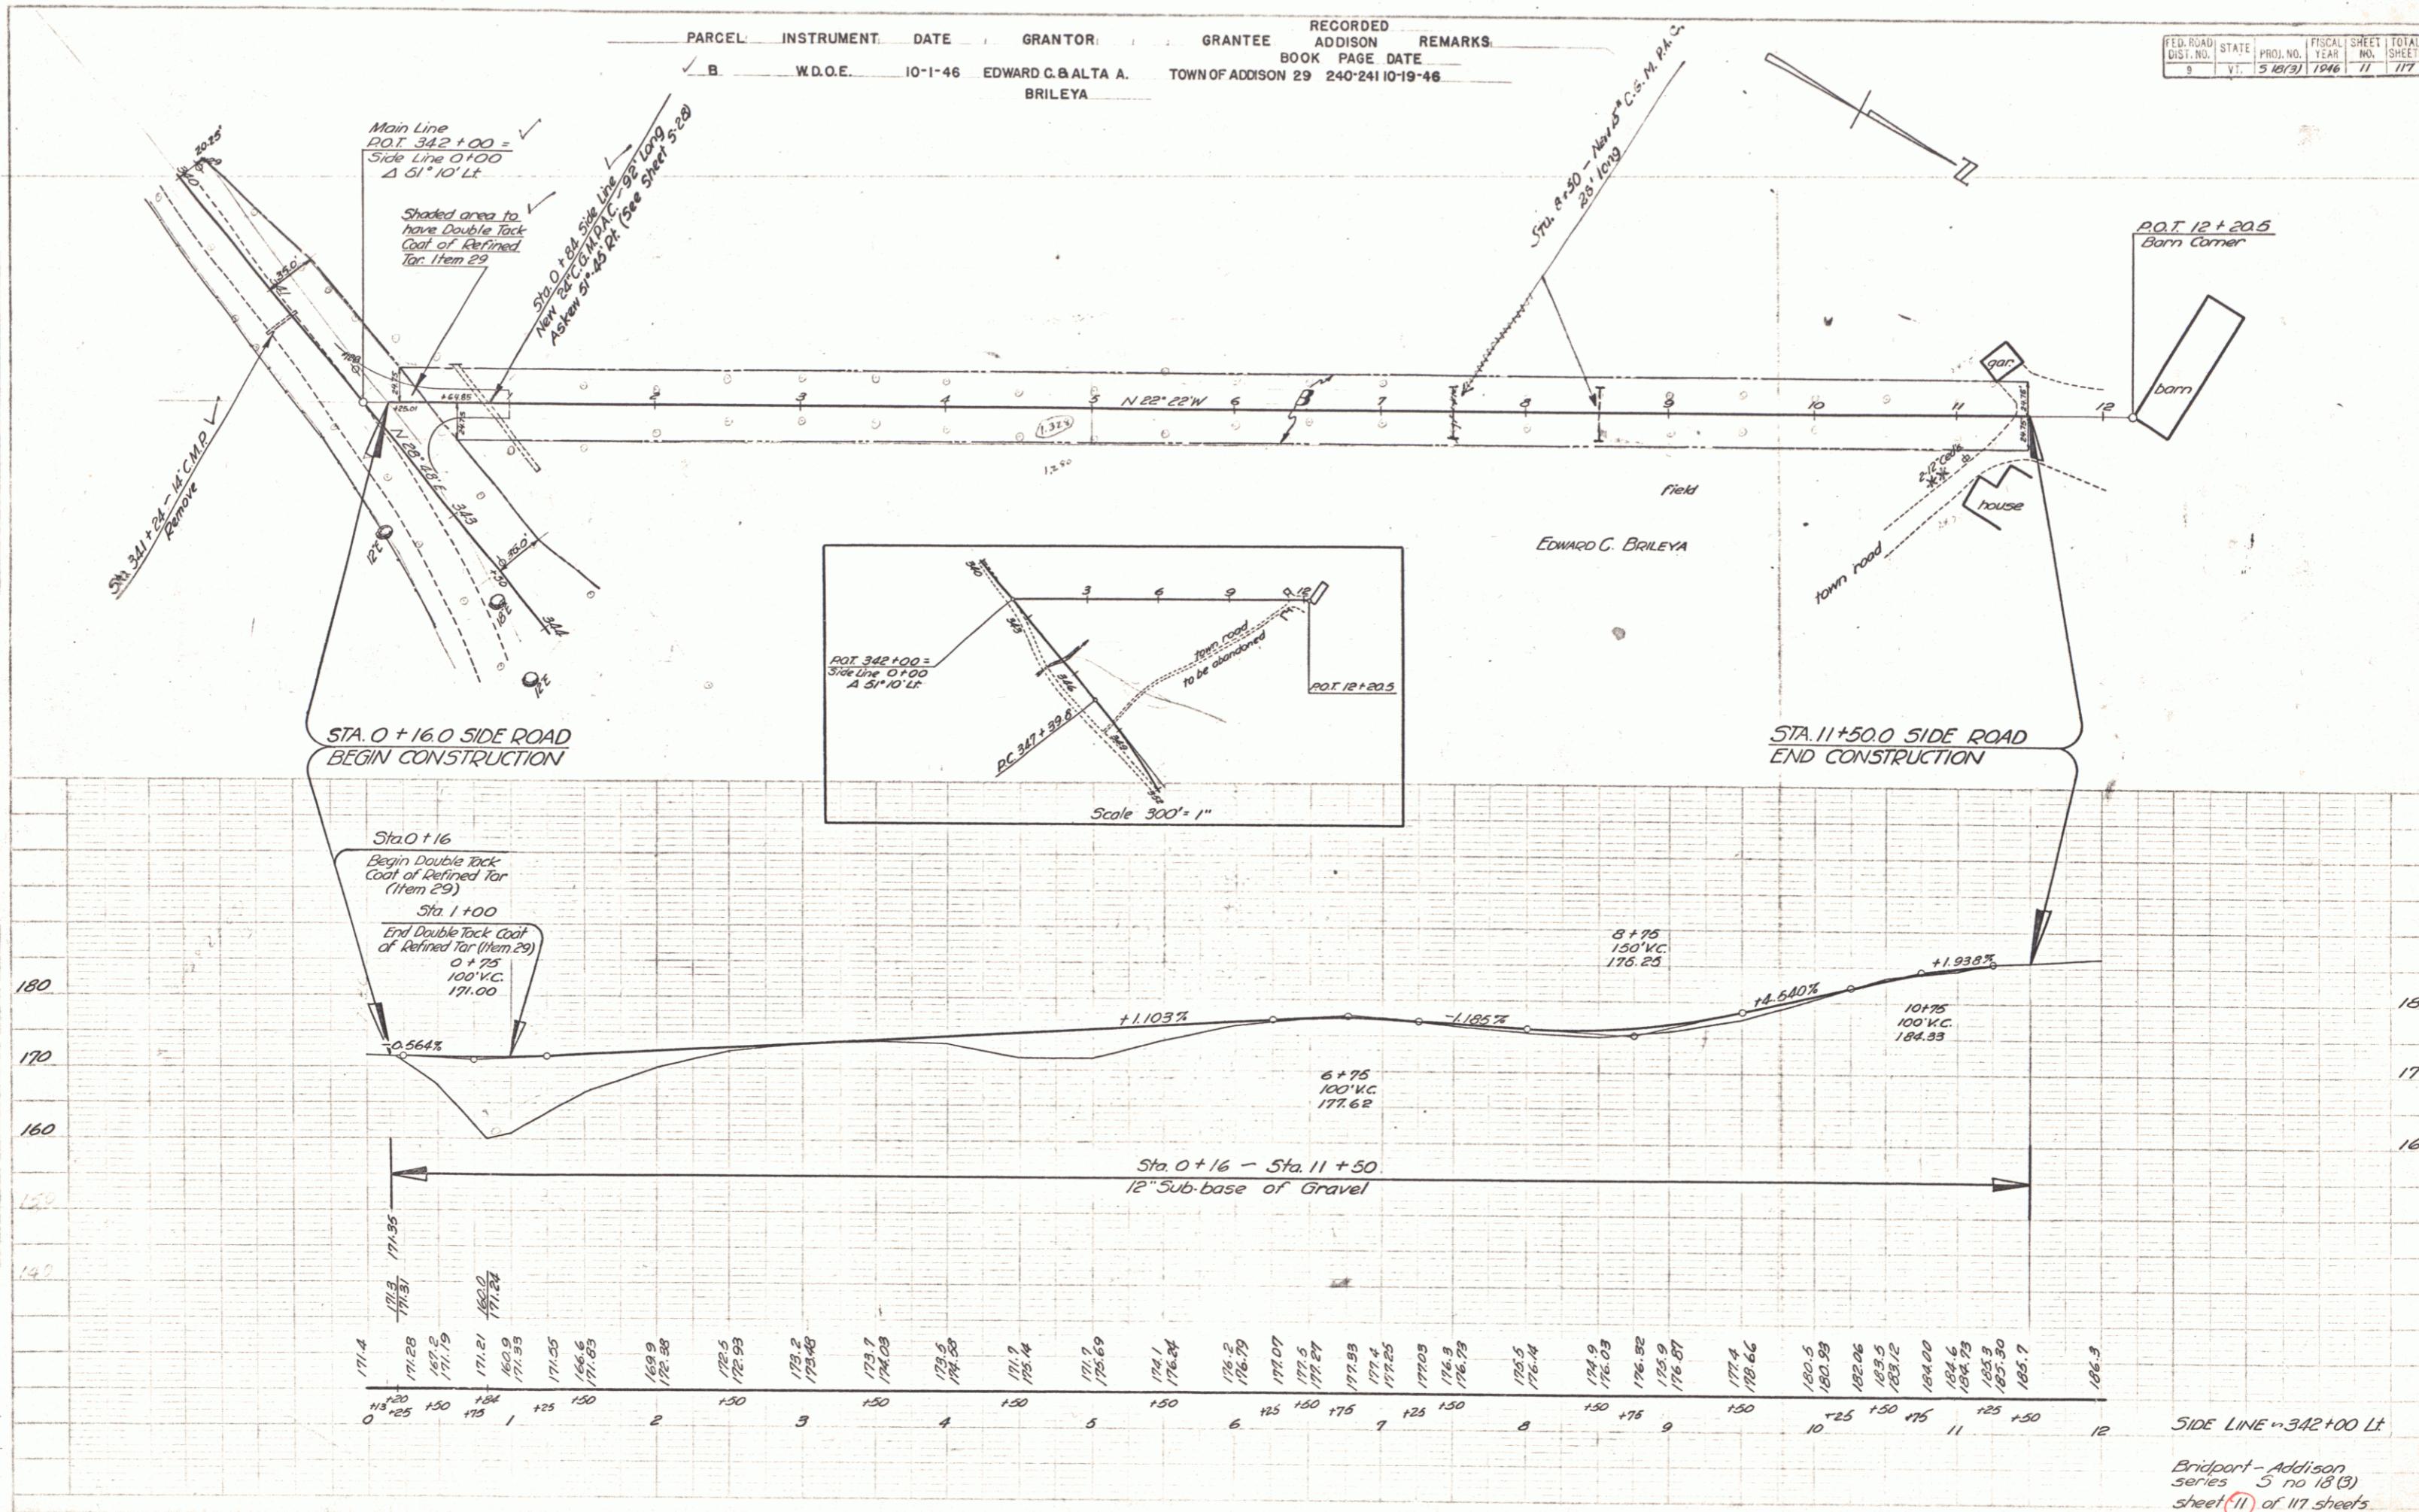


PLAN	DATE	BY
DATE REVISION		
NO.		


PROFILE	DATE	BY
DATE REVISION		
NO.		

Bridgeport - Addison series 5 no 18 (B) sheet 11 of 117 sheets

PLAN
 1/2" = 100'
 1/4" = 50'

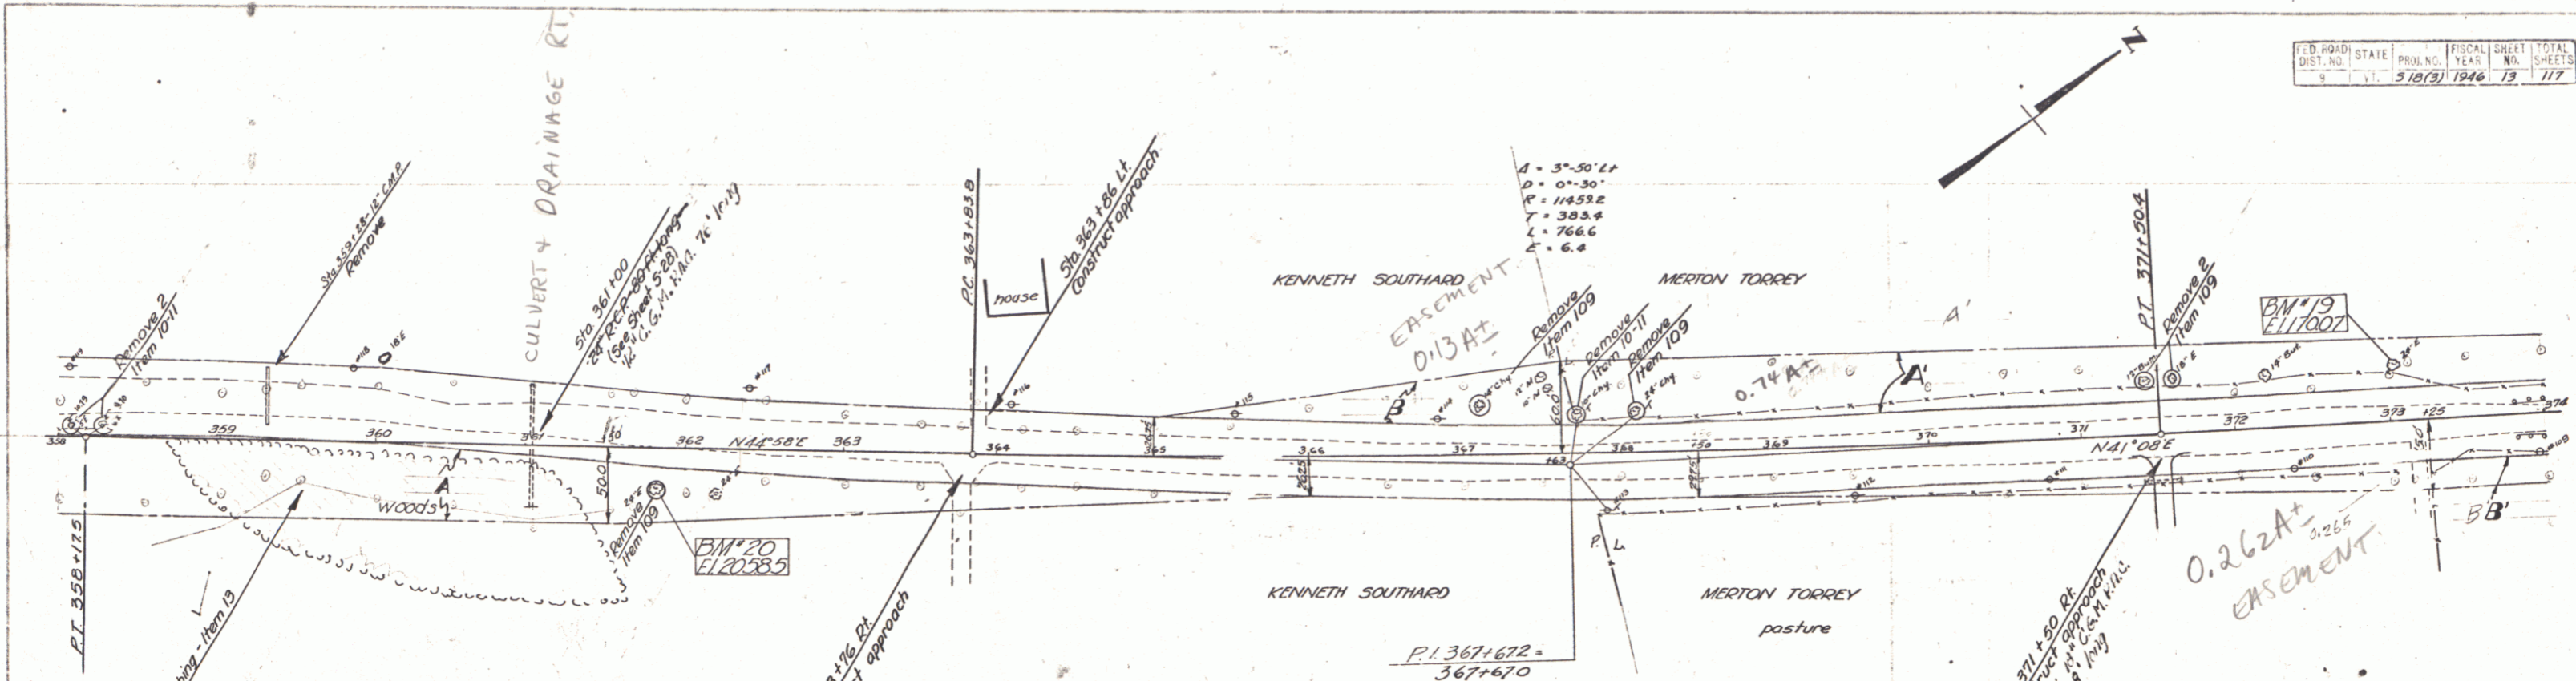


PARCEL	INSTRUMENT	DATE	GRANTOR	GRANTEE	RECORDED ADDISON BOOK PAGE DATE	REMARKS
✓ ABB	W.D.O.E.	10-1-46	KENNETH SOUTHARD	ST. OF VT.	29 243-244 10-19-46	
✓ A'BB'	W.D.O.E.	11-21-46	MERTON & SHIRLEY B. TORREY	" "	29 274-276 12-6-46	

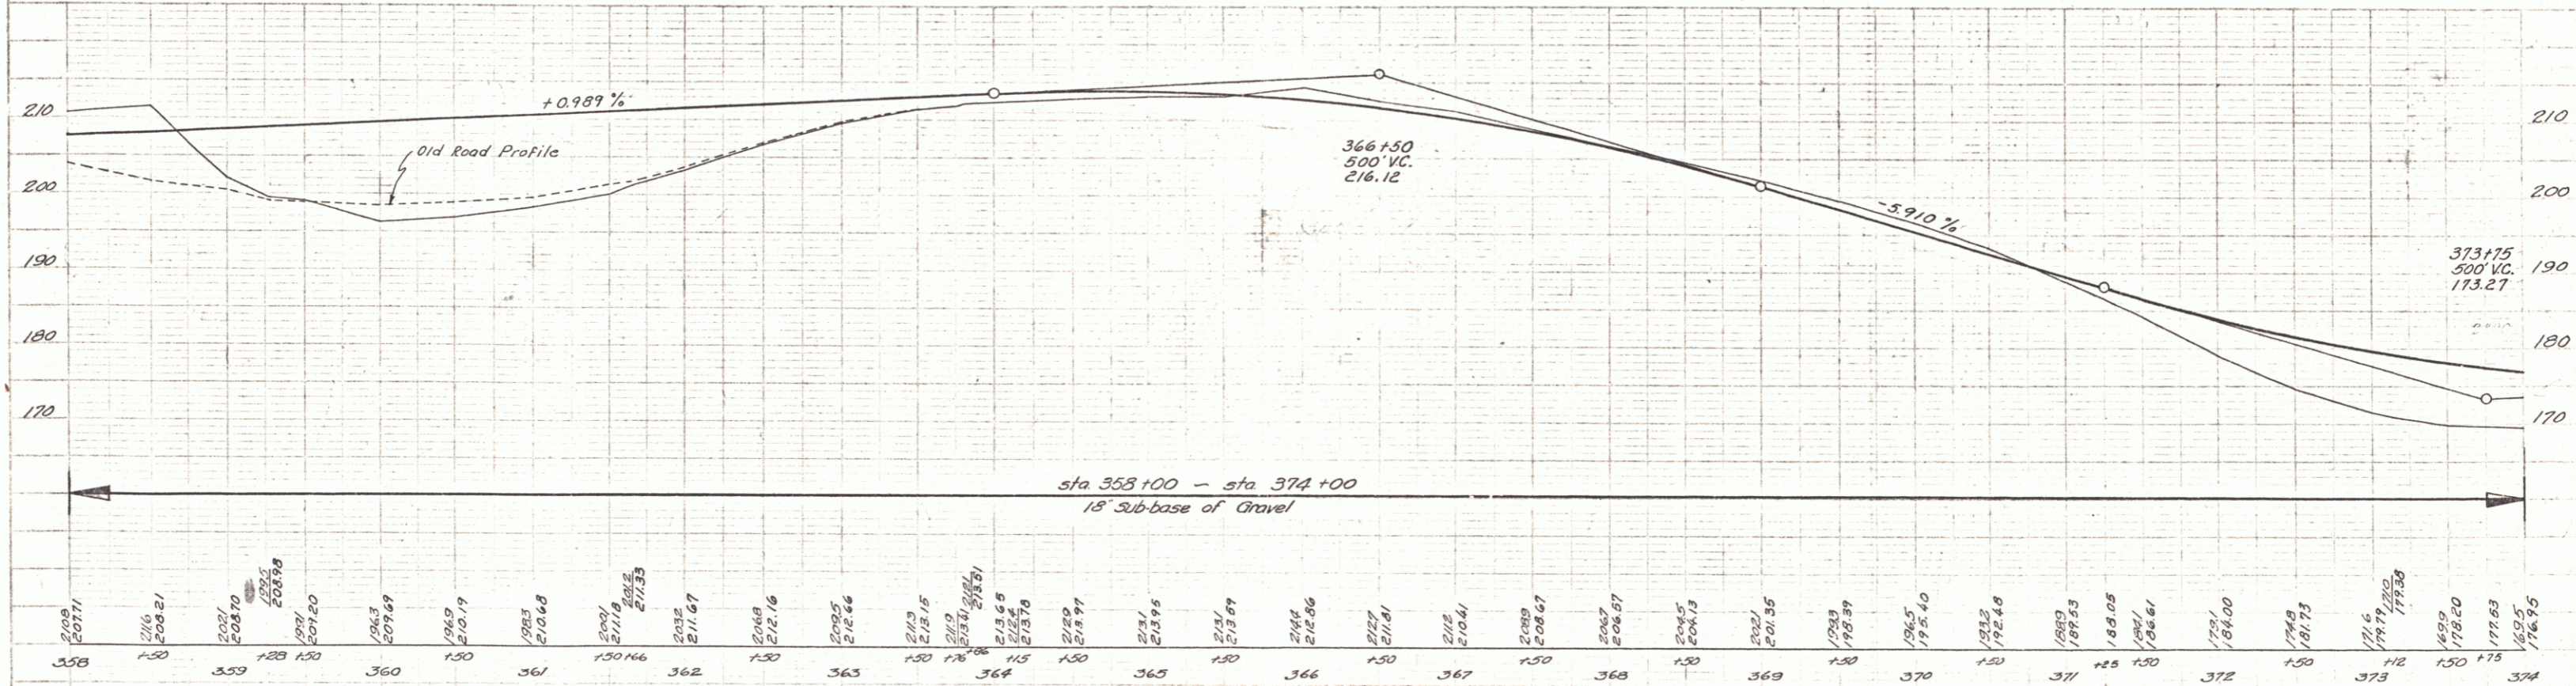


BM#19 E117007 S.I.R. 24' Elm 32H Lt Sta 373+02
 BM#20 E120585 S.I.C. 24' Elm 24H Rt Sta 361+80

Bridport-Addison series 5 no. 18(3) sheet 13 of 17 sheets


FED. ROAD DIST. NO.	STATE	PROJ. NO.	FEED. SHEET NO.	TOTAL SHEETS
5	Vt.	518(3)	14	117

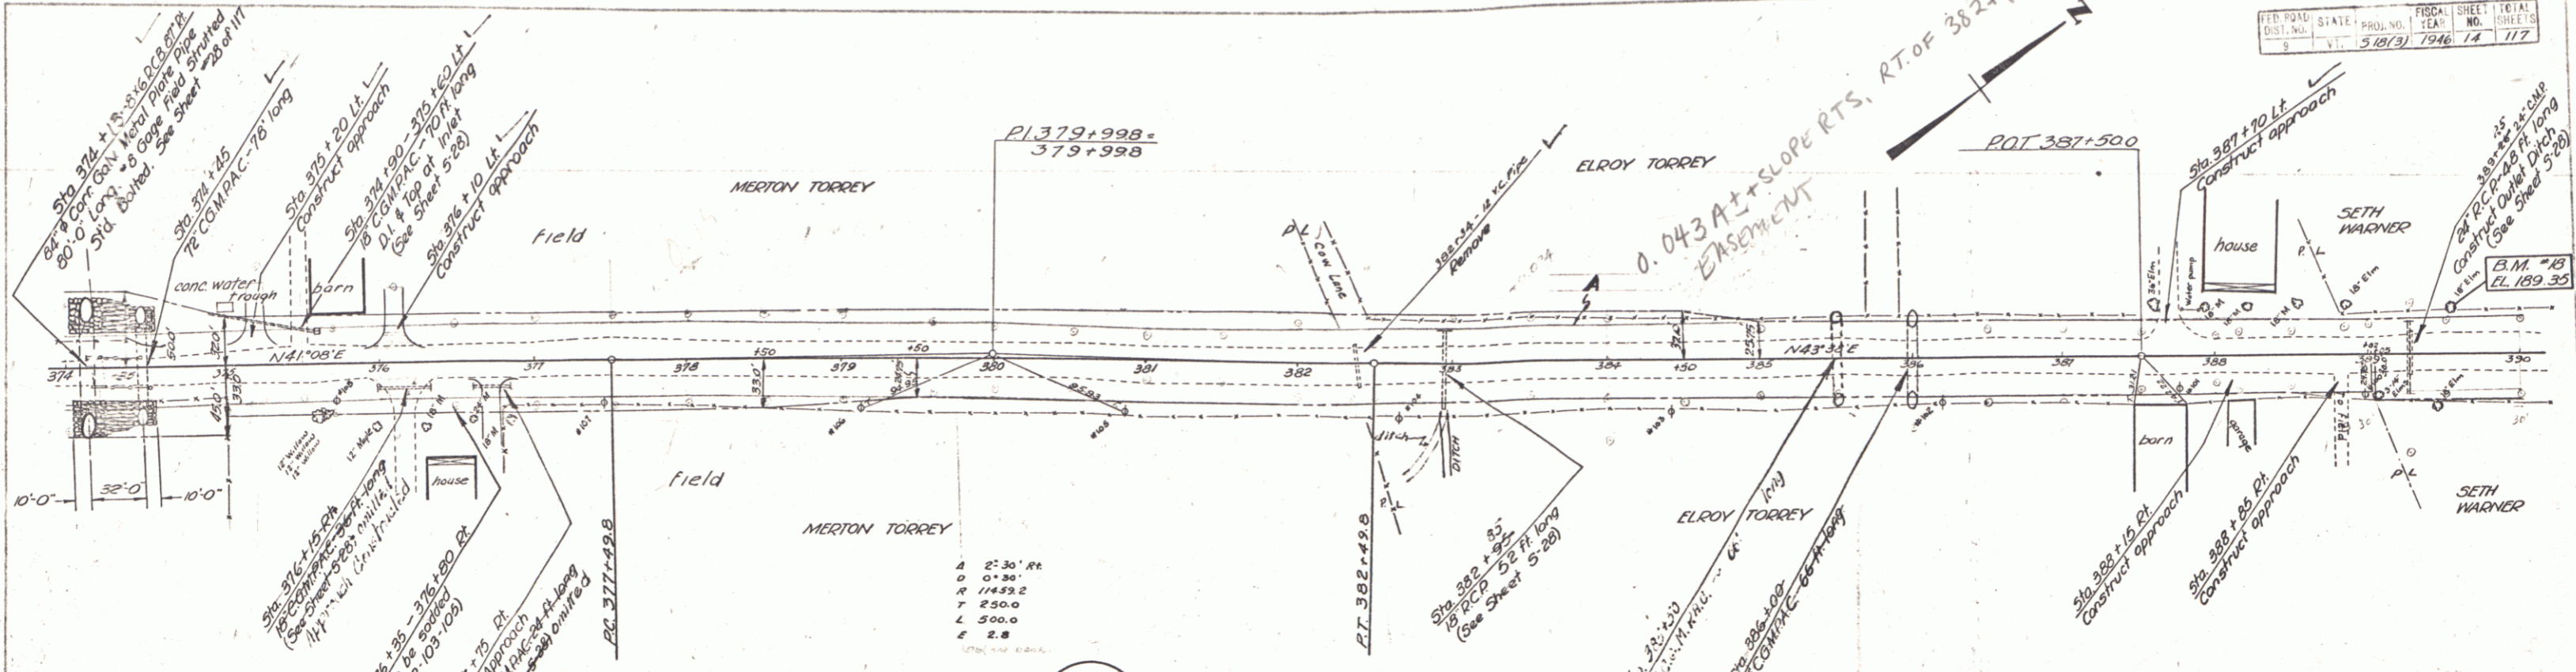

Scale: 1" = 40'
 Traced
 11/45

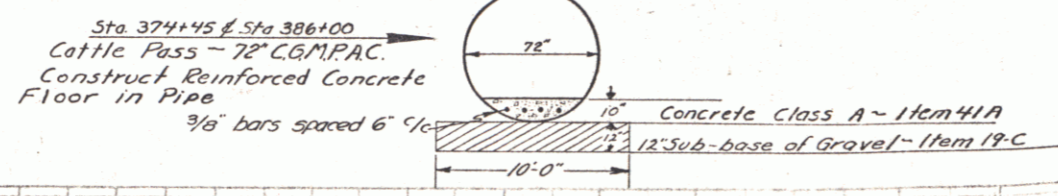


PARCEL	INSTRUMENT	DATE	GRANTOR	GRANTEE	RECORDED ADDITION BOOK PAGE DATE	REMARKS
A	W.D.O.E.	10-10-46	ELROY TORREY	ST. OF VT.	29 264-265 10-19-46	

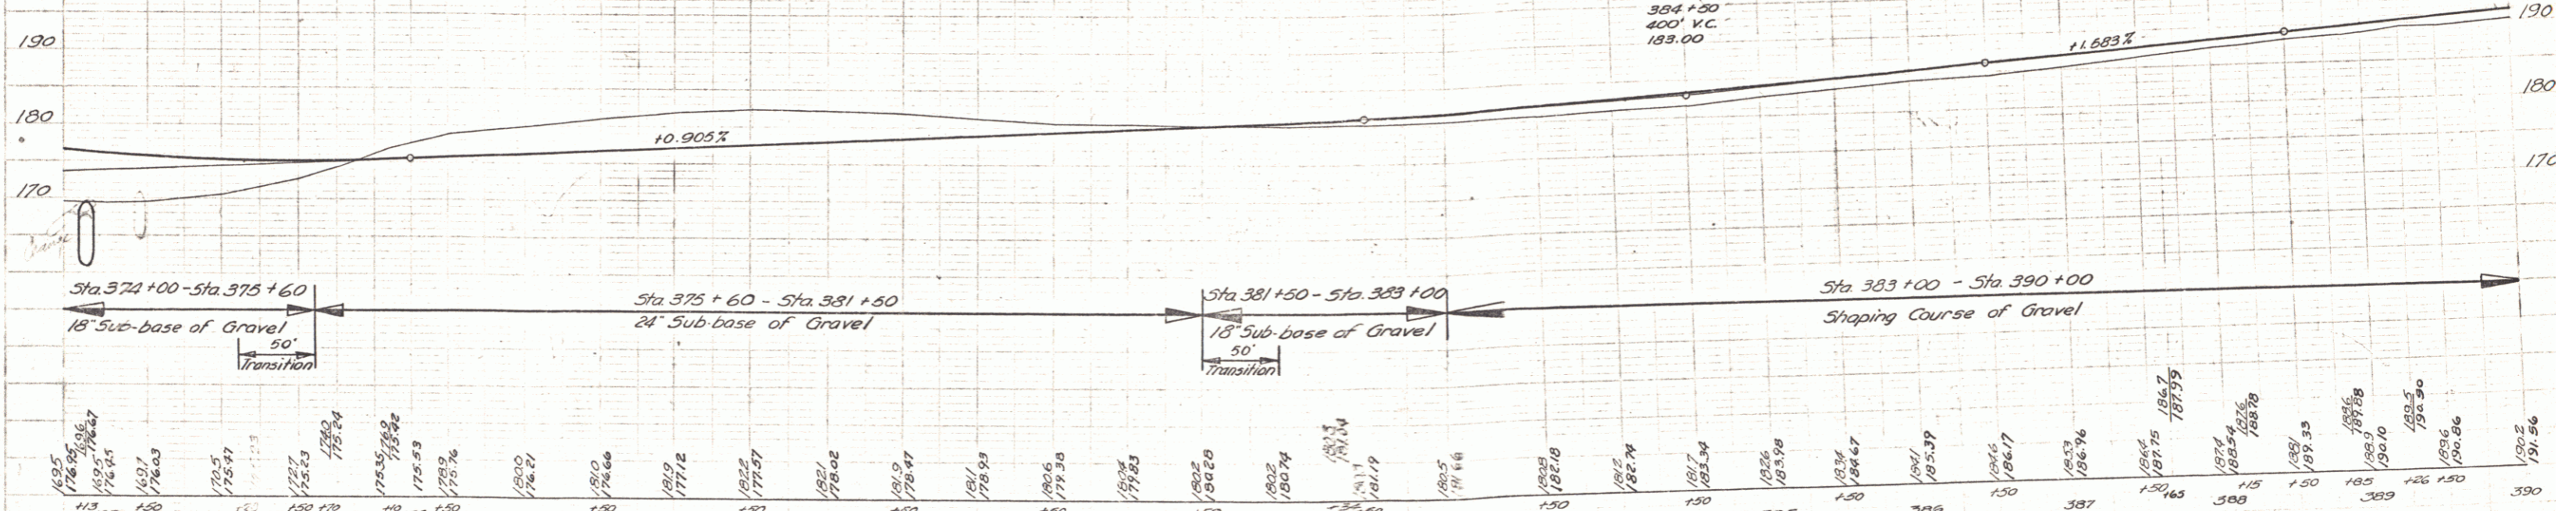

B.M. #18 El. 189.35 S.I.R. 18' Elm 27 ft Lt. Sta 389+52


Bridport-Addison series 5 no 18(3) sheet 14 of 117 sheets

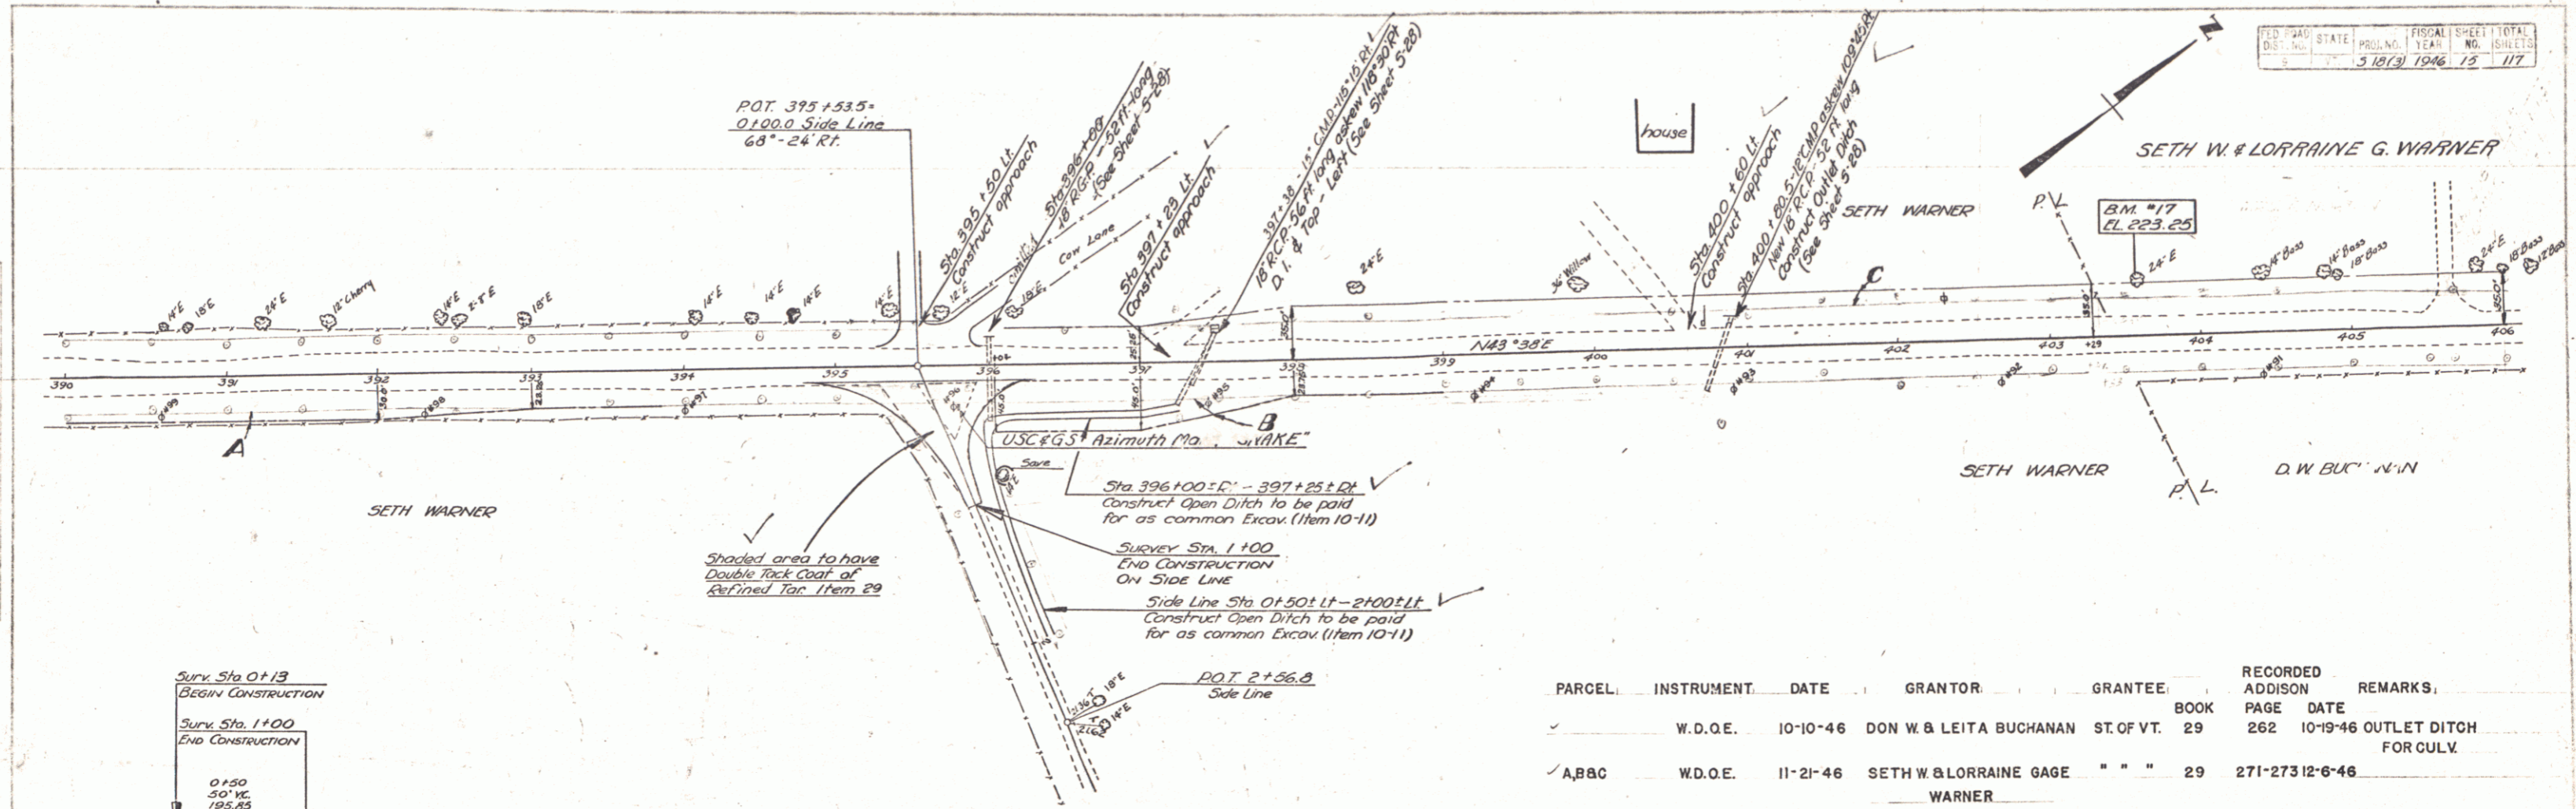

11-45
 12-45
 12-45
 Traced

11-45
 12-45
 12-45
 Traced

PARCEL	INSTRUMENT	DATE	GRANTOR	GRANTEE	BOOK	RECORDED ADDITION PAGE DATE	REMARKS
✓	W.D.O.E.	10-10-46	DON W. & LEITA BUCHANAN	ST. OF VT.	29	262 10-19-46	OUTLET DITCH FOR CULV.
✓ A,B,C	W.D.O.E.	11-21-46	SETH W. & LORRAINE GAGE WARNER	" "	29	271-273 12-6-46	


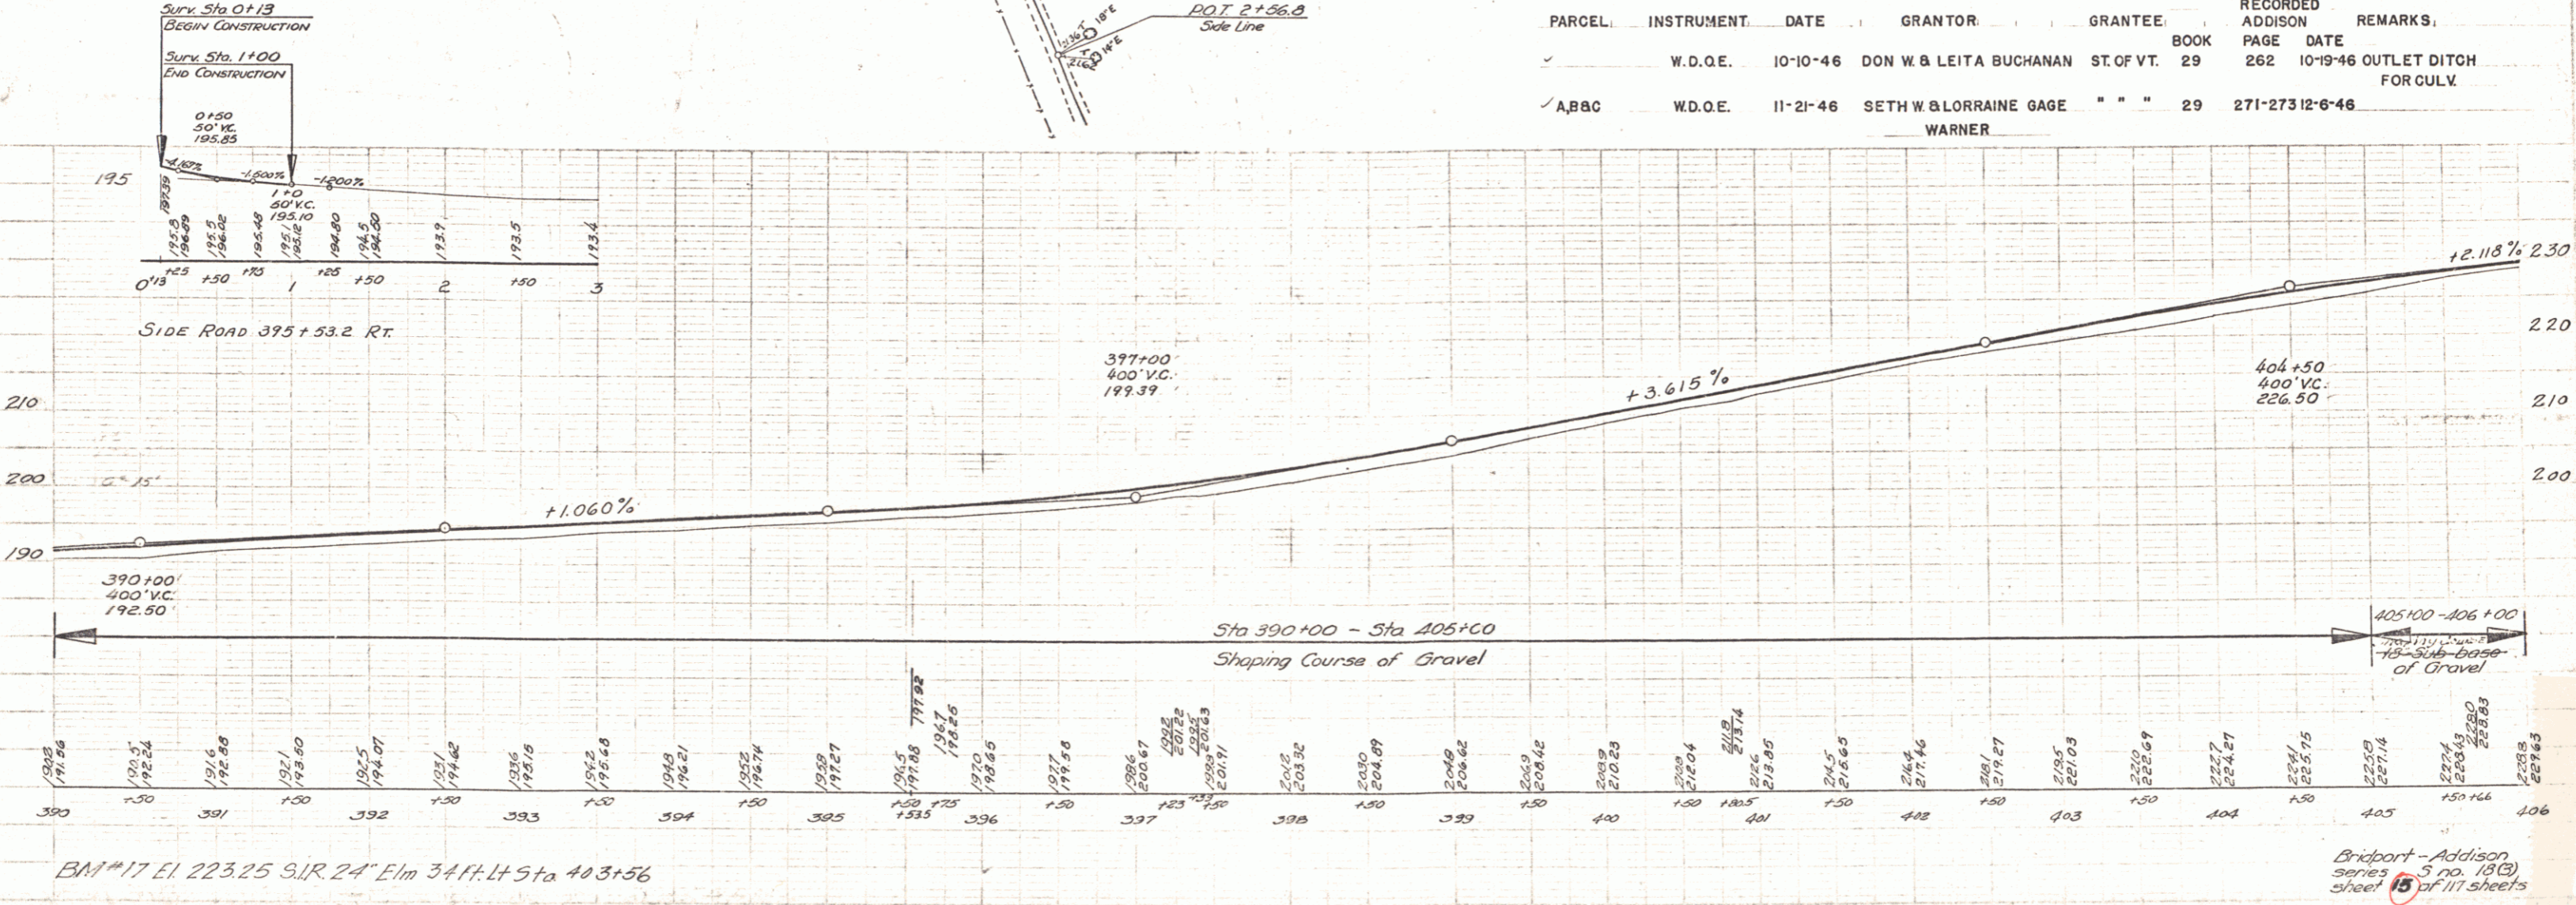


BM #17 El. 223.25 S.I.R. 24" Elm 3 1/2" Lt Sta 403+56


Bridport - Addison Series 5 no. 18(3) sheet 13 of 117 sheets

PLAN: Sponning Lamm 12-45
 12-45
 12-45
 12-45


Profile: Sponning Lamm 12-45
 12-45
 12-45
 12-45

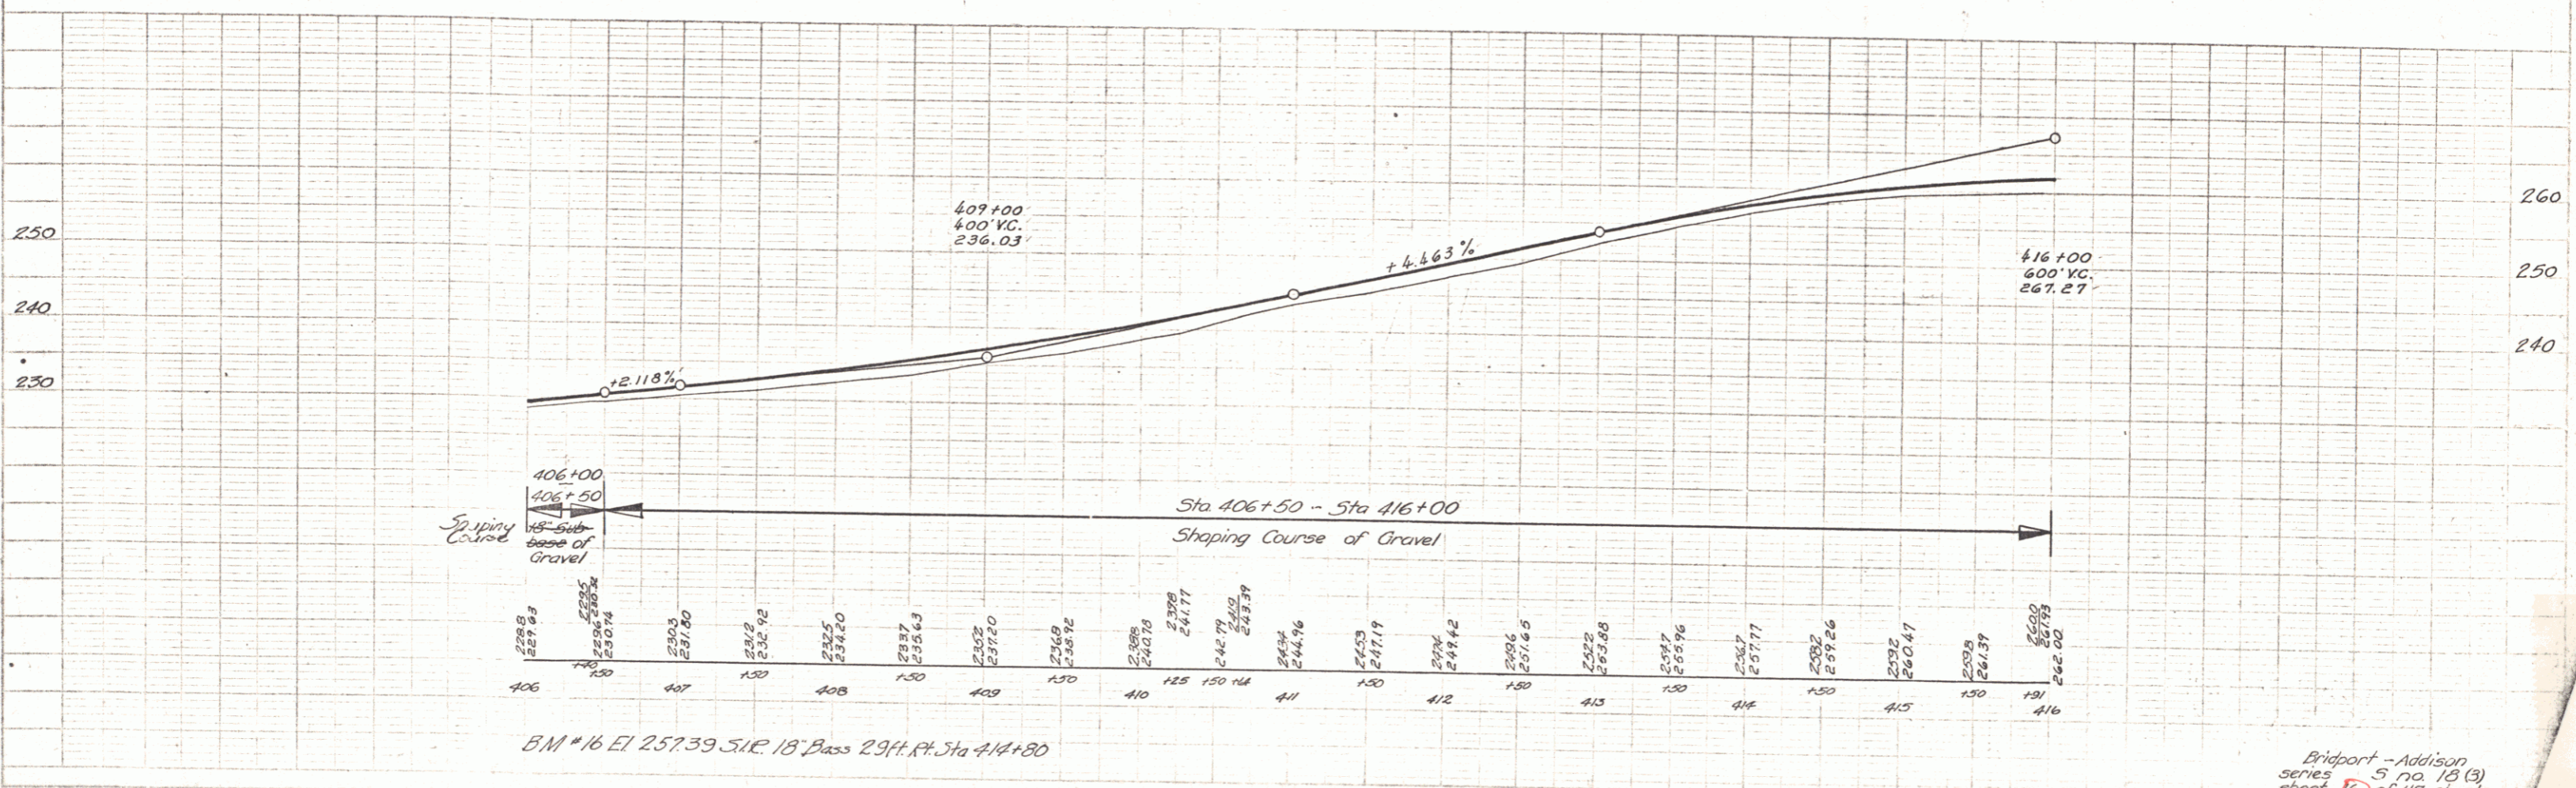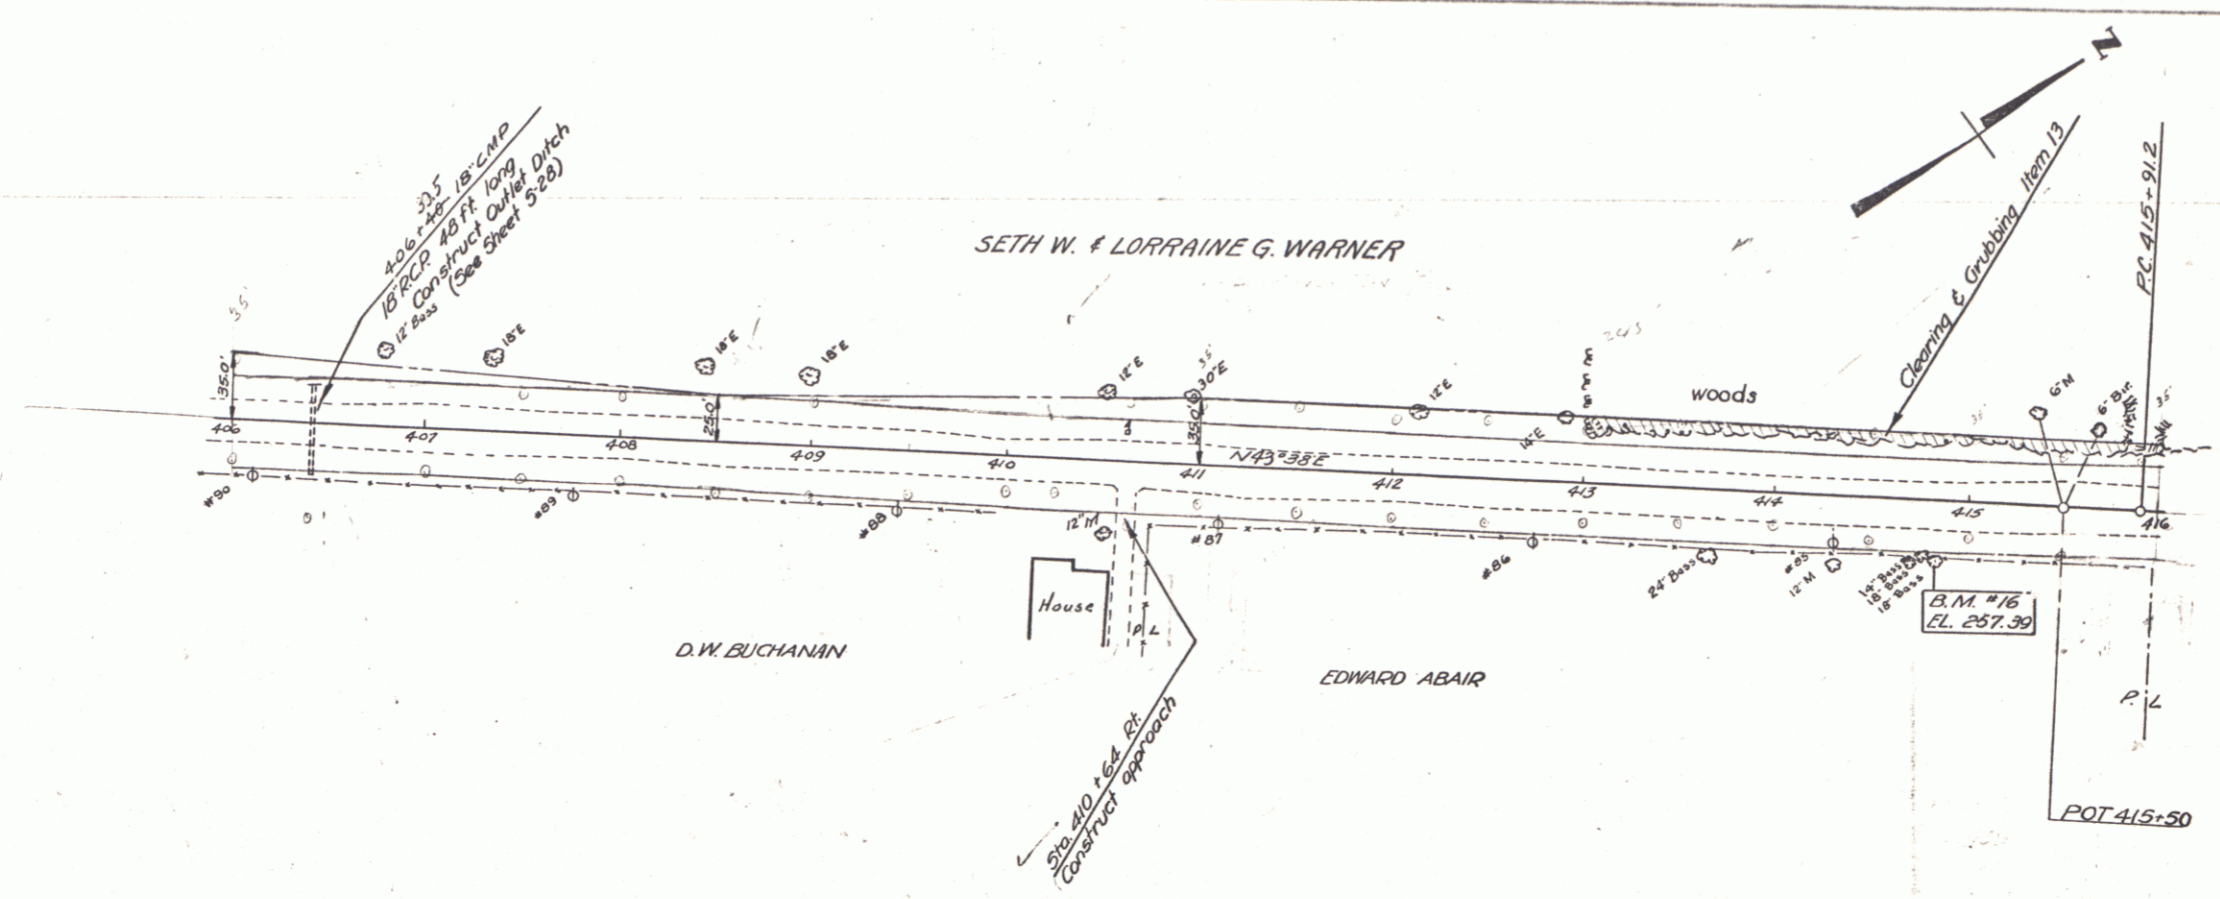

BM #16 El 257.39 Sta. 18' Pass 29' Rt. Sta. 414+80

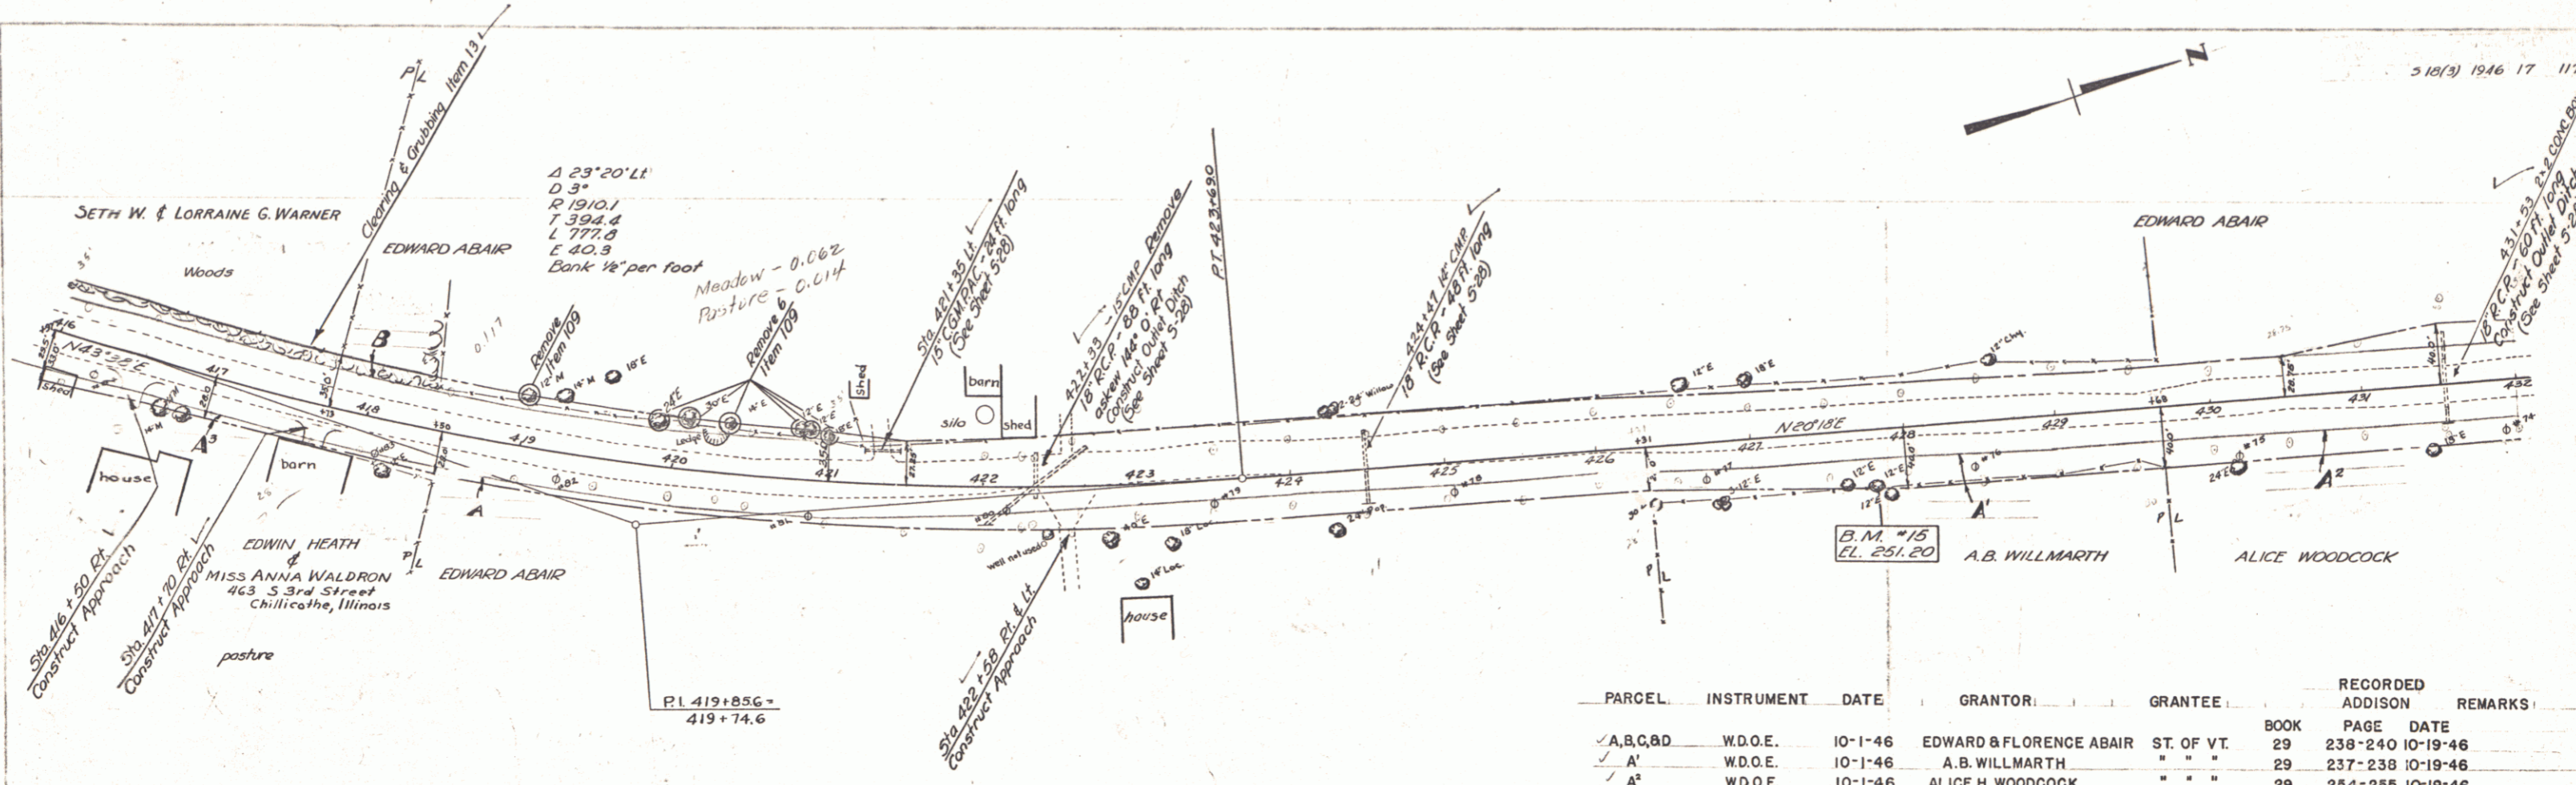

PARCEL	INSTRUMENT	DATE	GRANTOR	GRANTEE	RECORDED ADDISON	BOOK	PAGE	DATE	REMARKS
✓ A,B,C,D	W.D.O.E.	10-1-46	EDWARD & FLORENCE ABAIR	ST. OF VT.		29	238-240	10-19-46	
✓ A'	W.D.O.E.	10-1-46	A.B. WILLMARTH	" " "		29	237-238	10-19-46	
✓ A ²	W.D.O.E.	10-1-46	ALICE H. WOODCOCK	" " "		29	254-255	10-19-46	
A ³	W.D.O.E.	12-19-46	ANNA WALDRON & CLAYTON HEATH	" " "		29	279	1-3-47	

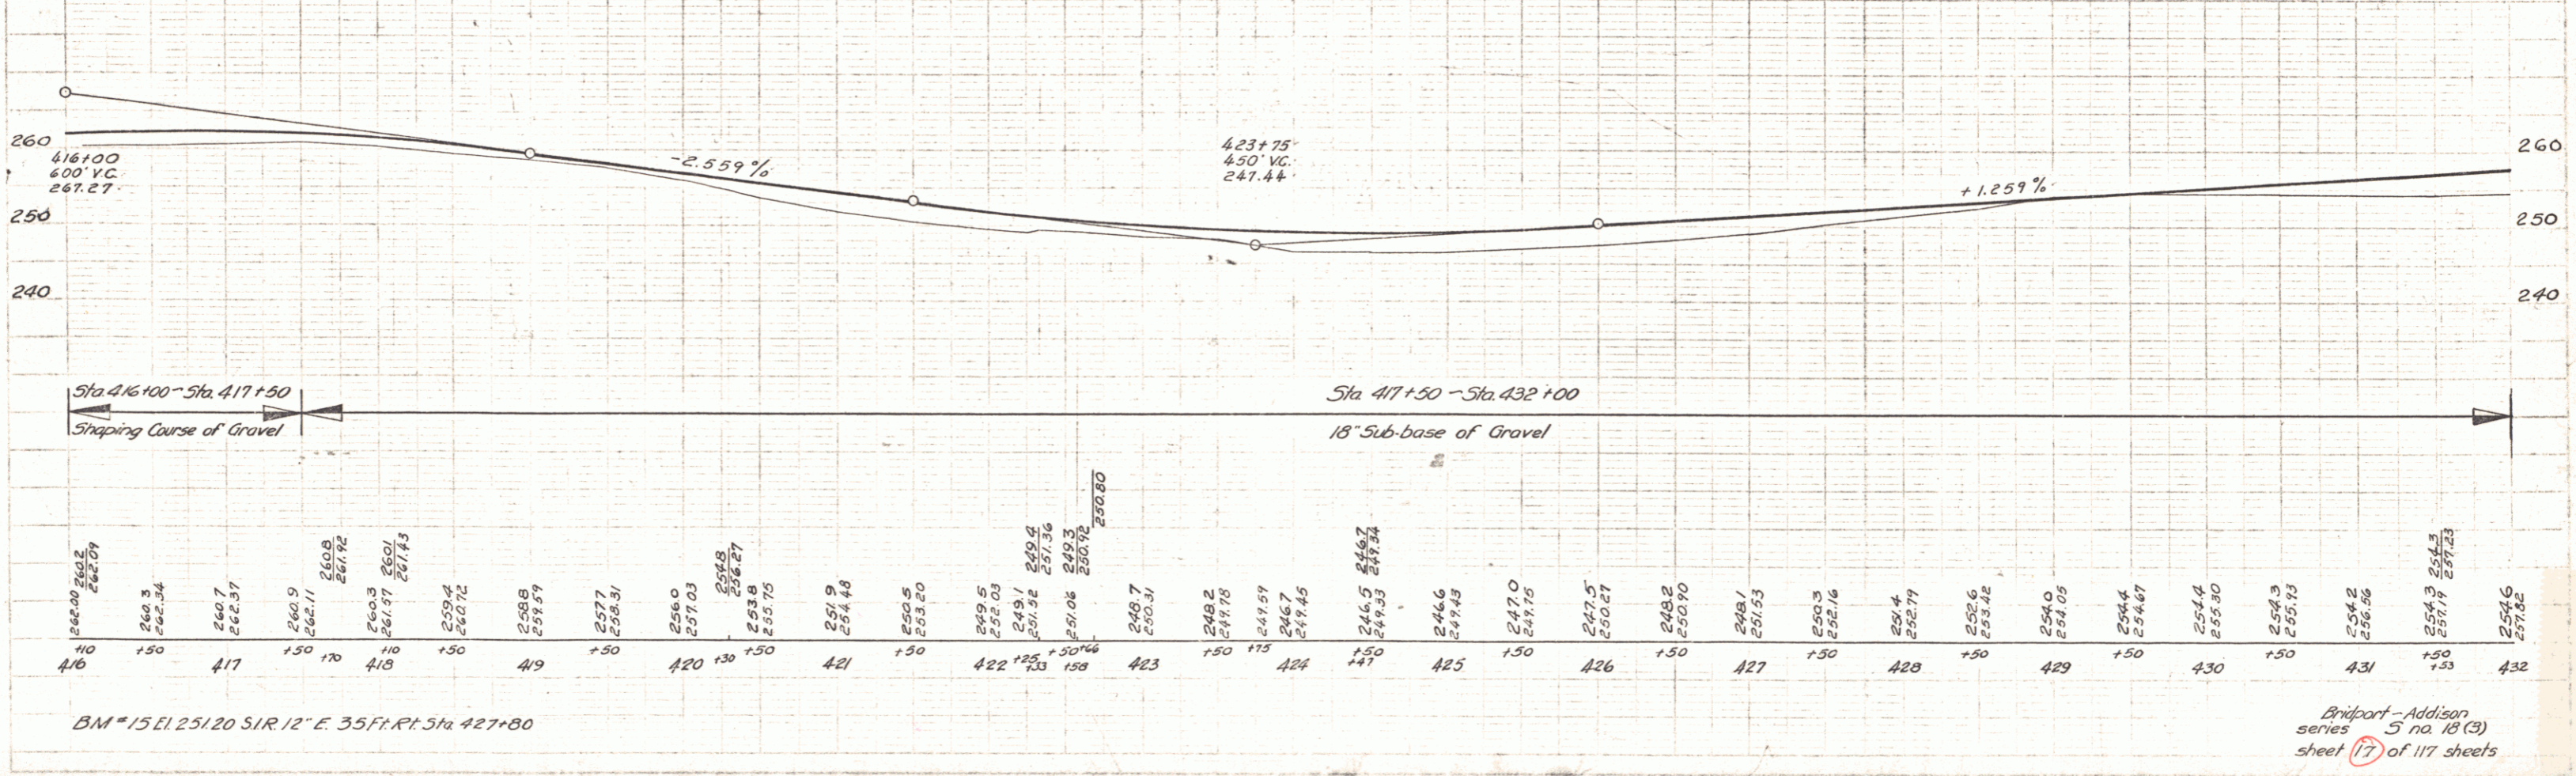



BM #15 E.L. 251.20 S.I.R. 12" E. 35 Ft. Rt. Sta 427+80

Bridport-Addison series 5 no. 18 (3) sheet 17 of 117 sheets

PARCEL	INSTRUMENT	DATE	GRANTOR	GRANTEE	RECORDED ADDITION	REMARKS
✓ A	W.D.O.E.	10-1-46	GAYLE & LAURA B. PUTNAM	ST. OF VT.	BOOK 29	PAGE 258-259 10-19-46
✓	W.D.O.E.	10-10-46	DOROTHY WINTERS	" " "	29	260-261 10-19-46 CULV. DITCH

A 0°-47' Lt
 D 0-15'
 R-229/18.3
 T-156.3
 L 313.3
 E 2.1

518(3) 1946 18 117

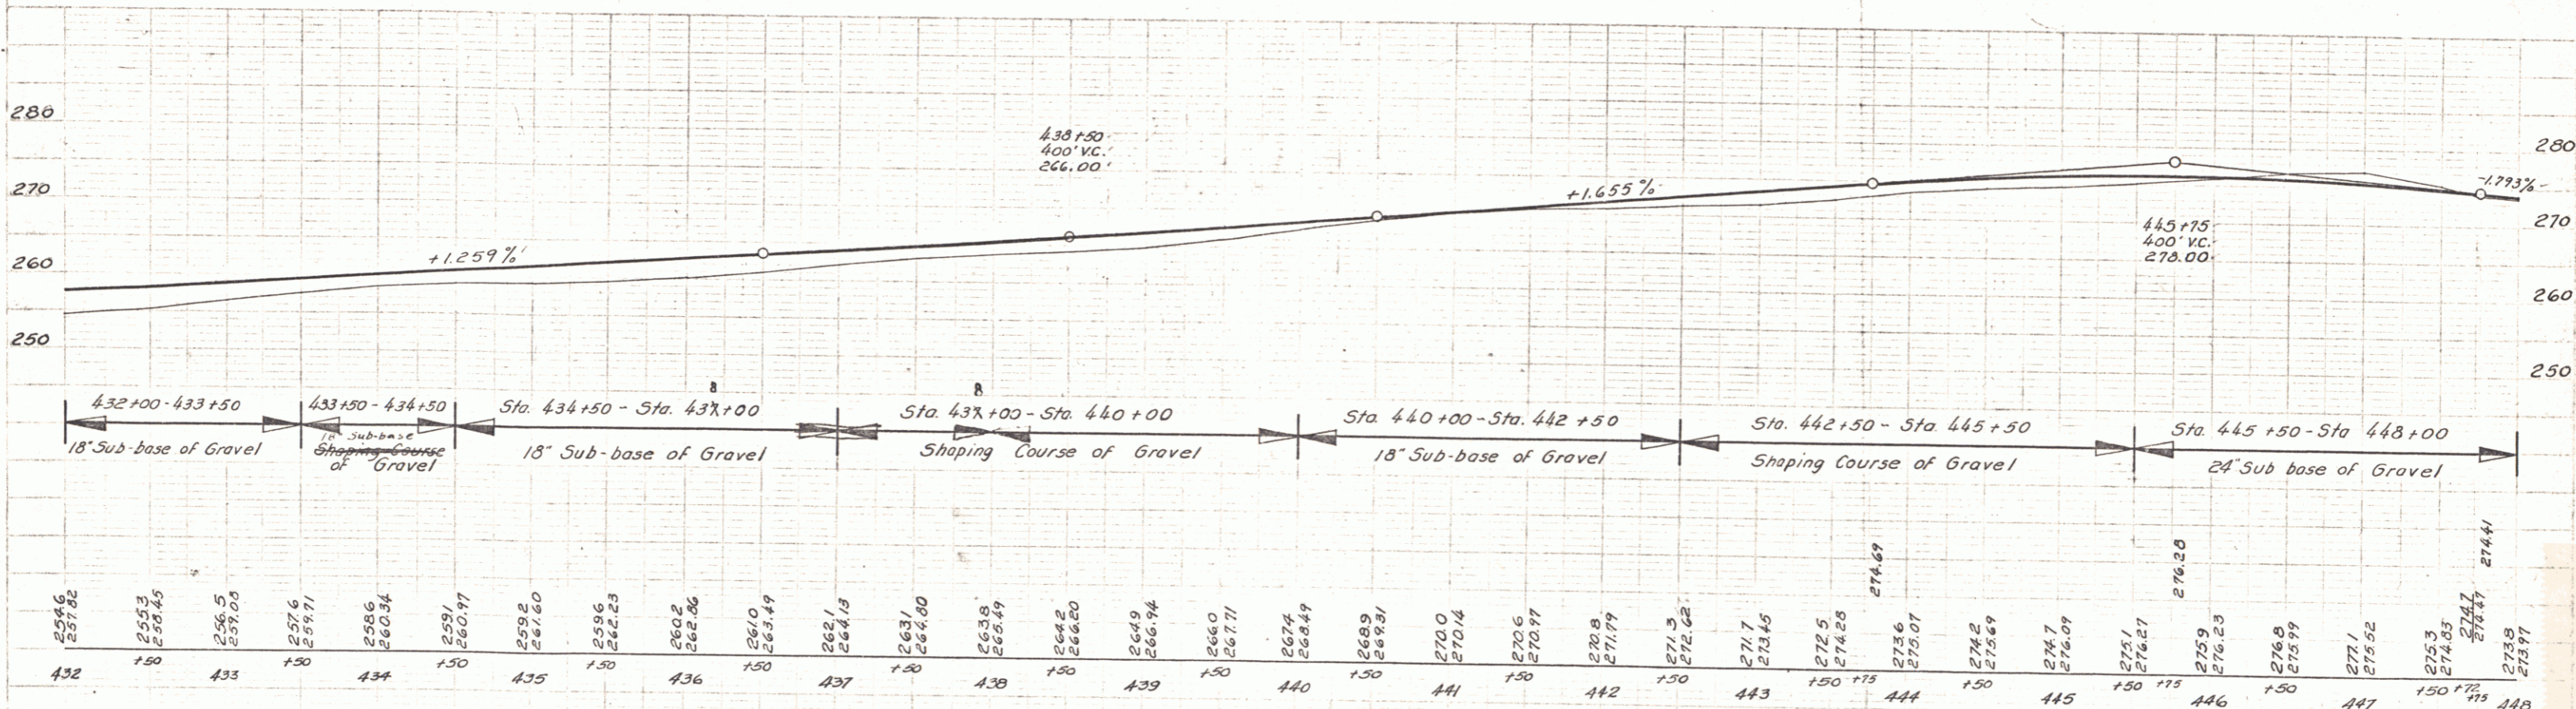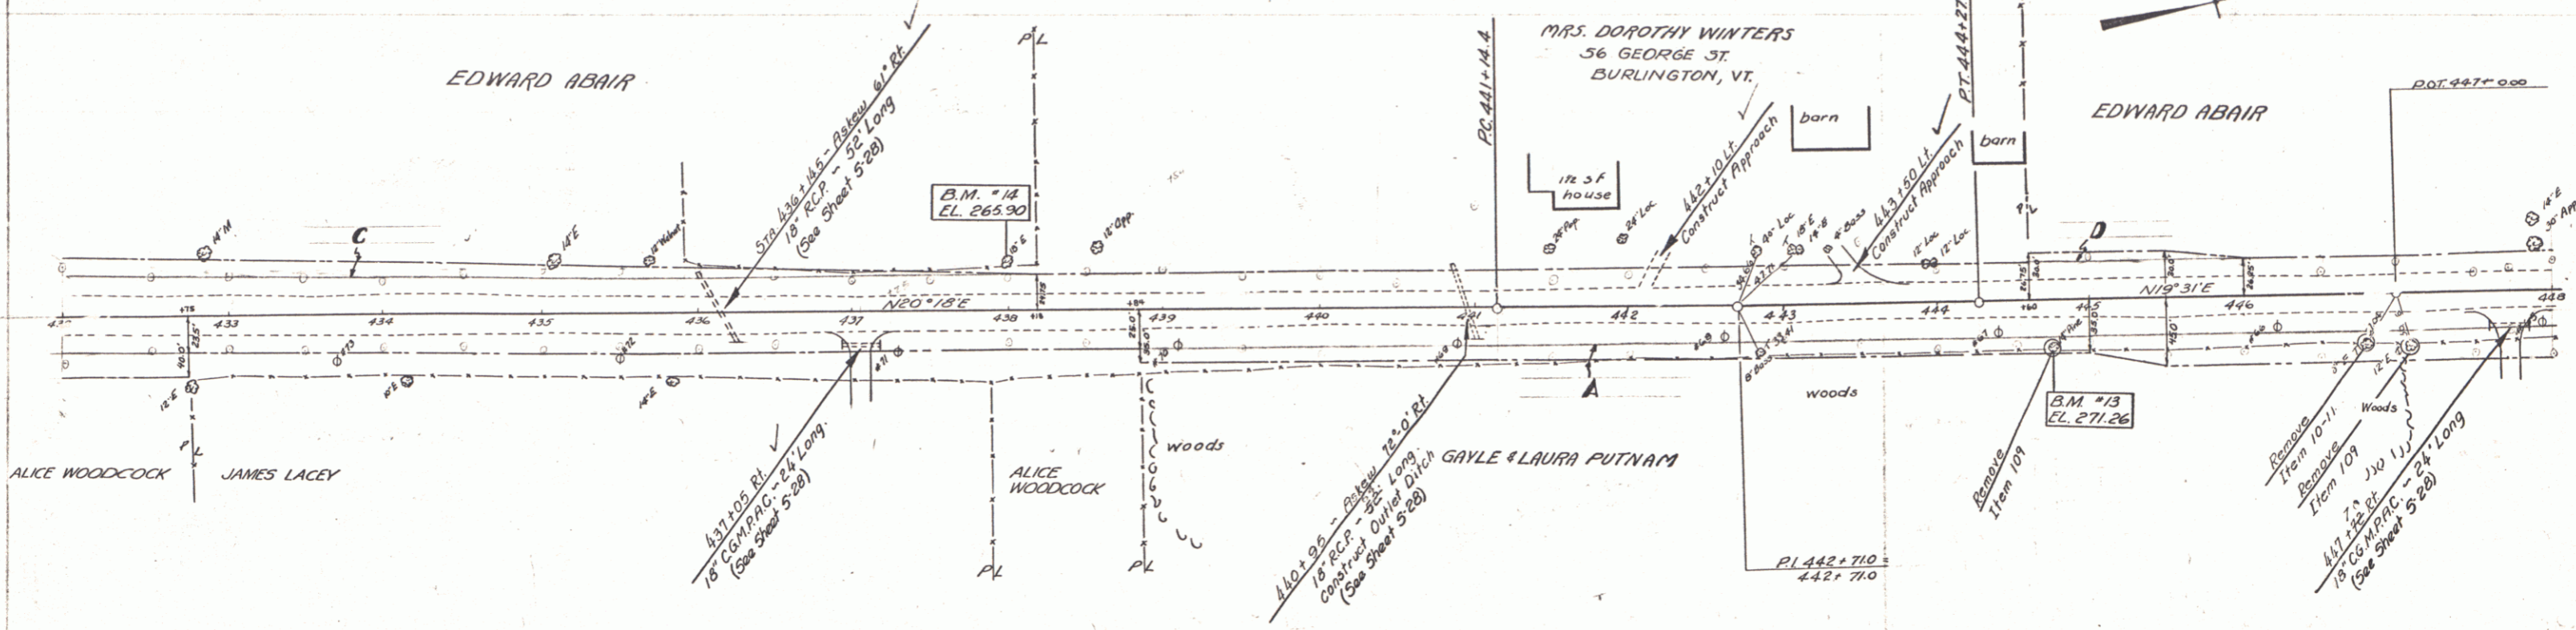


BM # 13 El. 271.26 S.I.R. 18" Pine 28 Ft. Rt. Sta. 444+60
 BM # 14 El. 265.90 S.I.R. 18" E. 28 Ft. Lt. Sta. 436+99

Bridport - Addison
 Series 5 No. 18(3)
 Sheet 10 of 117 sheets

PARCEL	INSTRUMENT	DATE	GRANTOR	GRANTEE	RECORDED	REMARKS	
					ADDITION		
					BOOK	PAGE	
					DATE		
✓ A'	W.D.O.E.	10-1-46	LESLIE F. & DOROTHY E. GUY	ST. OF VT.	29	256-257	10-19-46

518(3) 1946 19 117


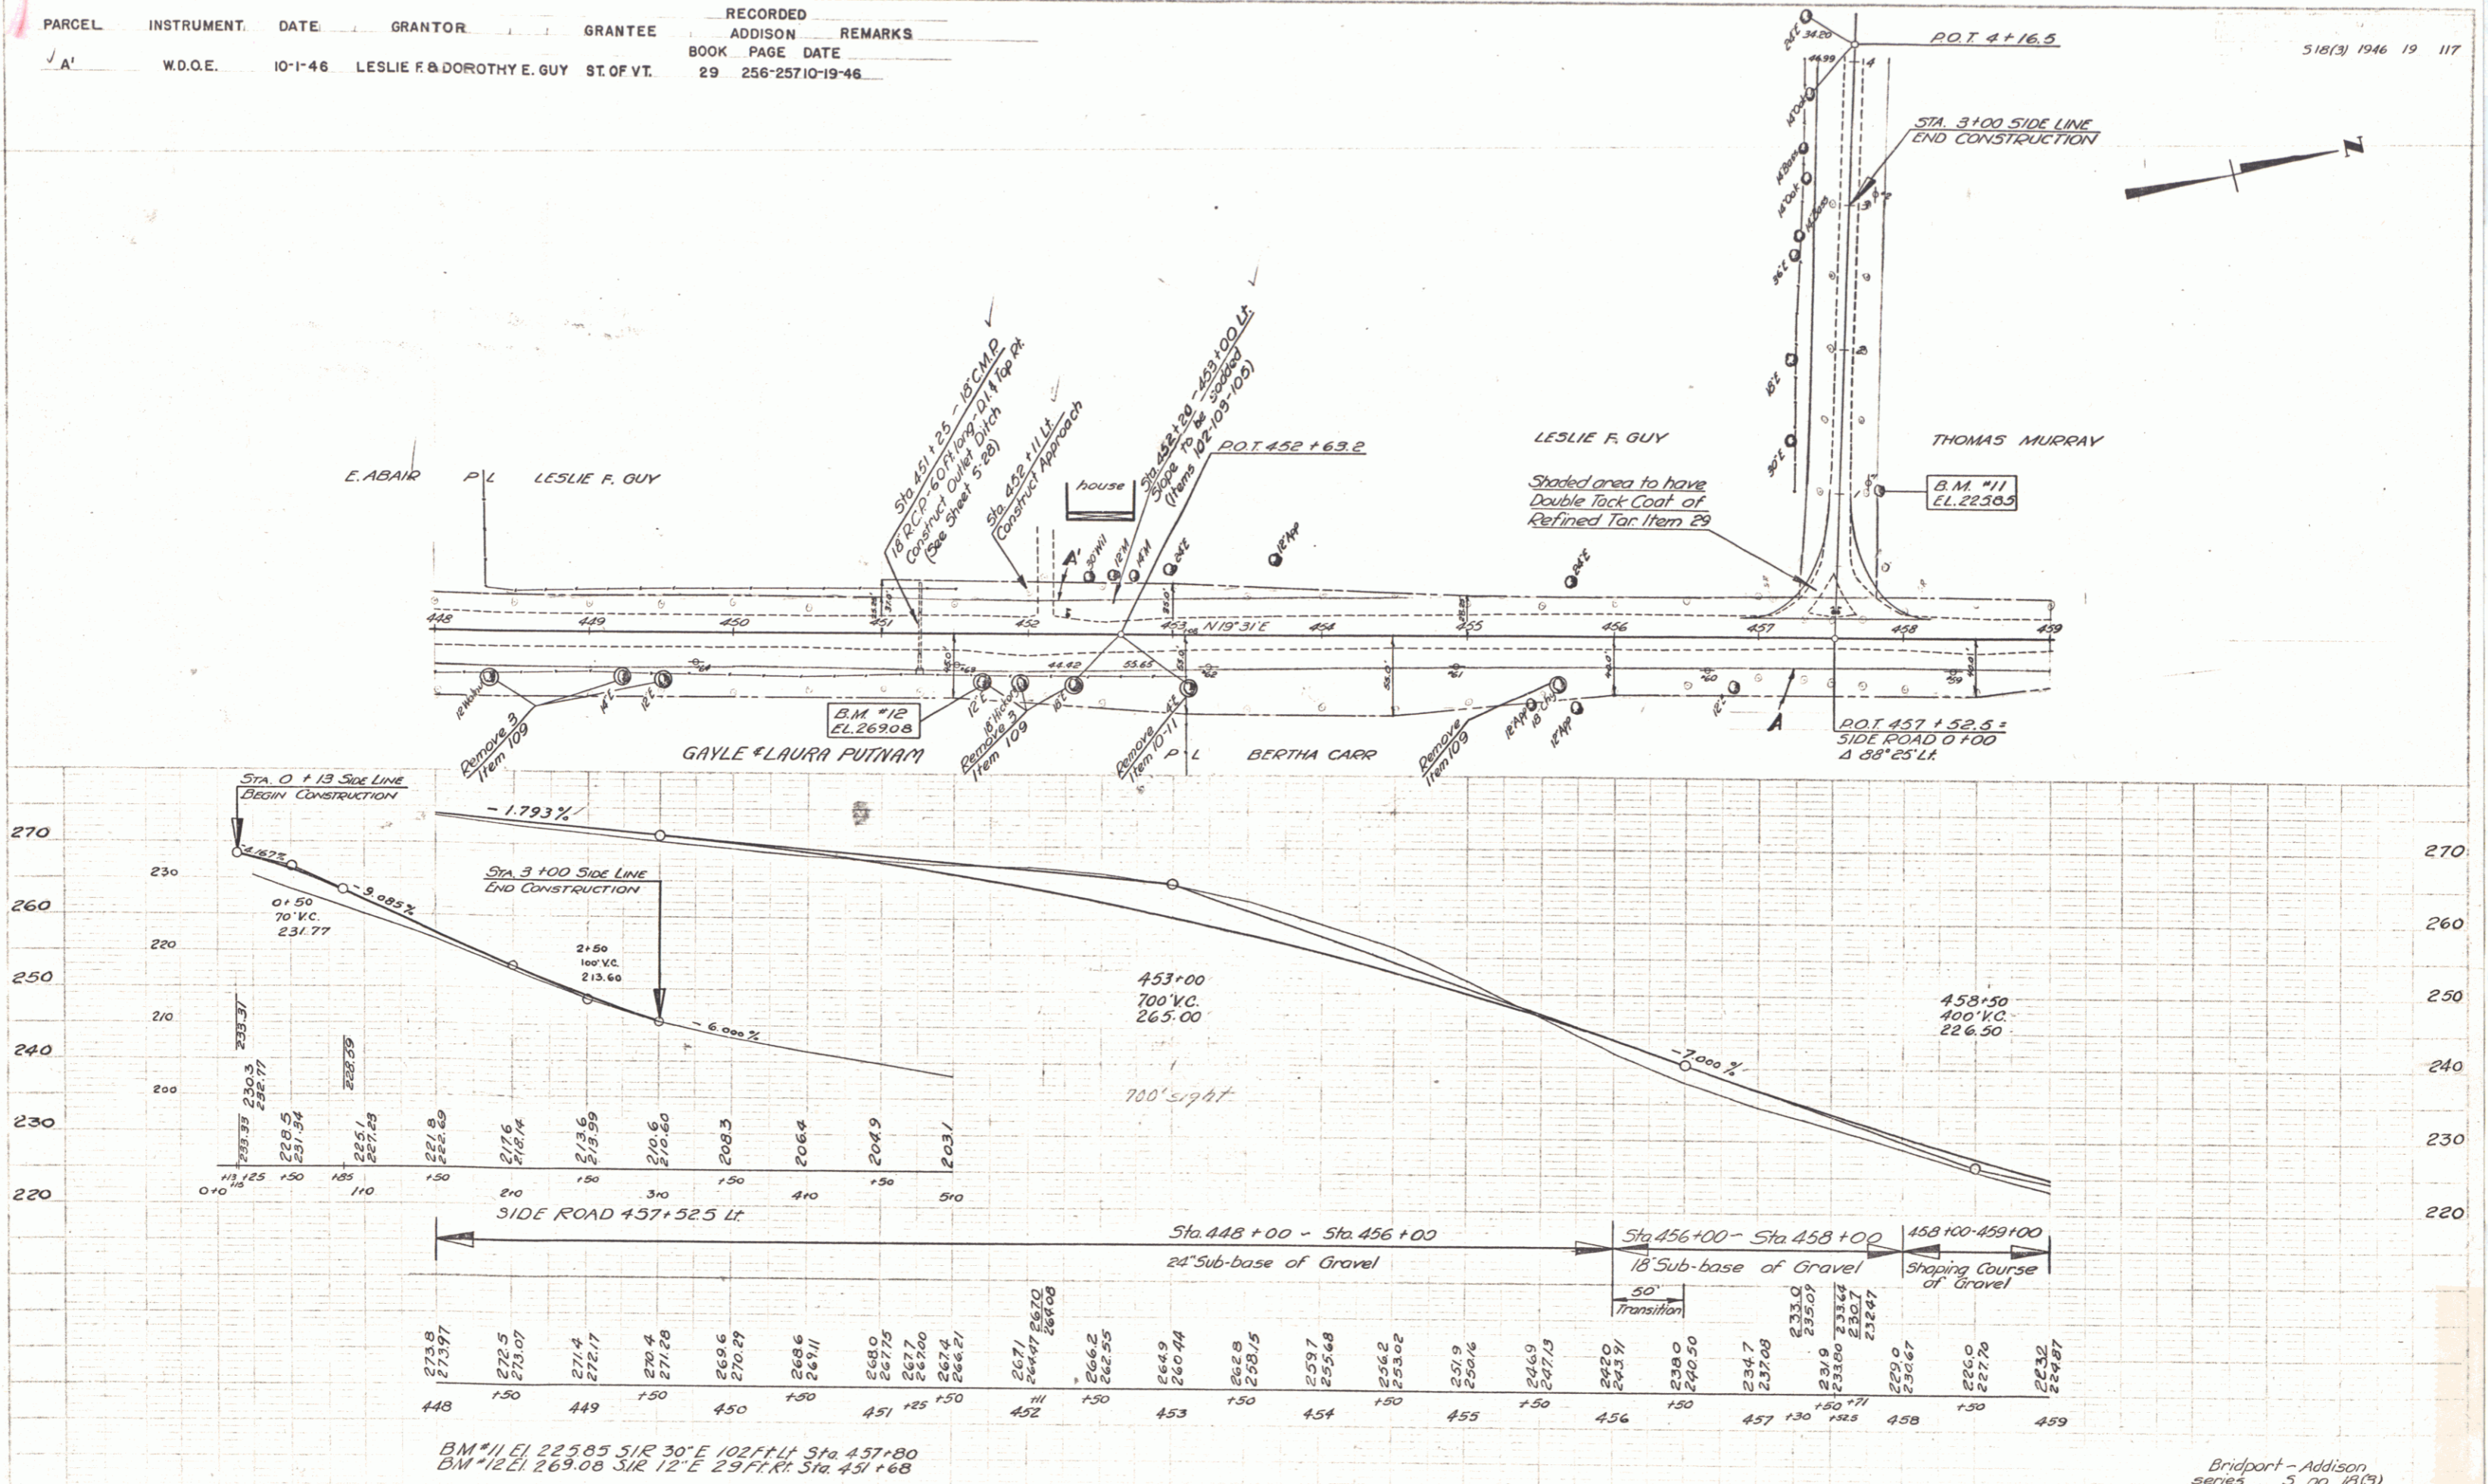


B.M. #11 EL 225.85 S1R 30° E 102 FT Lt Sta. 457+80
 B.M. #12 EL 269.08 S1R 12° E 29 FT Rt Sta. 451+68

Bridport - Addison
 series 5 no. 15(3)
 sheet 19 of 117 sheets

Spanning
 11-45
 12-45
 12-46



PARCEL	INSTRUMENT	DATE	GRANTOR	GRANTEE	RECORDED	ADDITION	REMARKS
✓ ABB	W.D.Q.E.	10-1-46	BERTHA P CARR		BOOK	PAGE	DATE
✓ A'B'	W.D.Q.E.	10-1-46	THOS.E. BLUCIENNE MURRAY	ST.OF VT.	29	253-254	10-19-46
✓ A"	W.D.Q.E.	10-1-46	SEWARD SMITH	" " "	29	249-250	10-19-46
					29	245-246	10-19-46

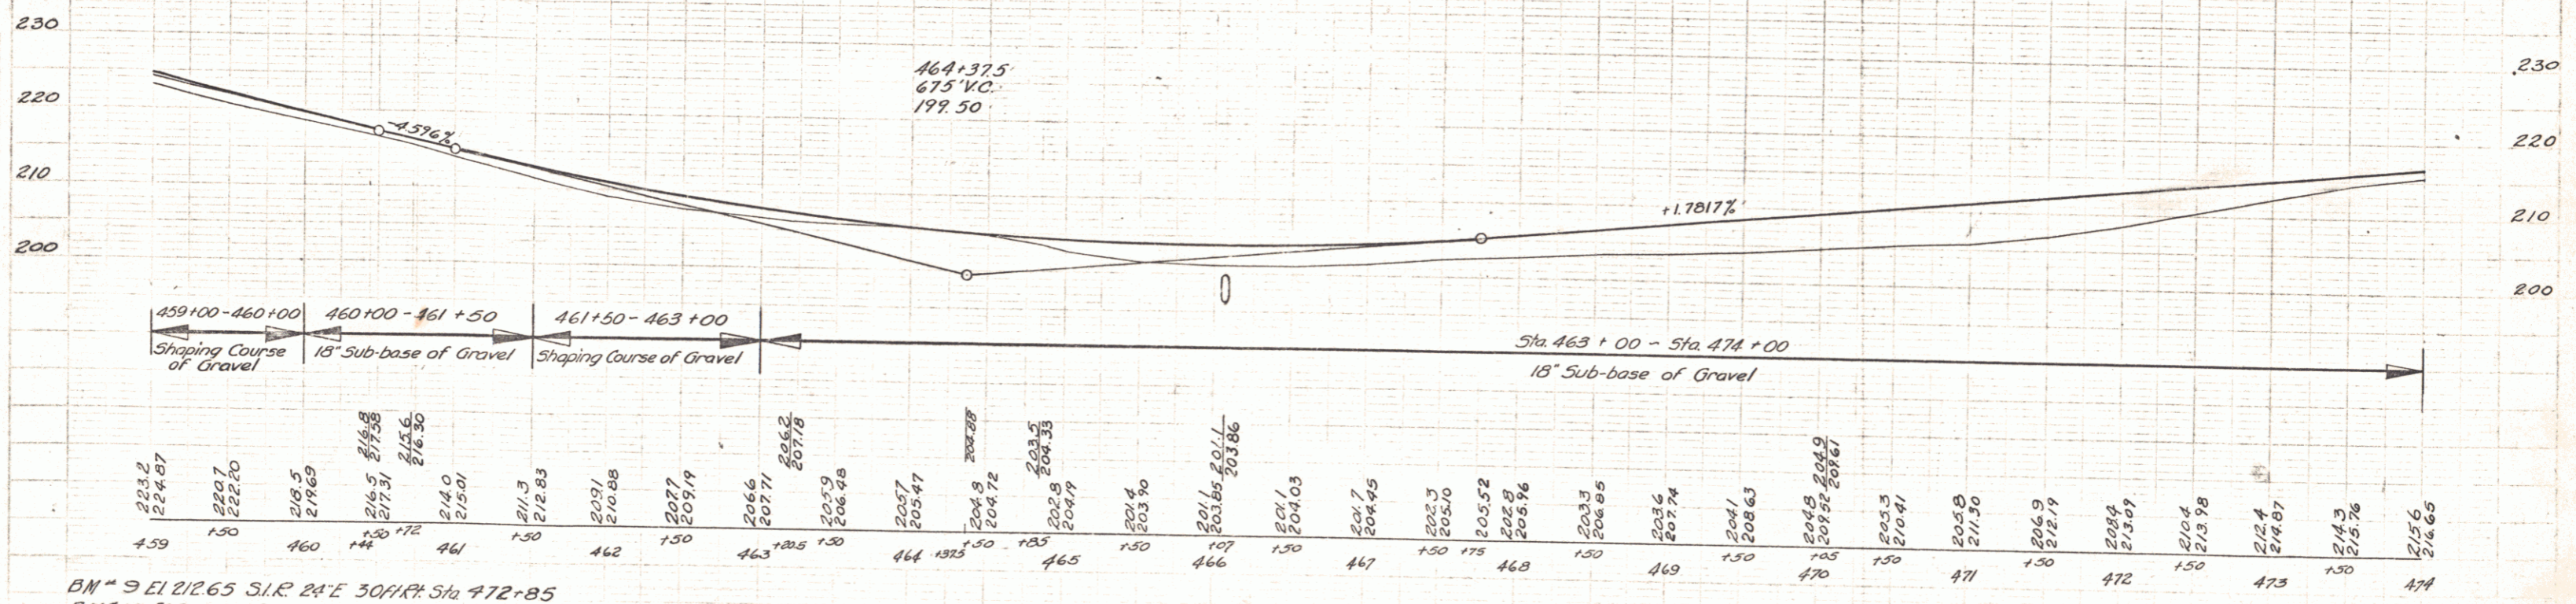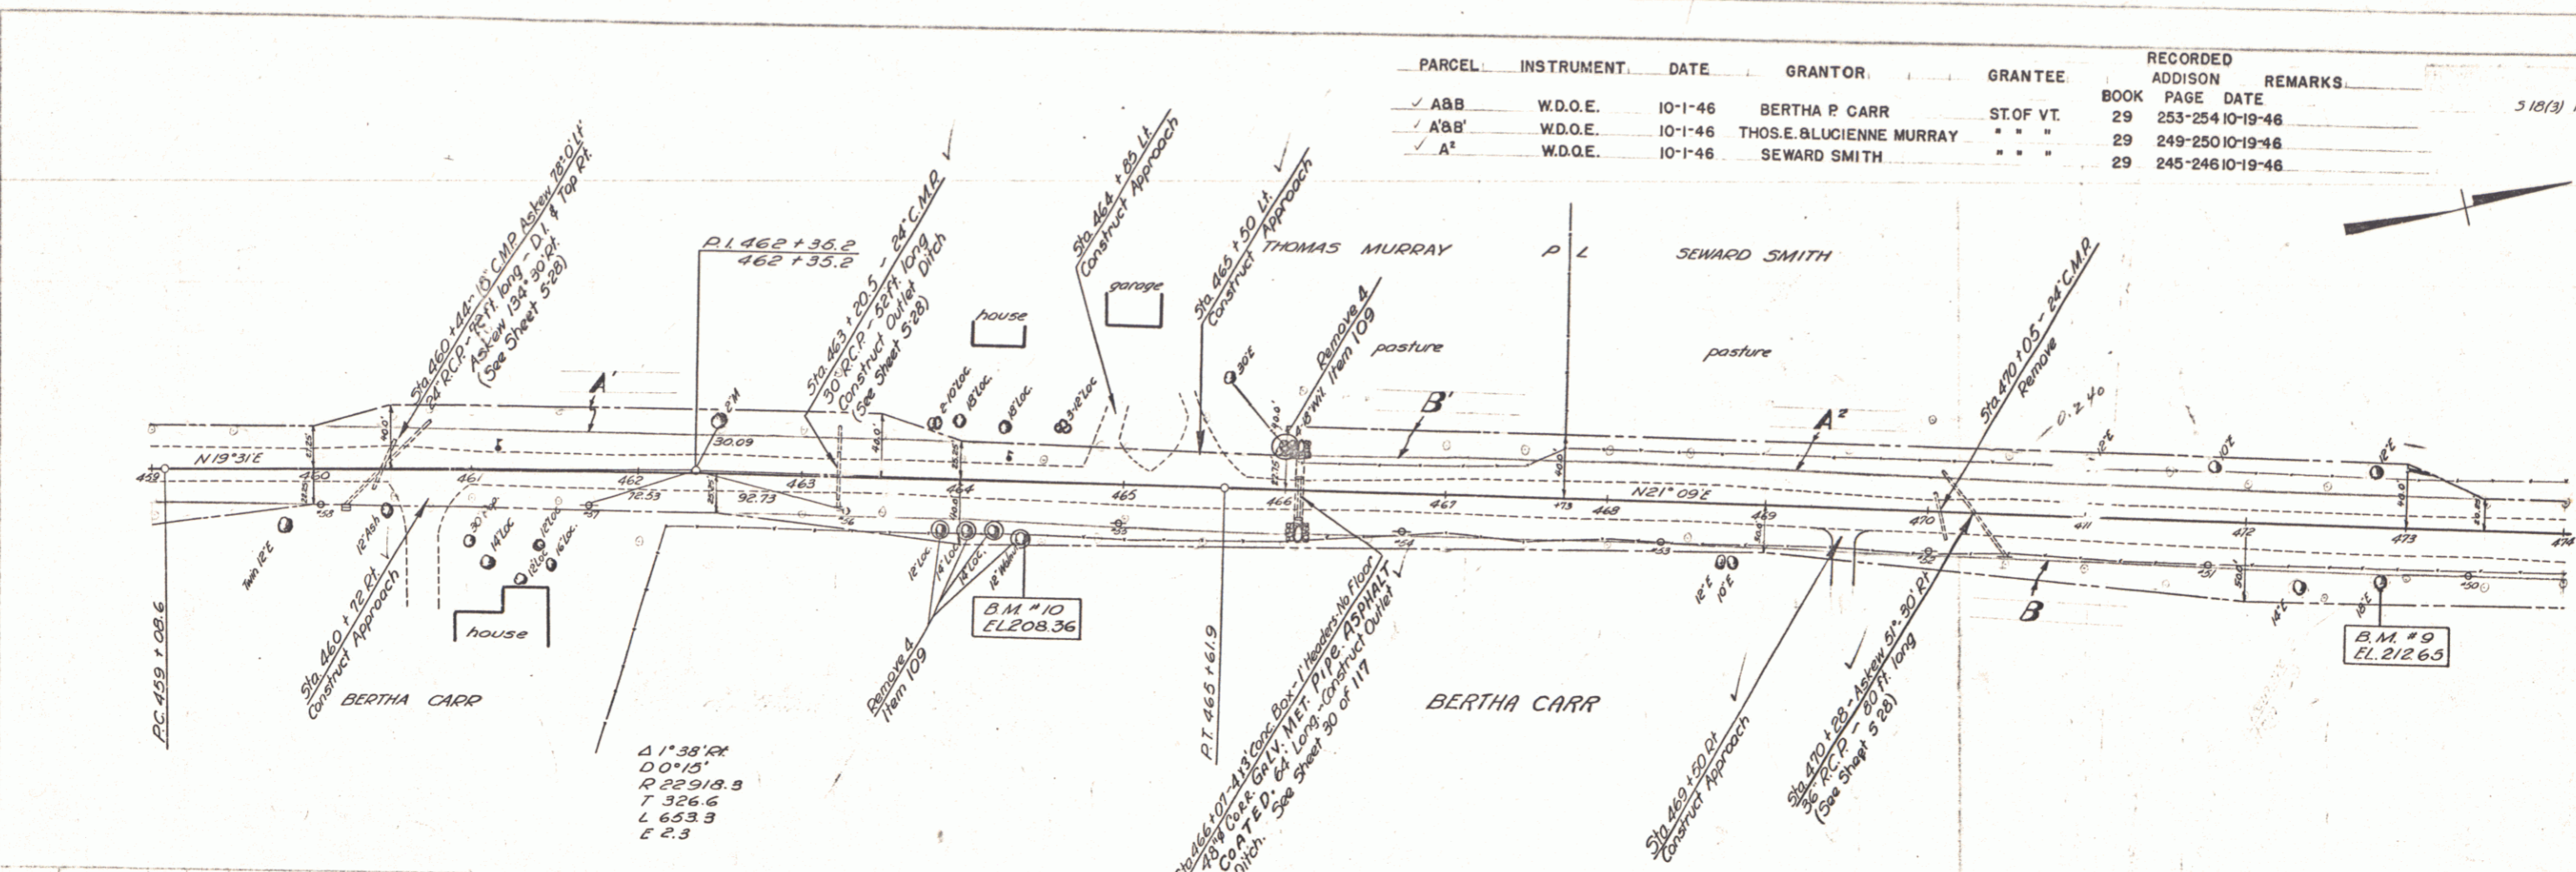

B.M. #9 EL 212.65 S.I.R. 24'E 3071 FT Sta 472+85
 B.M. #10 EL 208.36 S.I.R. 14' Walnut 32 FT RT Sta 434+36



Bridgeport - Addison
 series 5 no. 18(3)
 sheet 20 of 117 sheets

PARCEL	INSTRUMENT	DATE	GRANTOR	GRANTEE	RECORDED ADDISON	REMARKS
A	W.D.O.E.	10-10-46	GEO. H. & HILDA E. GARNEAU	ST. OF VT	BOOK 29 PAGE 259-260	10-19-46
B	W.D.O.E.	10-10-46	LAWRENCE & CECILE GEVRY	" " "	29 267-269	10-19-46
	W.D.O.E.	10-10-46	LAWRENCE VINCENT	" " "	29 263-264	10-19-46

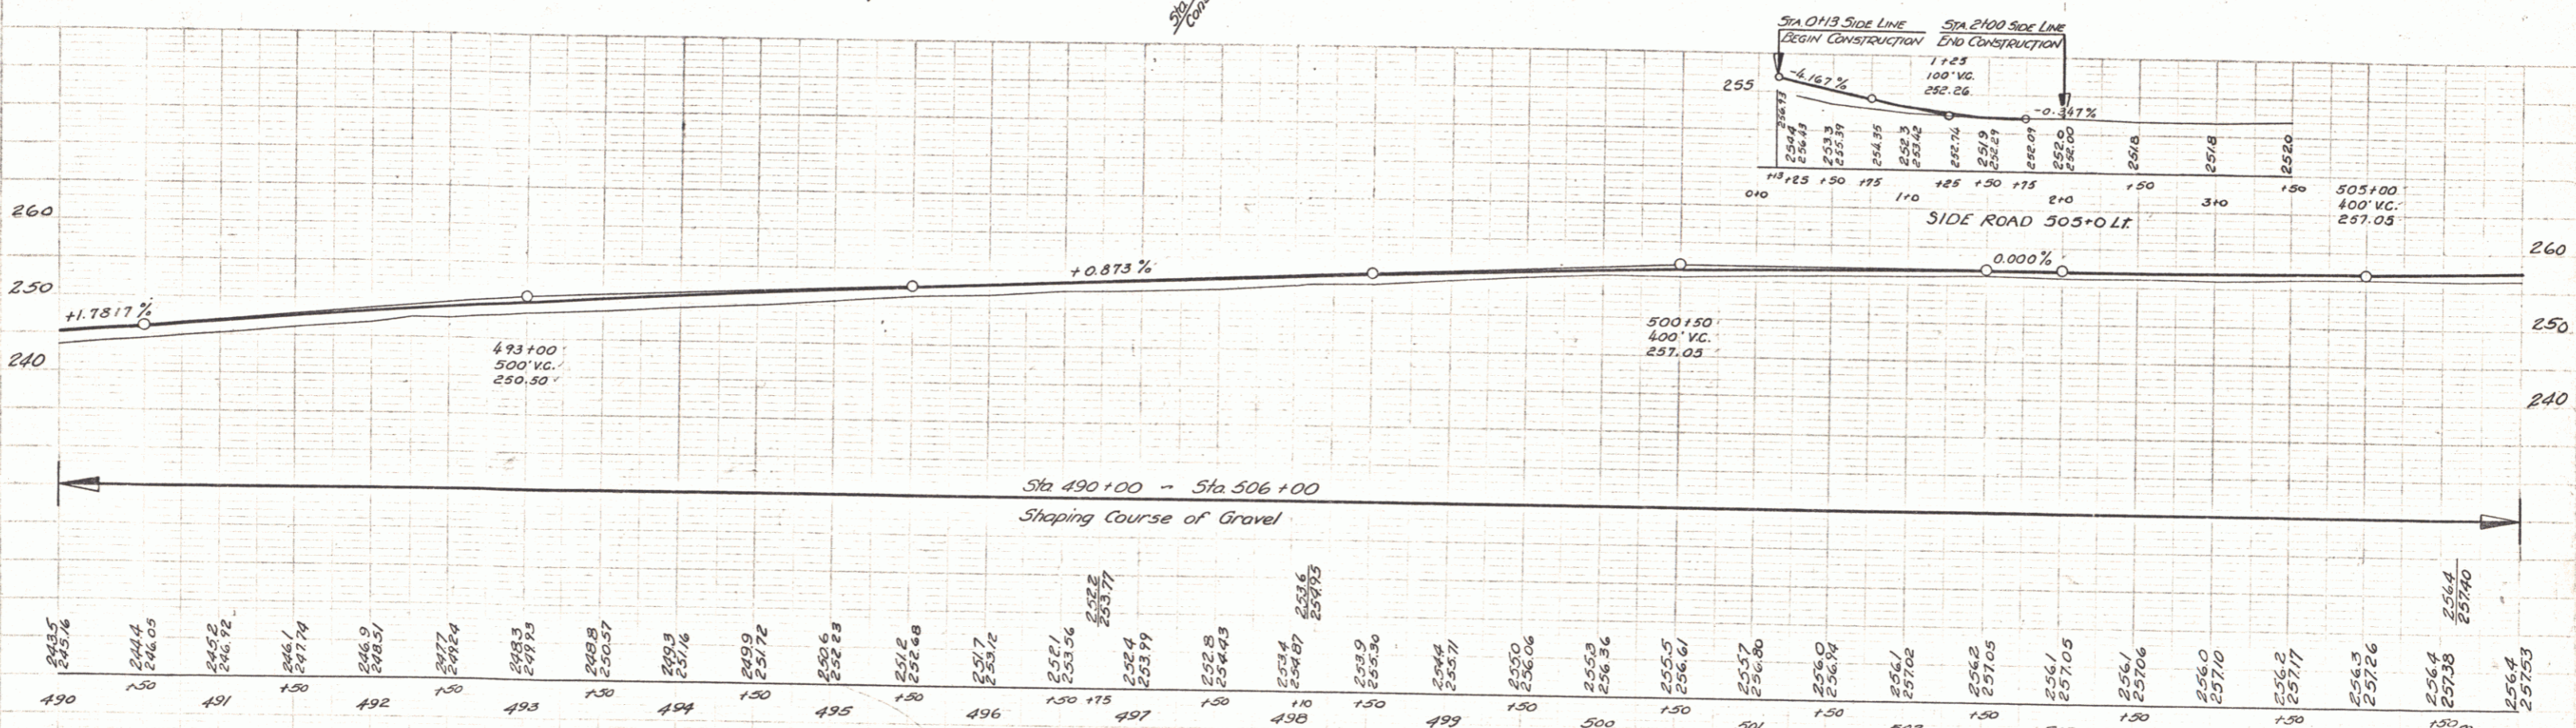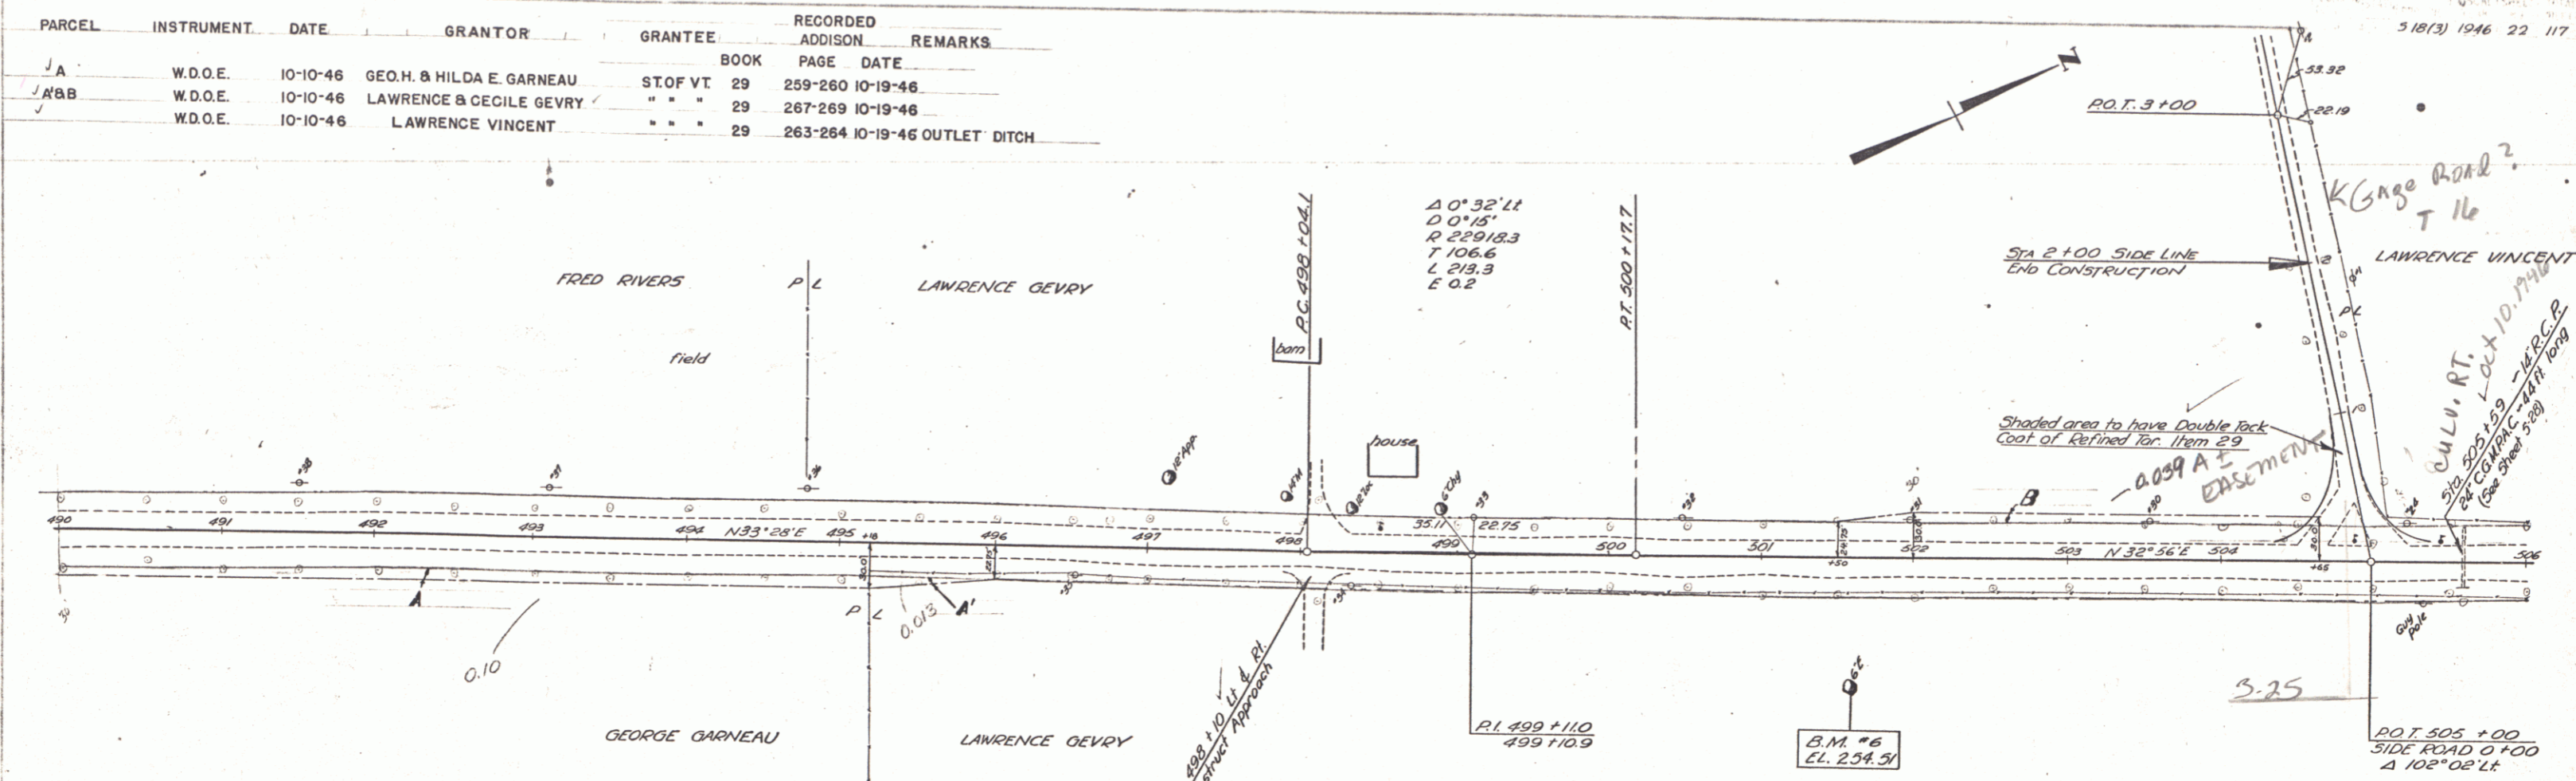

BM #6 El. 254.51 51.8' E. Clump 82 Ft. Rt. Sta 501+56

Bridge - Addition series 5 no. 18 (3) sheet 22 of 117 sheets

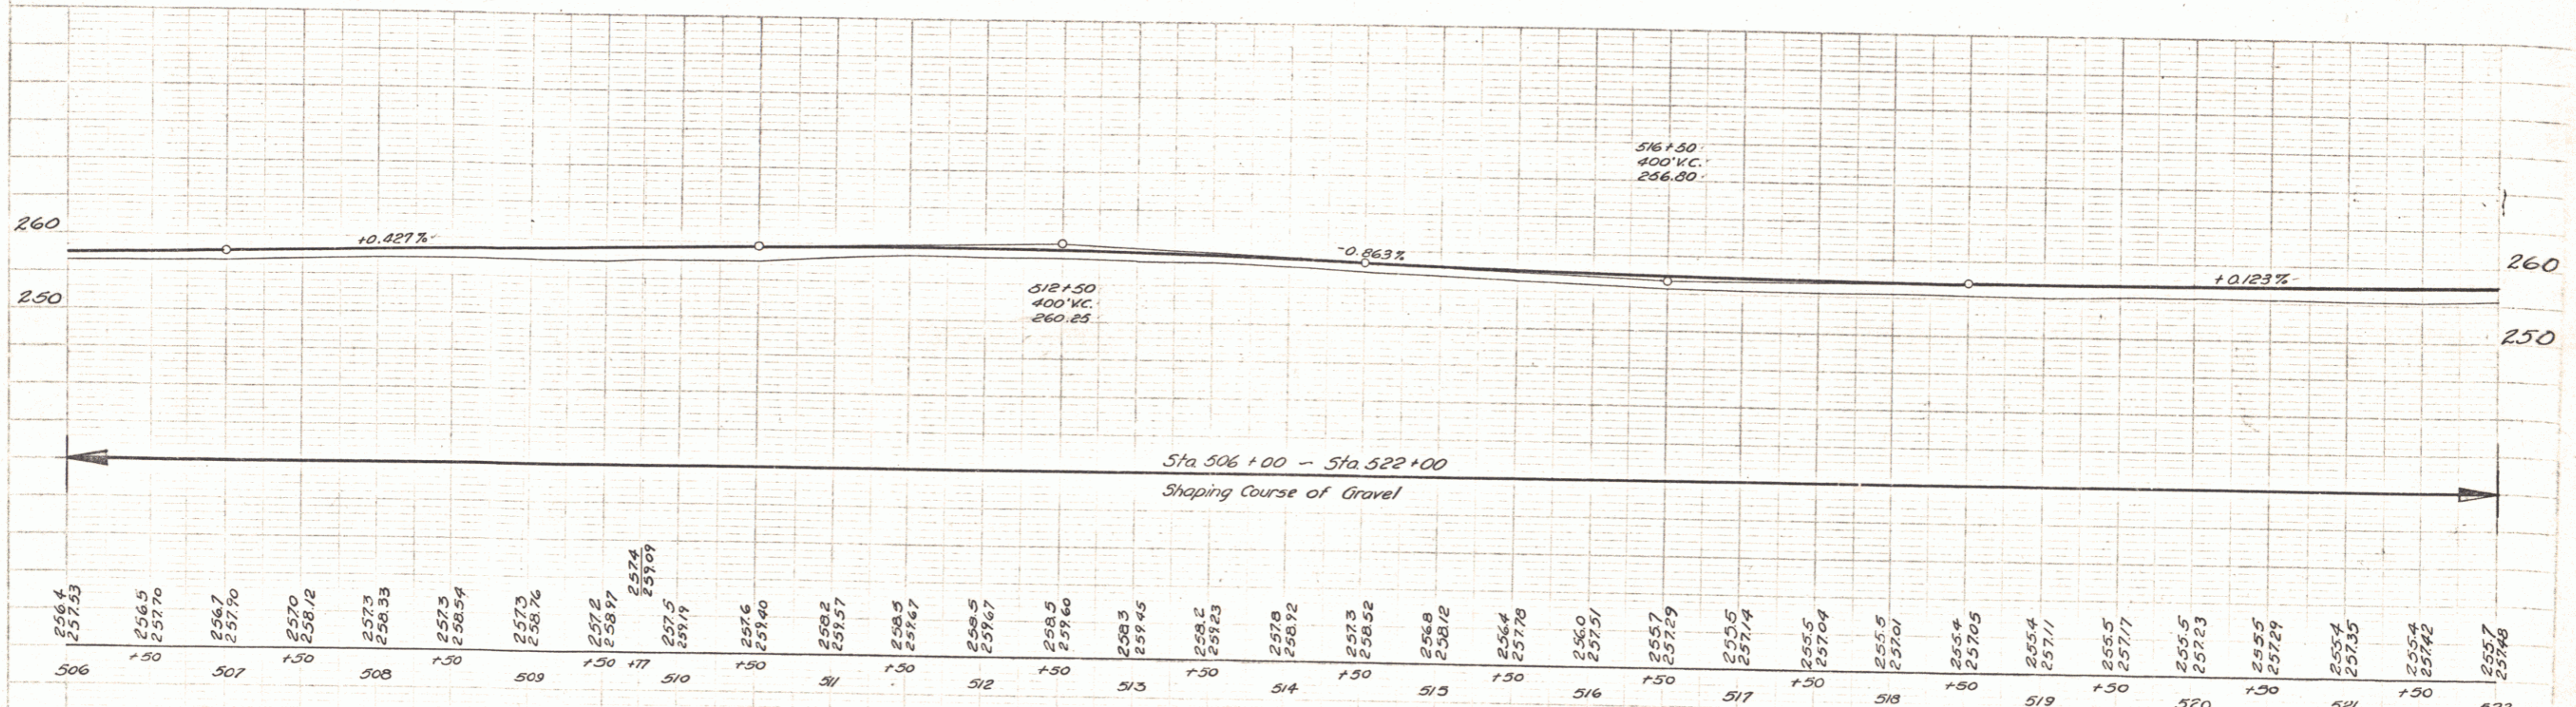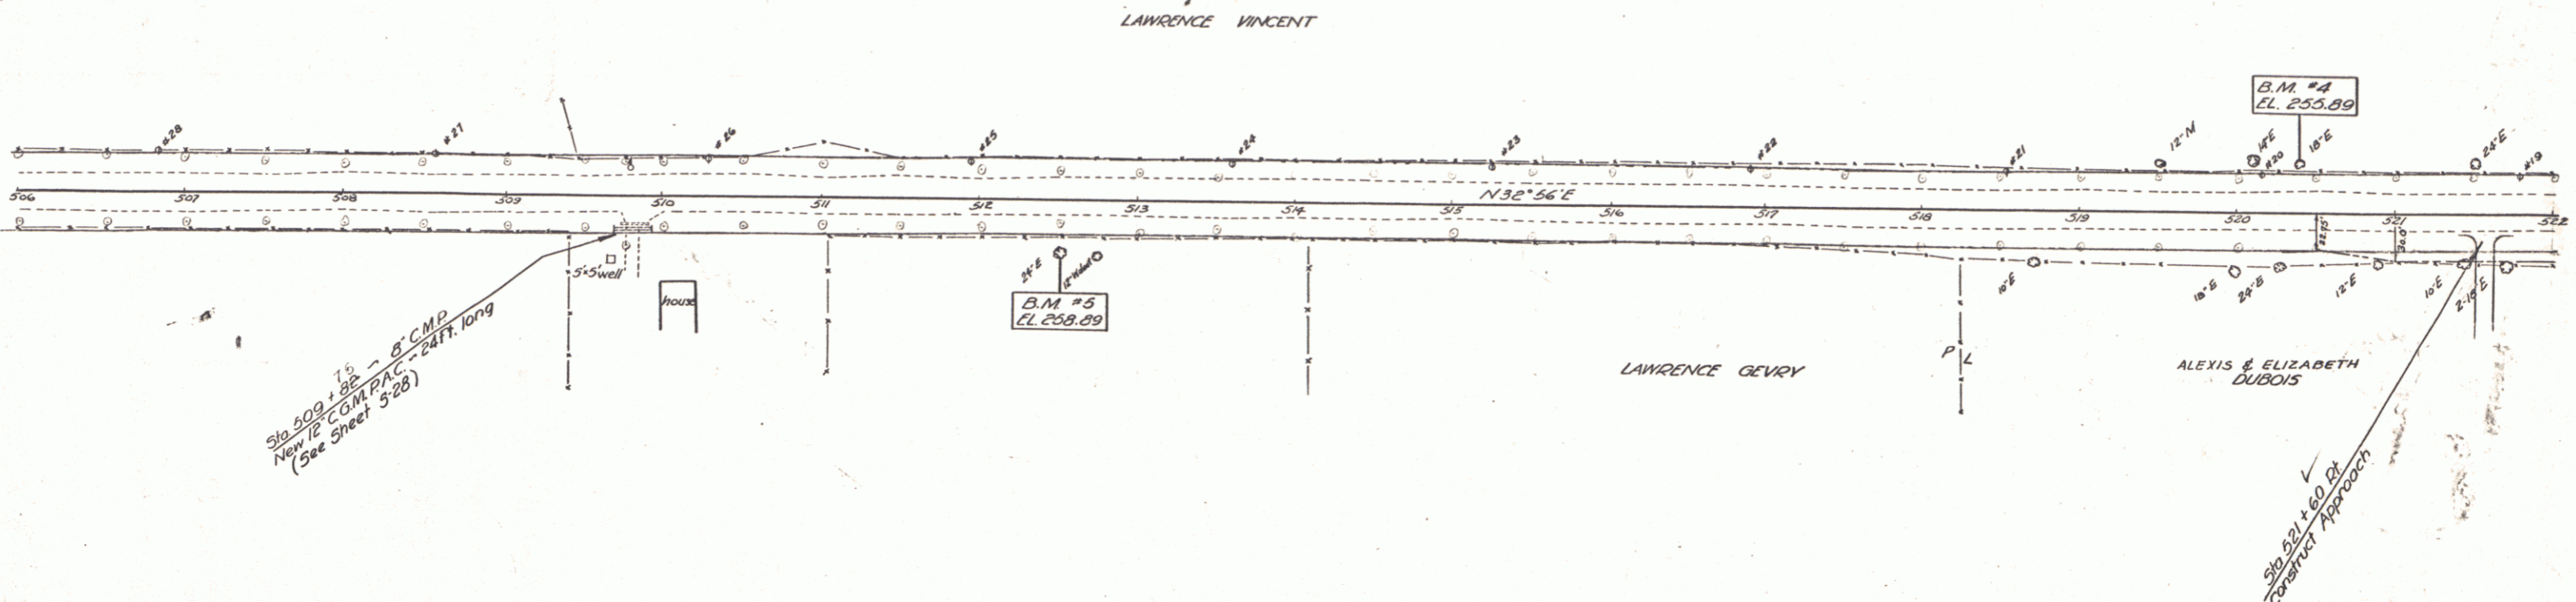


256.4	257.33	256.5	257.70	256.7	257.90	257.0	258.12	257.3	258.33	257.3	258.54	257.3	258.76	257.8	258.97	257.4	259.19	257.6	259.40	258.2	257.57	258.3	257.67	258.5	257.67	258.5	257.60	258.3	257.45	258.2	257.23	257.8	258.12	257.3	258.52	256.8	258.12	256.4	257.78	256.0	257.51	255.7	257.29	255.5	257.14	255.5	257.04	255.9	257.01	255.4	257.05	255.4	257.11	255.5	257.17	255.5	257.23	255.4	257.29	255.4	257.35	255.4	257.42	255.7	257.48																																																																																																																												
506	+50	507	+50	508	+50

BM #4 El 255.89 S1R 18°E 29H.41 Sta 520+38
 BM #5 El 258.89 S1R 18°E 32FT. Sta 512+50


Bridport-Addison series 5 no 18 (3) sheet 23 of 117 sheets

PLAN
 Spaulding
 11-45
 12-45
 12-46
 Traced
 Lamin

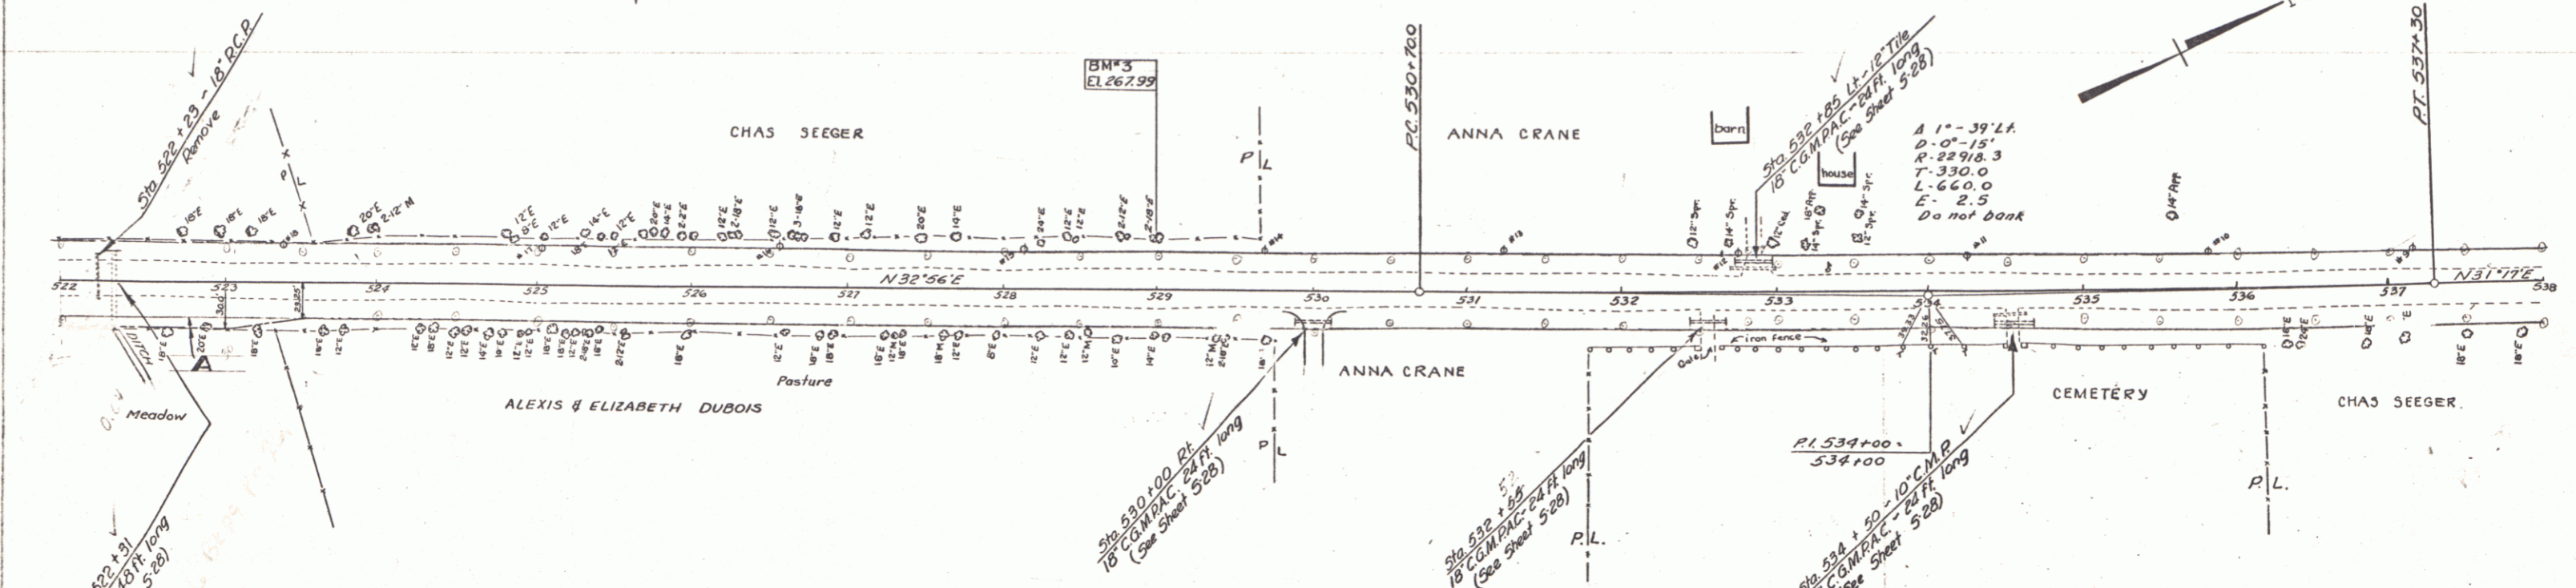

PARCEL	INSTRUMENT	DATE	GRANTOR	GRANTEE	RECORDED	REMARKS
A	W.D.O.E.	10-10-46	ALEXIS & ELIZABETH DUBOIS	ST. OF VT.	BOOK 29 PAGE 261	ADDITION DATE 10-19-46

PLAN
 Spaulding
 11-45
 12-45
 12-46
 Traced
 Lamin


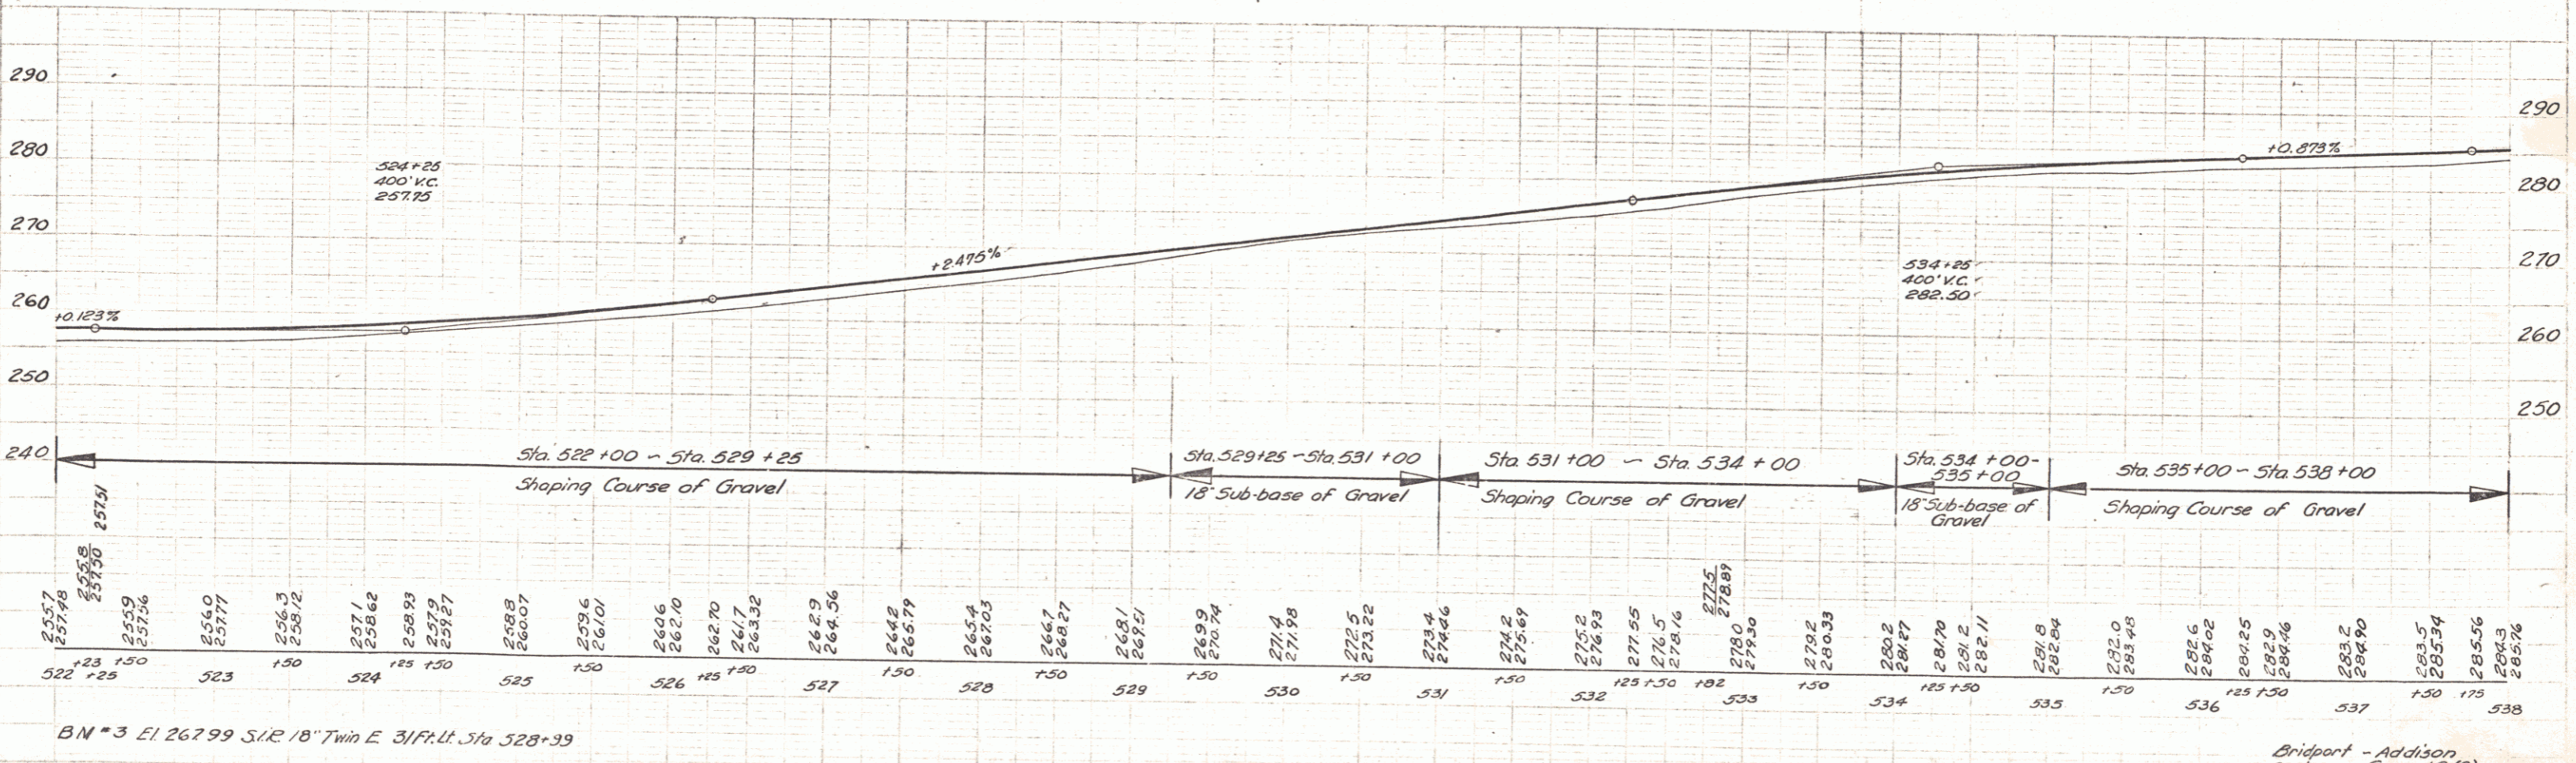


BN #3 EL 267.99 S/C 18" Twin E 31/F/Lt Sta 528+39

Bridport - Addison
 Series 5 no. 18 (B)
 sheet 24 of 117 sheets

PARCEL	INSTRUMENT	DATE	GRANTOR	GRANTEE	RECORDED	ADDISON	REMARKS
A	W.D.O.E.	10-10-46	CHARLES L. SEEGER	ST. OF VT.	BOOK	PAGE	DATE
					29	262-263	10-19-46

518(3) 1946 25 117

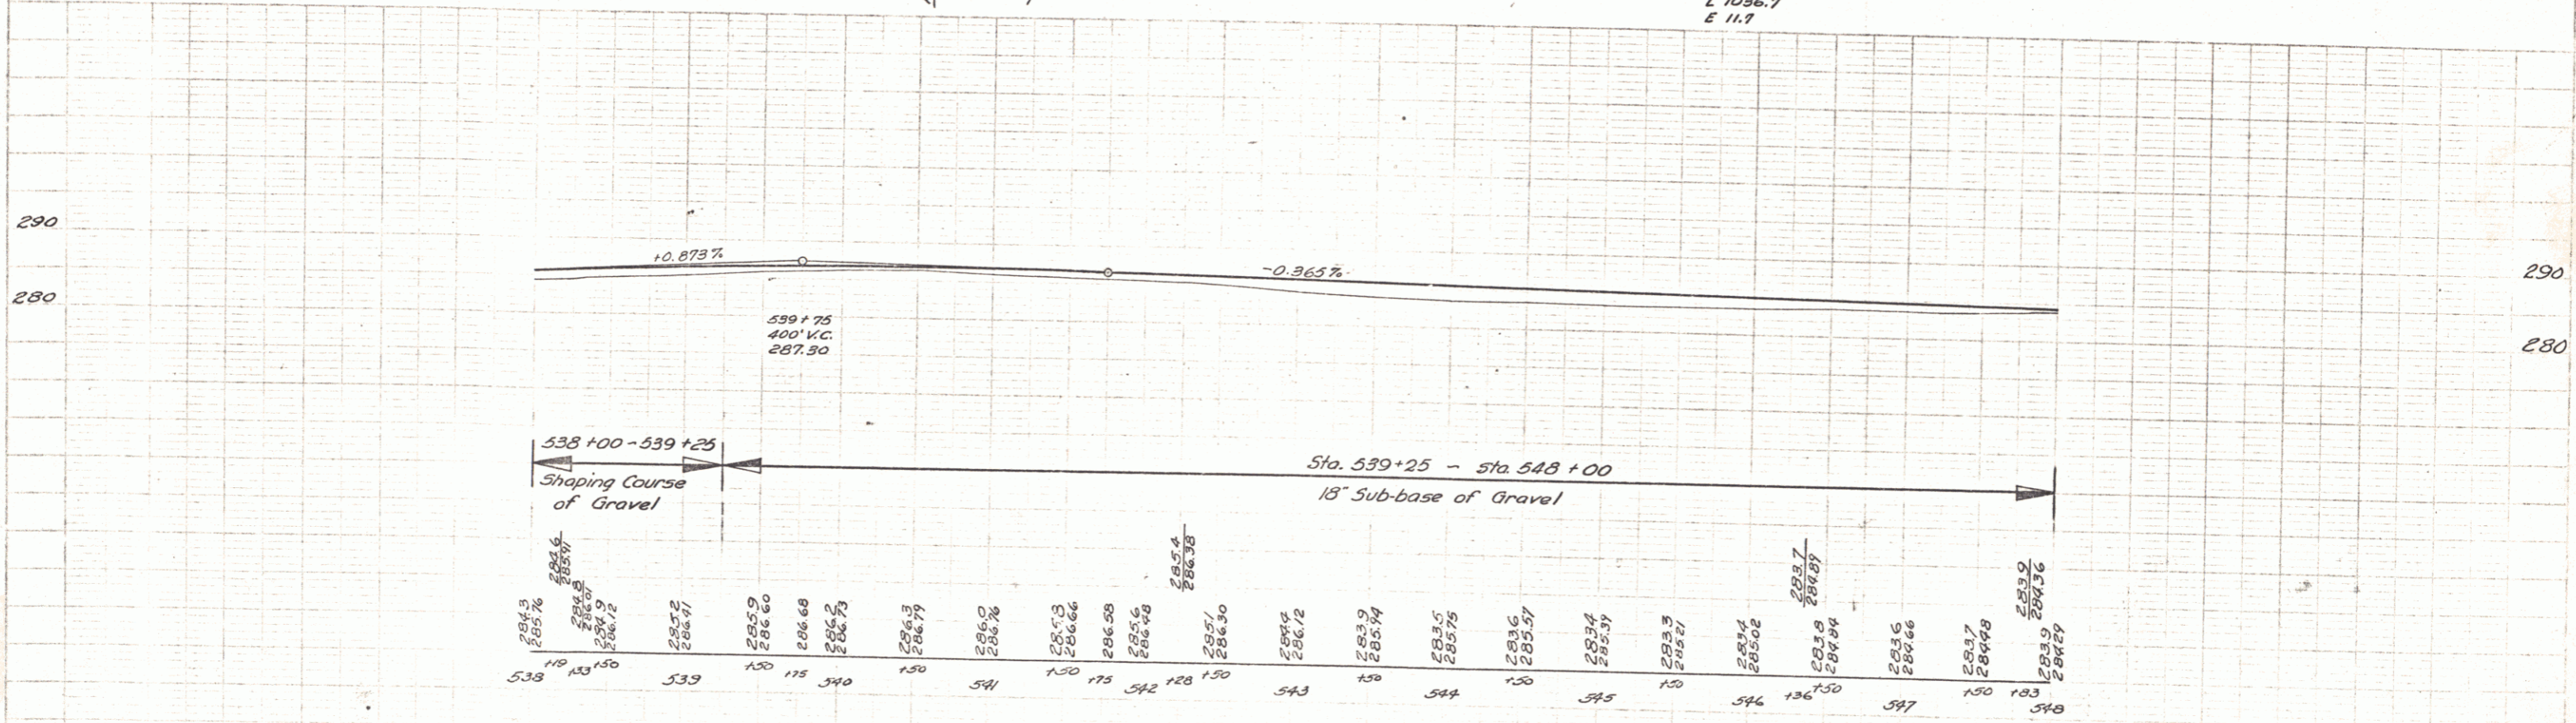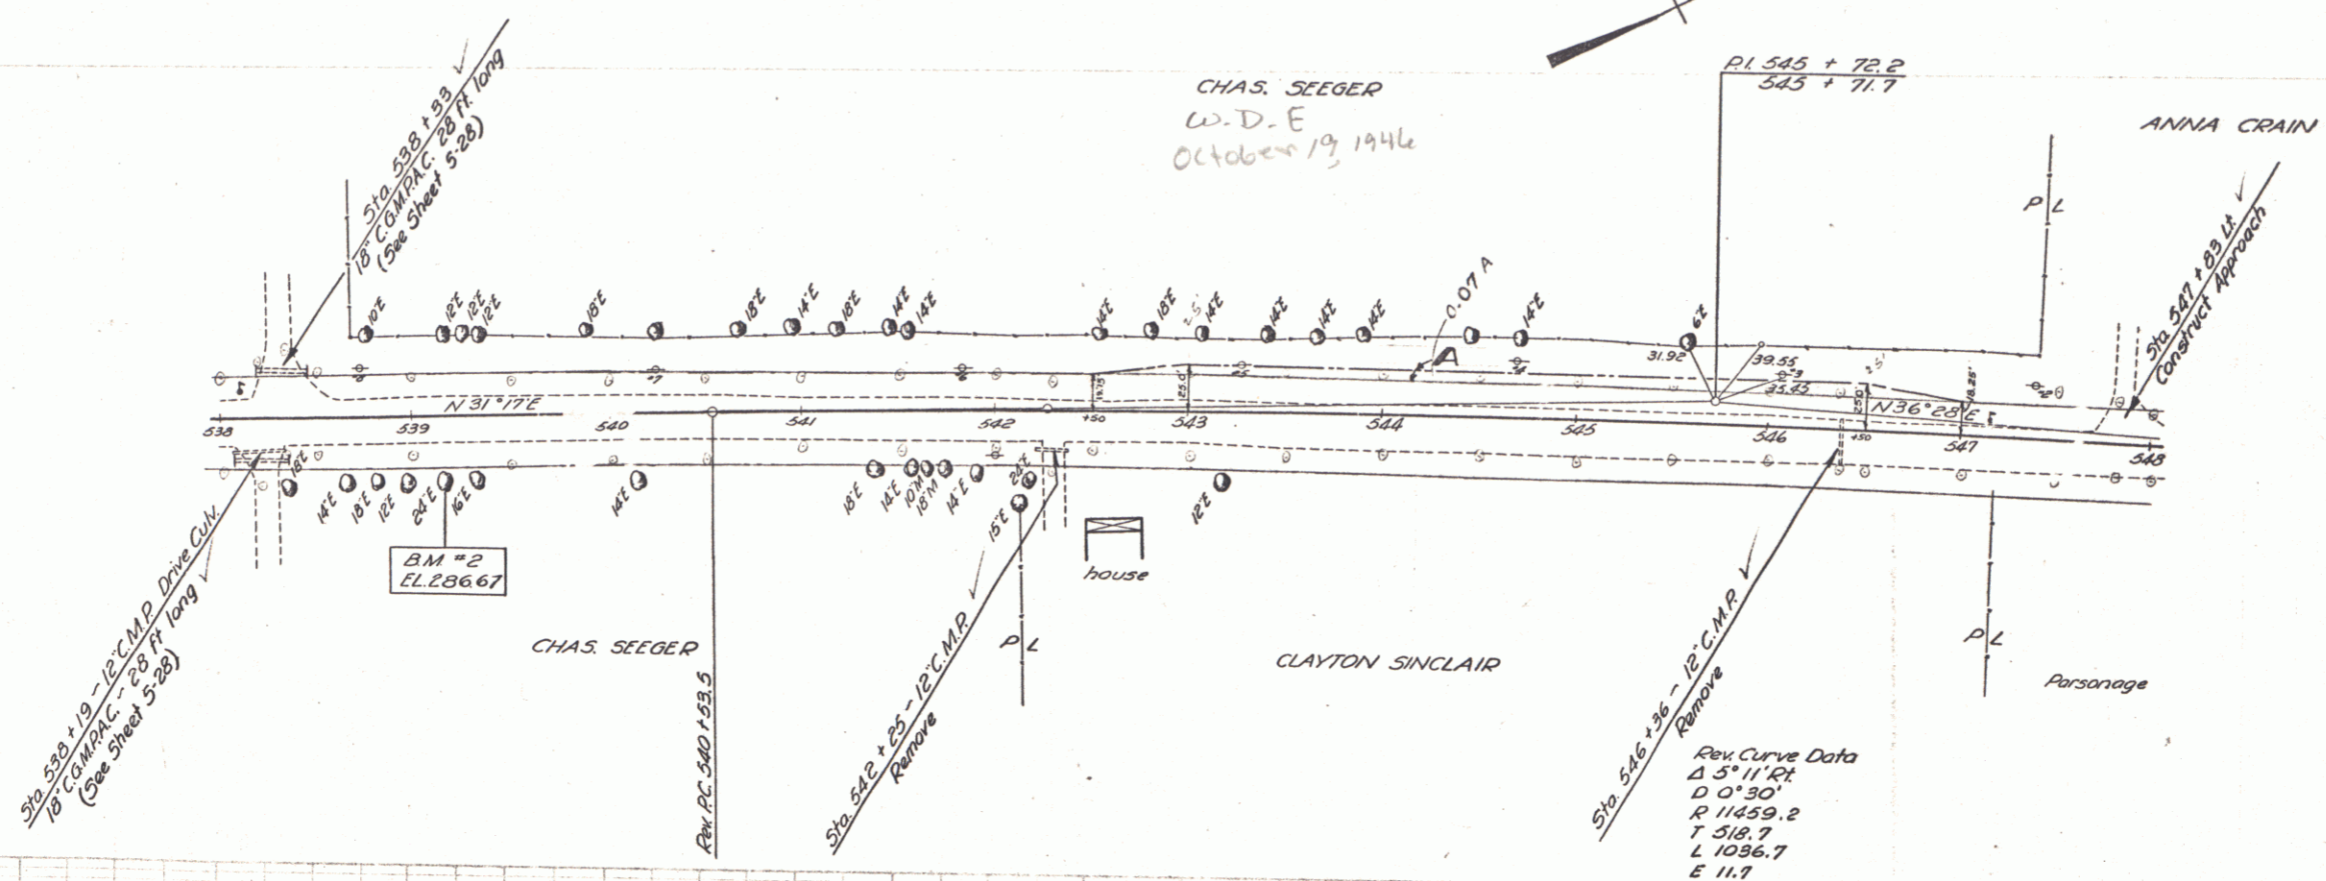

BM #2 El. 286.67 S1R. 24° E 30 FR. Sta 539+15

Bridport-Addison series 5 no. 13(3) sheet 25 of 117 sheets

