



PLAN
 12-46
 12-46

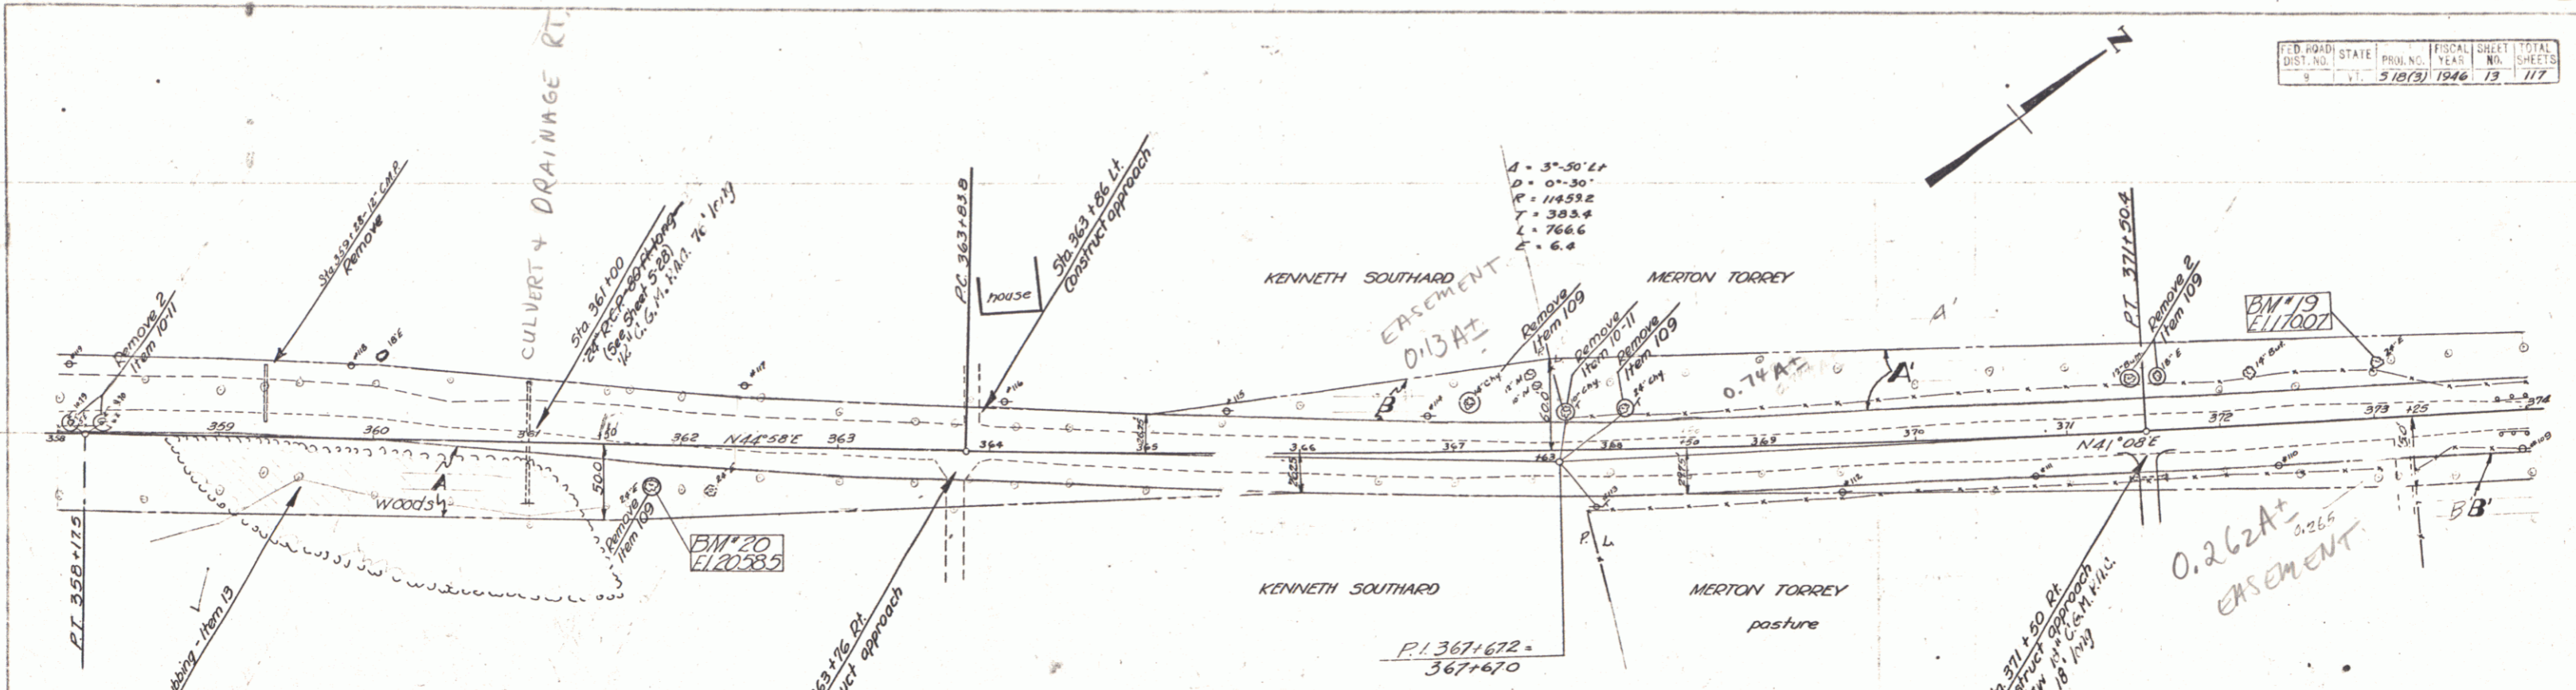

PARCEL	INSTRUMENT	DATE	GRANTOR	GRANTEE	RECORDED ADDISON BOOK PAGE DATE	REMARKS
✓ ABB	W.D.O.E.	10-1-46	KENNETH SOUTHARD	ST. OF VT.	29 243-244 10-19-46	
✓ A'BB'	W.D.O.E.	11-21-46	MERTON & SHIRLEY B. TORREY	" "	29 274-276 12-6-46	

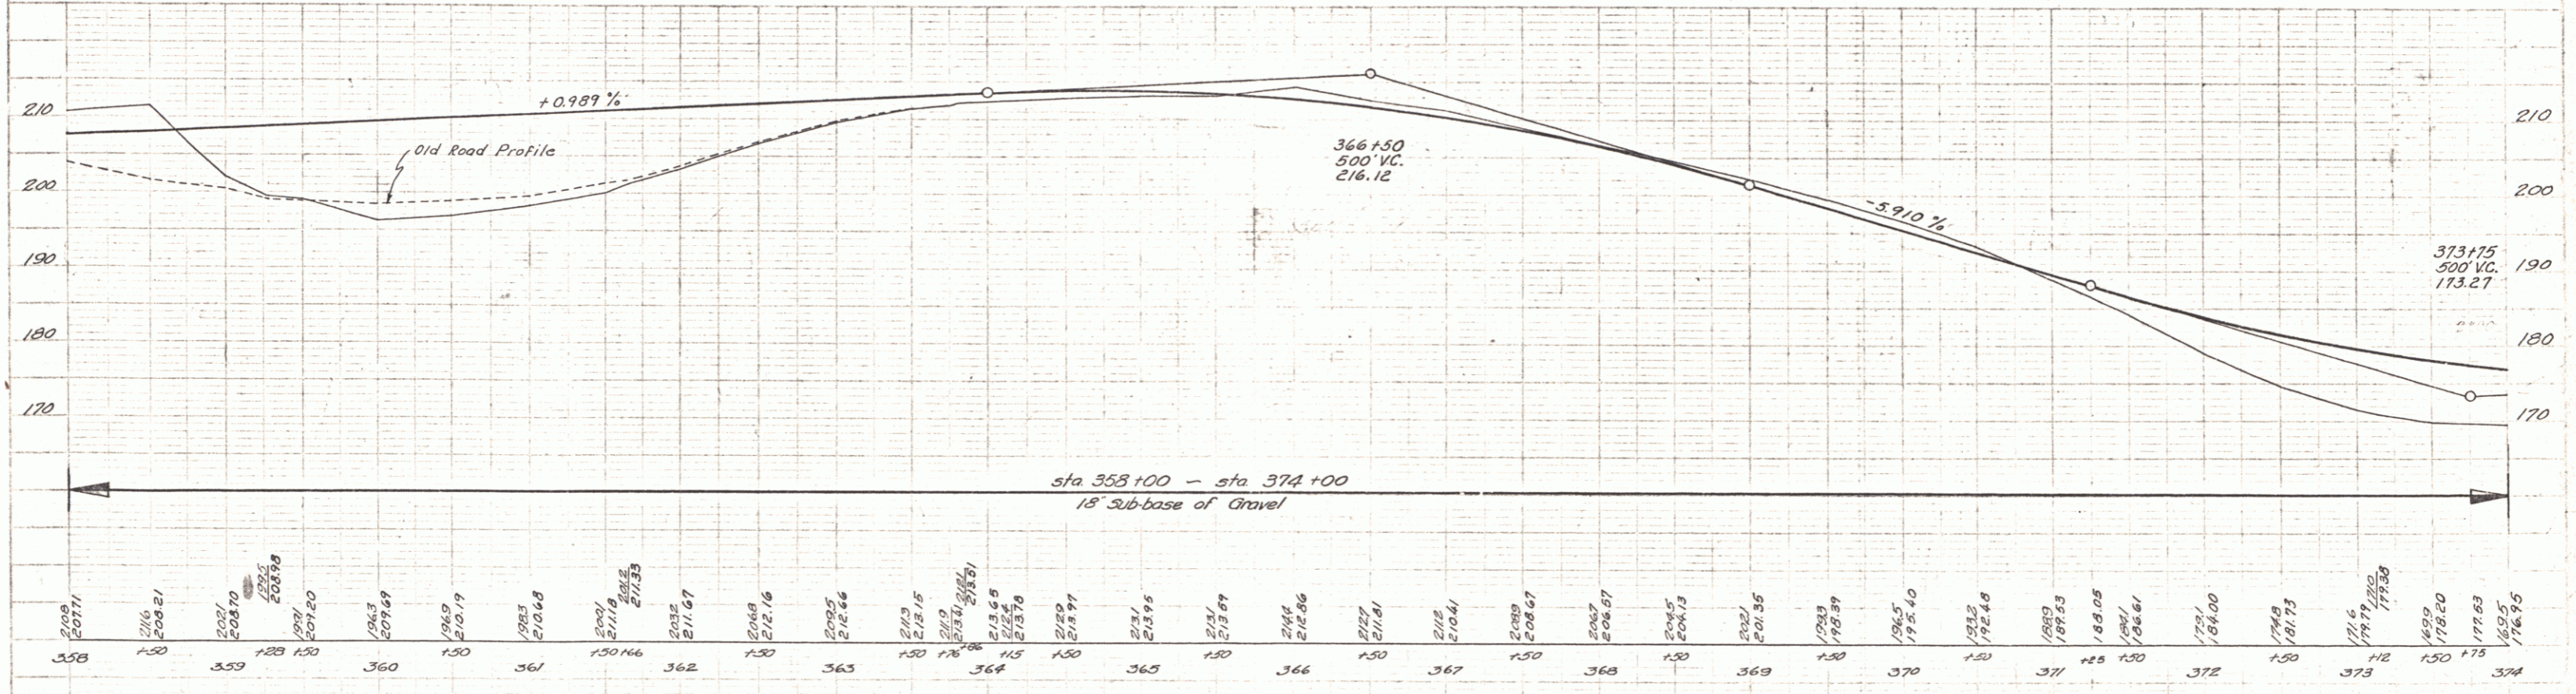

BM # 19 E 17007 S.I.R. 24" Elm 32H Lt Sta 373+02
 B.M. # 20 E 120585 S.I.C. 24" Elm 24H Rt Sta 361+80

Bridport-Addison series 5 no. 18(3) sheet 13 of 117 sheets