




FED. ROAD DIST. NO.	STATE	PROJ. NO.	FEED. SHEET NO.	TOTAL SHEETS
5	Vt.	518(3)	14	117

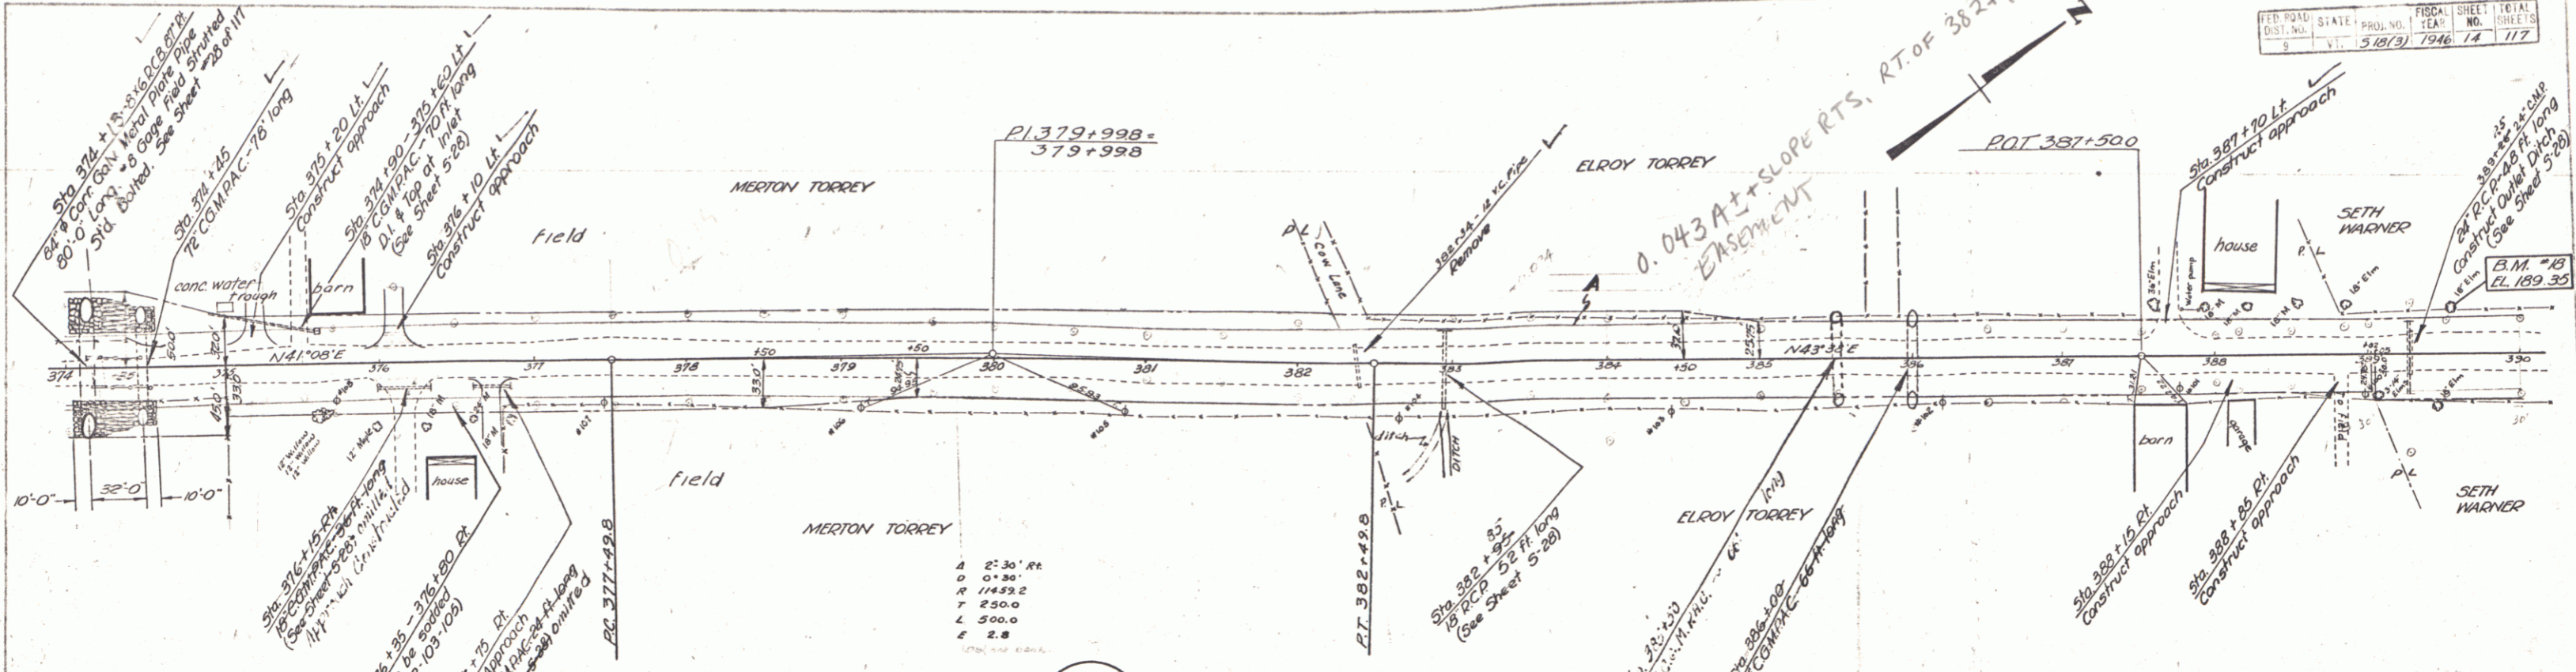

Scale: 1" = 40'
 Traced
 11/45

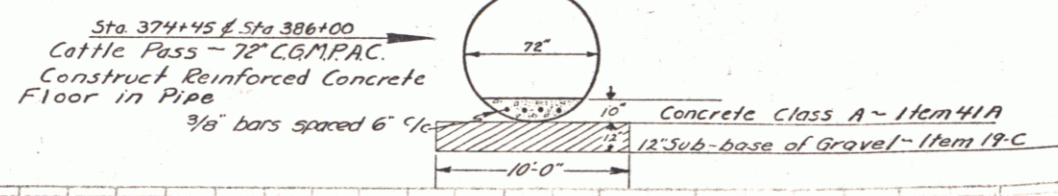

PARCEL	INSTRUMENT	DATE	GRANTOR	GRANTEE	RECORDED ADDITION BOOK PAGE DATE	REMARKS
A	W.D.O.E.	10-10-46	ELROY TORREY	ST. OF VT.	29 264-265 10-19-46	

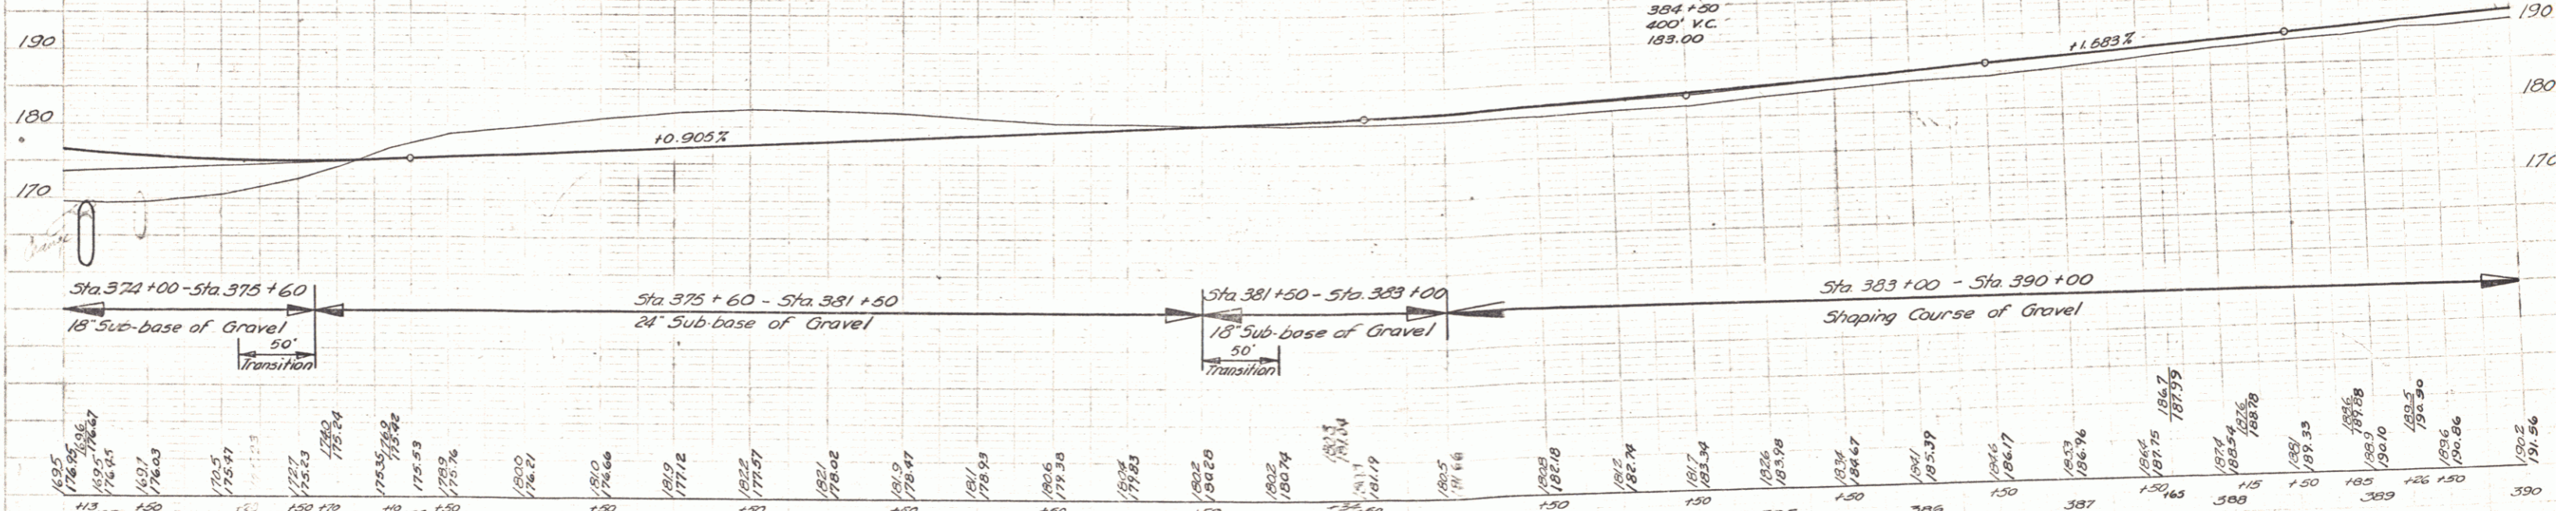

B.M. #18 El. 189.35 S.I.R. 18' Elm 27 ft Lt. Sta 389+52

Bridport-Addison series 5 no 18(3) sheet 14 of 117 sheets