


11-45  
12-45  
12-45

11-45  
12-45  
12-45

PARCEL	INSTRUMENT	DATE	GRANTOR	GRANTEE	BOOK	RECORDED ADDITION PAGE DATE	REMARKS
✓	W.D.O.E.	10-10-46	DON W. & LEITA BUCHANAN	ST. OF VT.	29	262 10-19-46	OUTLET DITCH FOR CULV.
✓ A, B, C	W.D.O.E.	11-21-46	SETH W. & LORRAINE GAGE WARNER	" "	29	271-273 12-6-46	

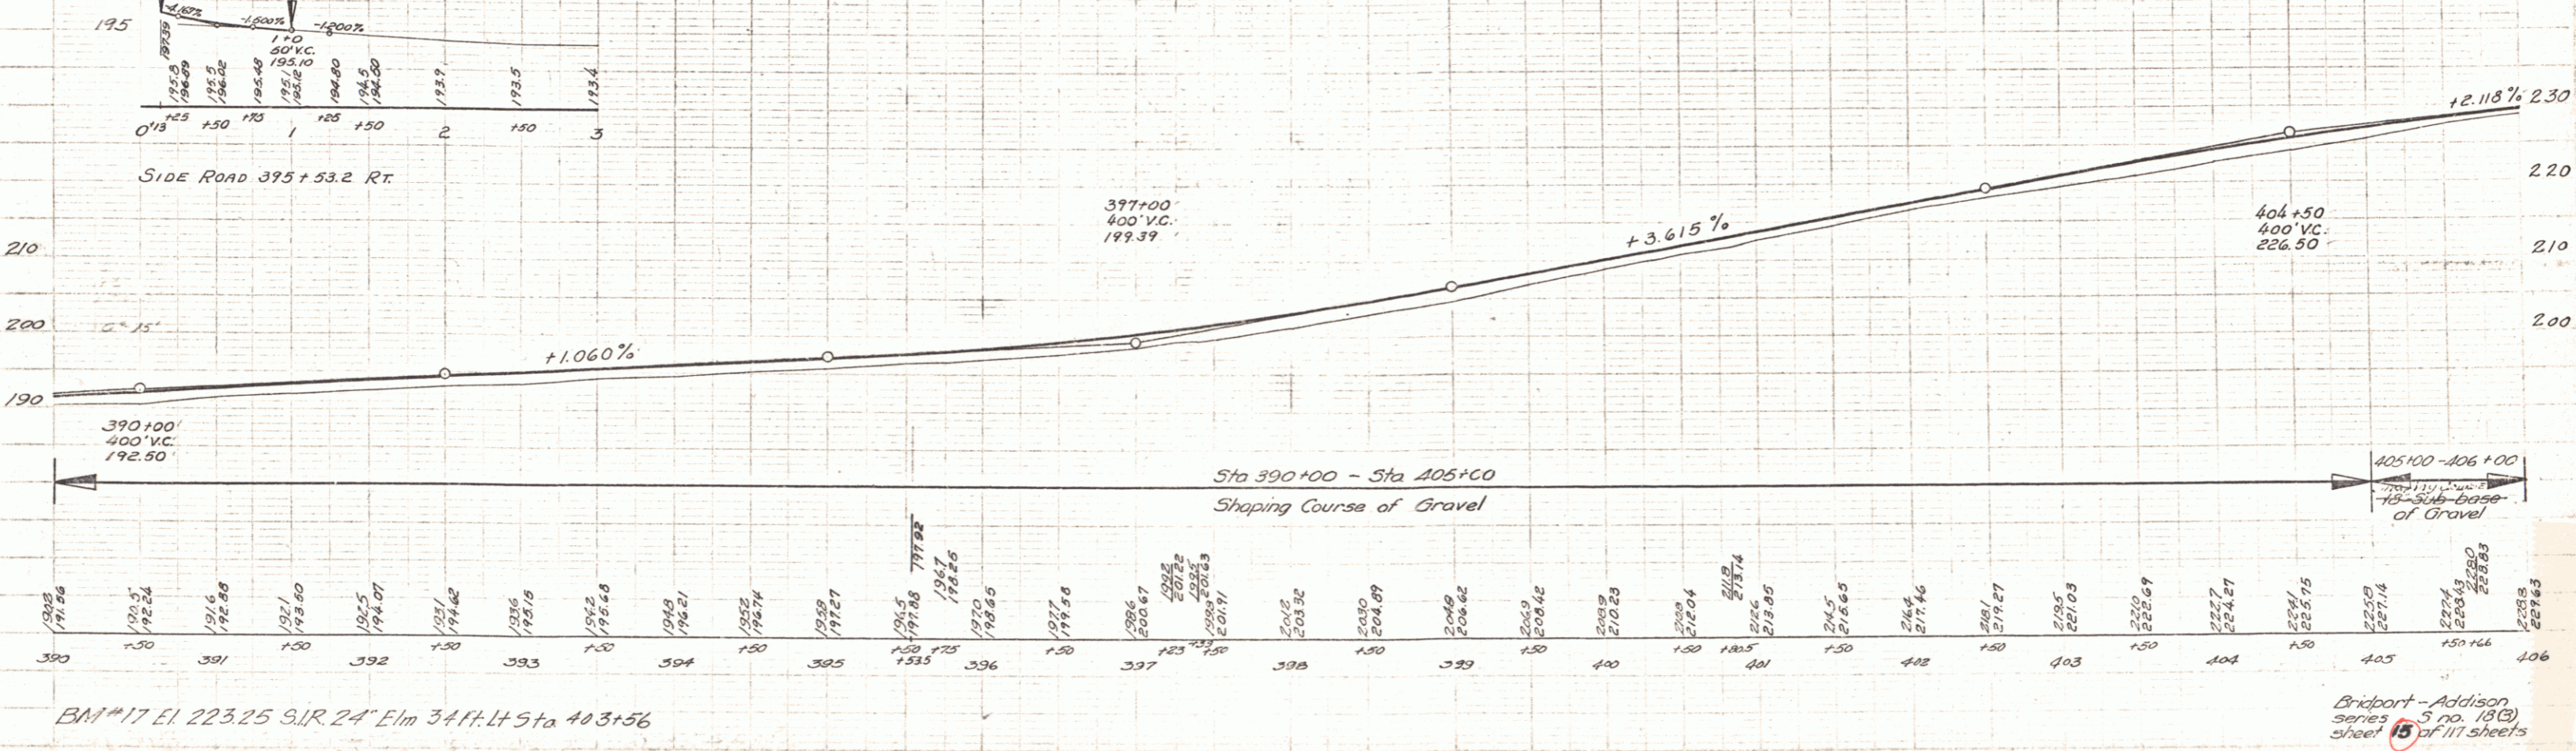

BM #17 El. 223.25 S.I.R. 24" Elm 3 1/4" Lt Sta 403+56

Bridport - Addison Series 5 no. 18(3) sheet 13 of 111 sheets