
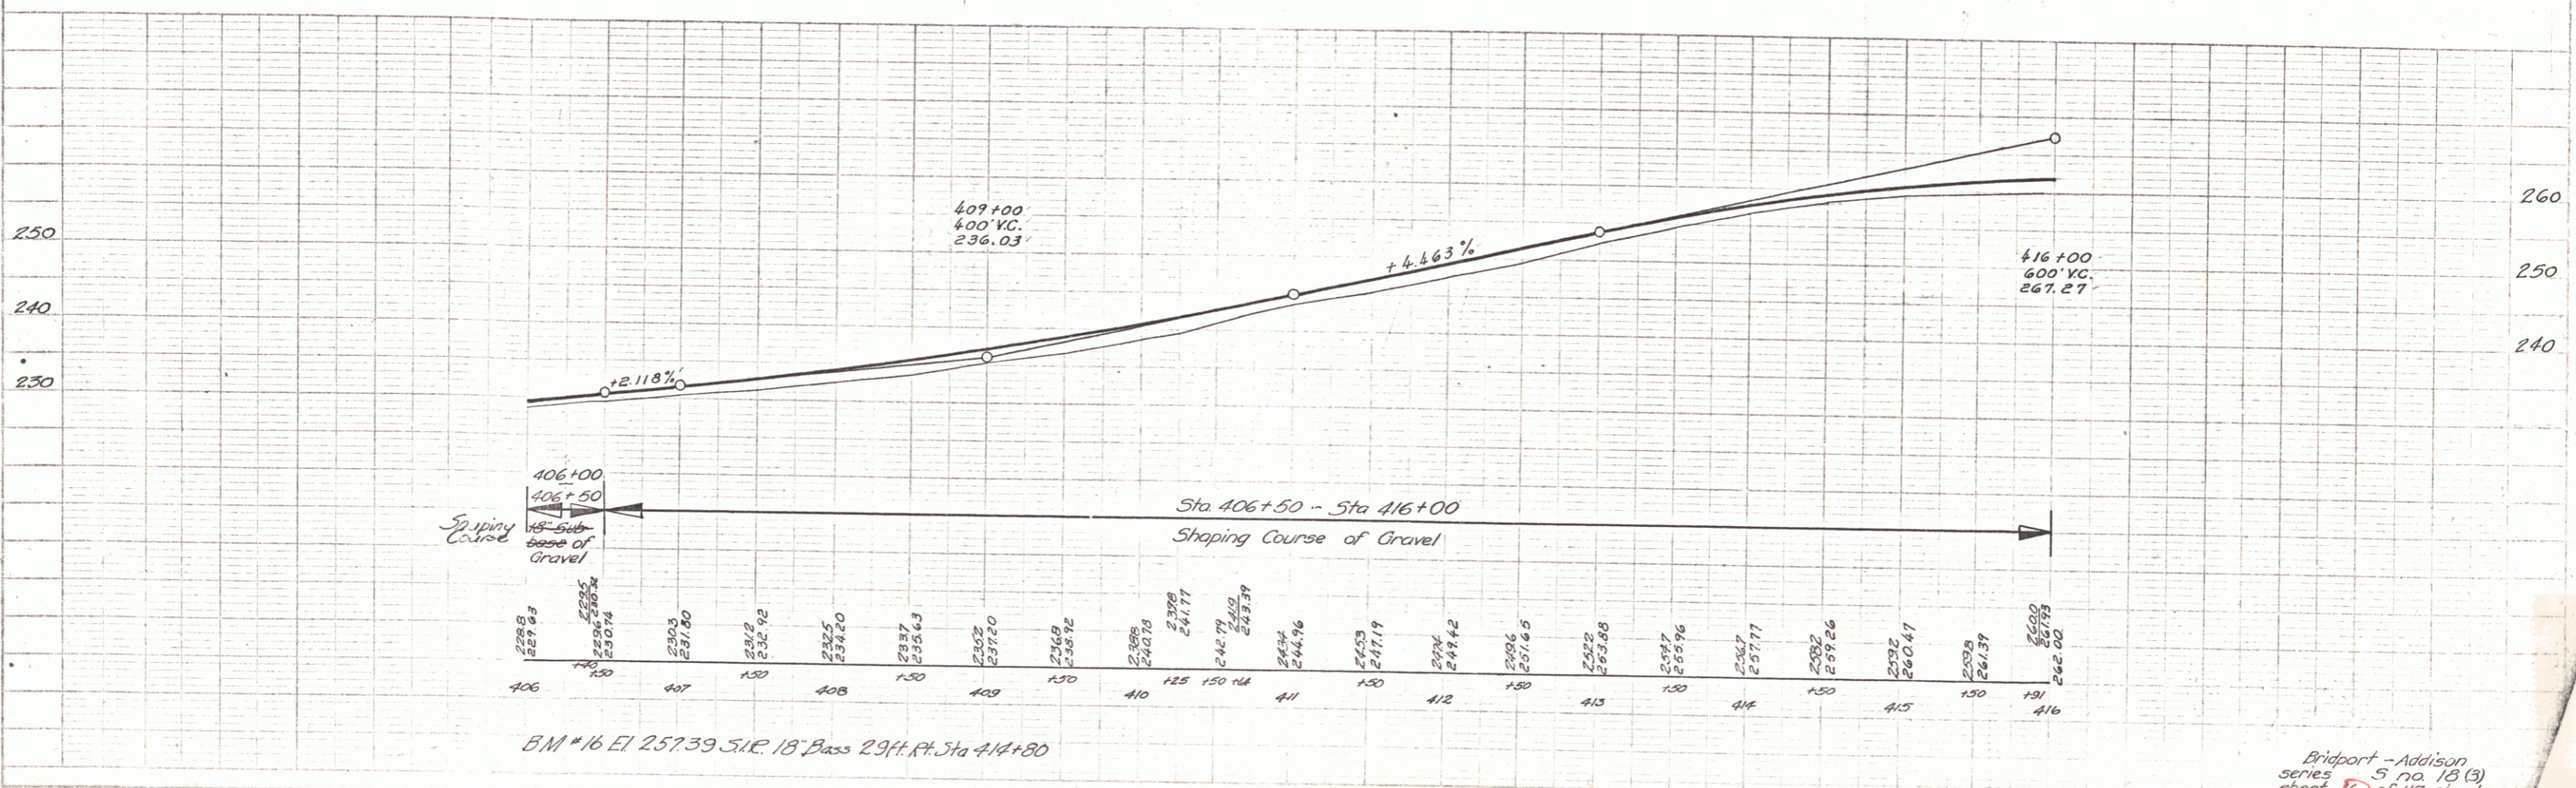


PLAN: Sponning Lamm  
 DATE: 10-15-45  
 DRAWN BY: Lamm

PROF: Sponning Lamm  
 DATE: 10-15-45  
 DRAWN BY: Lamm

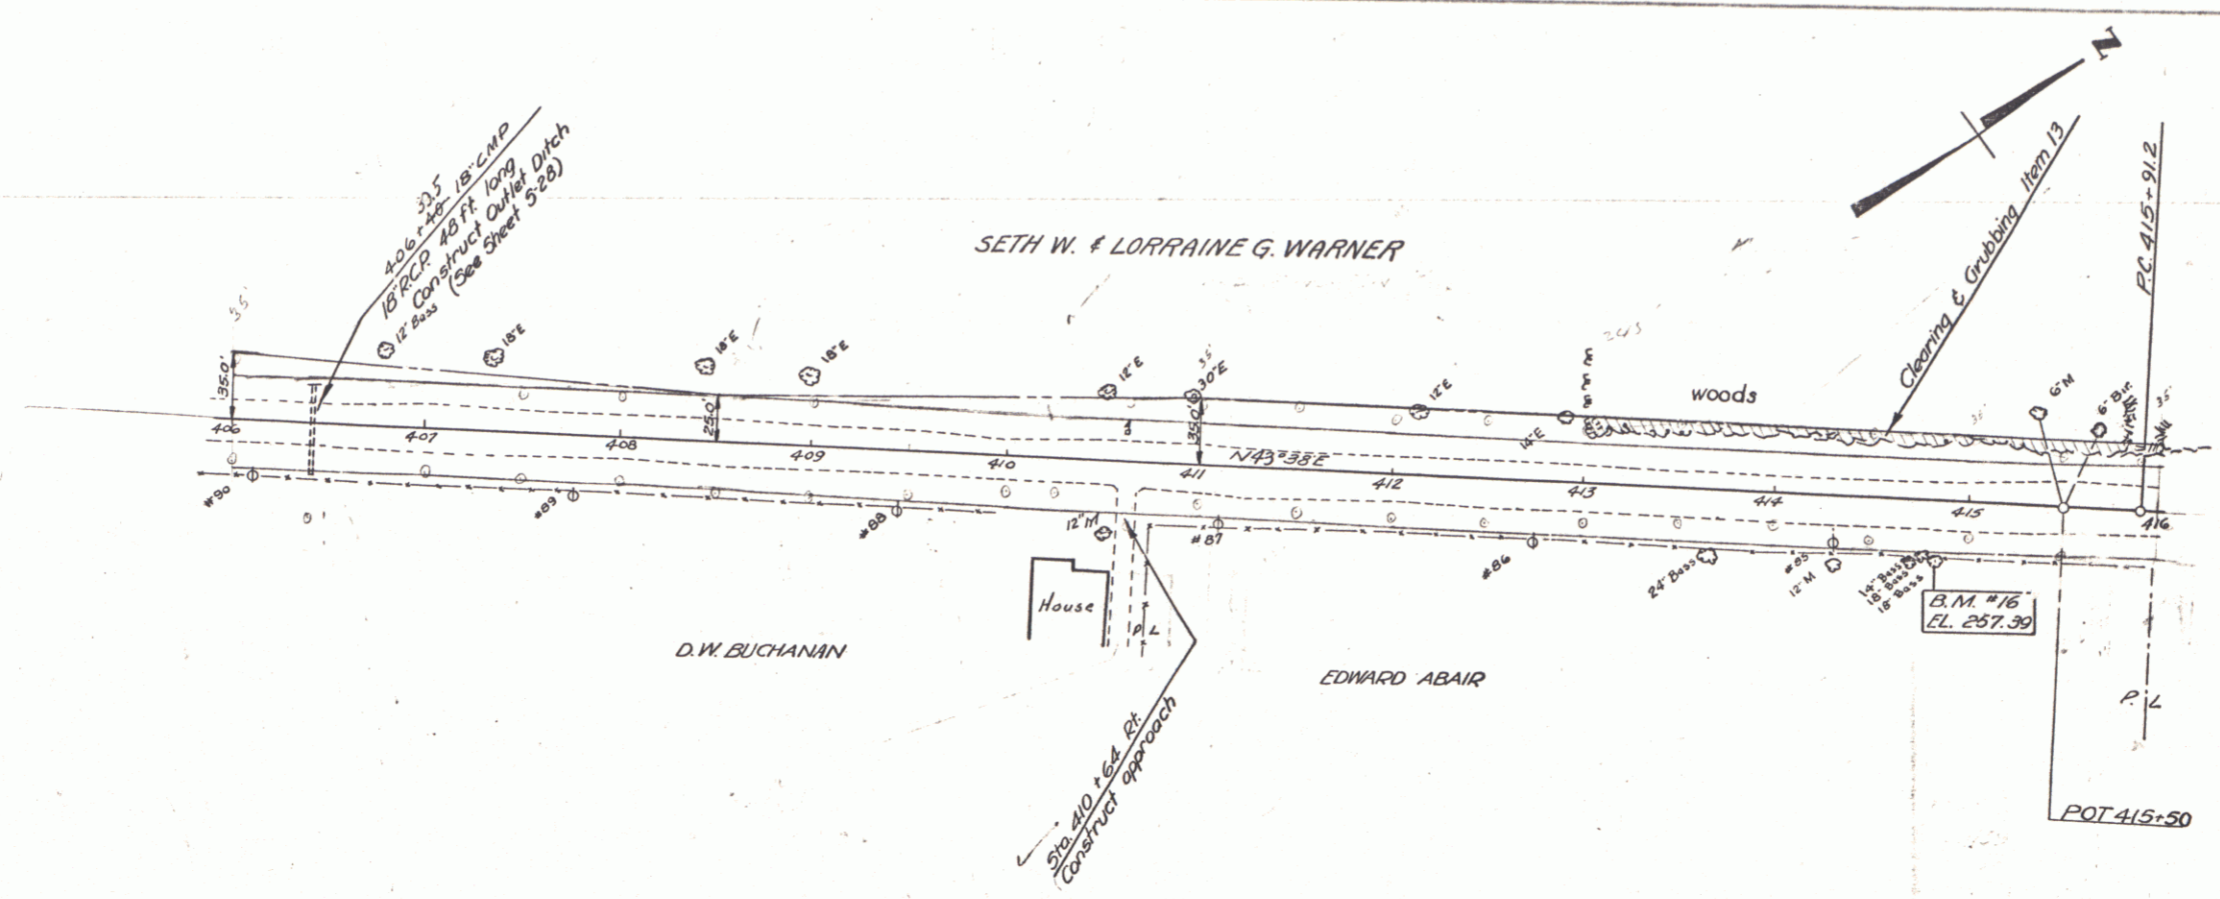

B.M. #16 El 257.39 512 18' Pass 29' Rt. Sta 414+80