
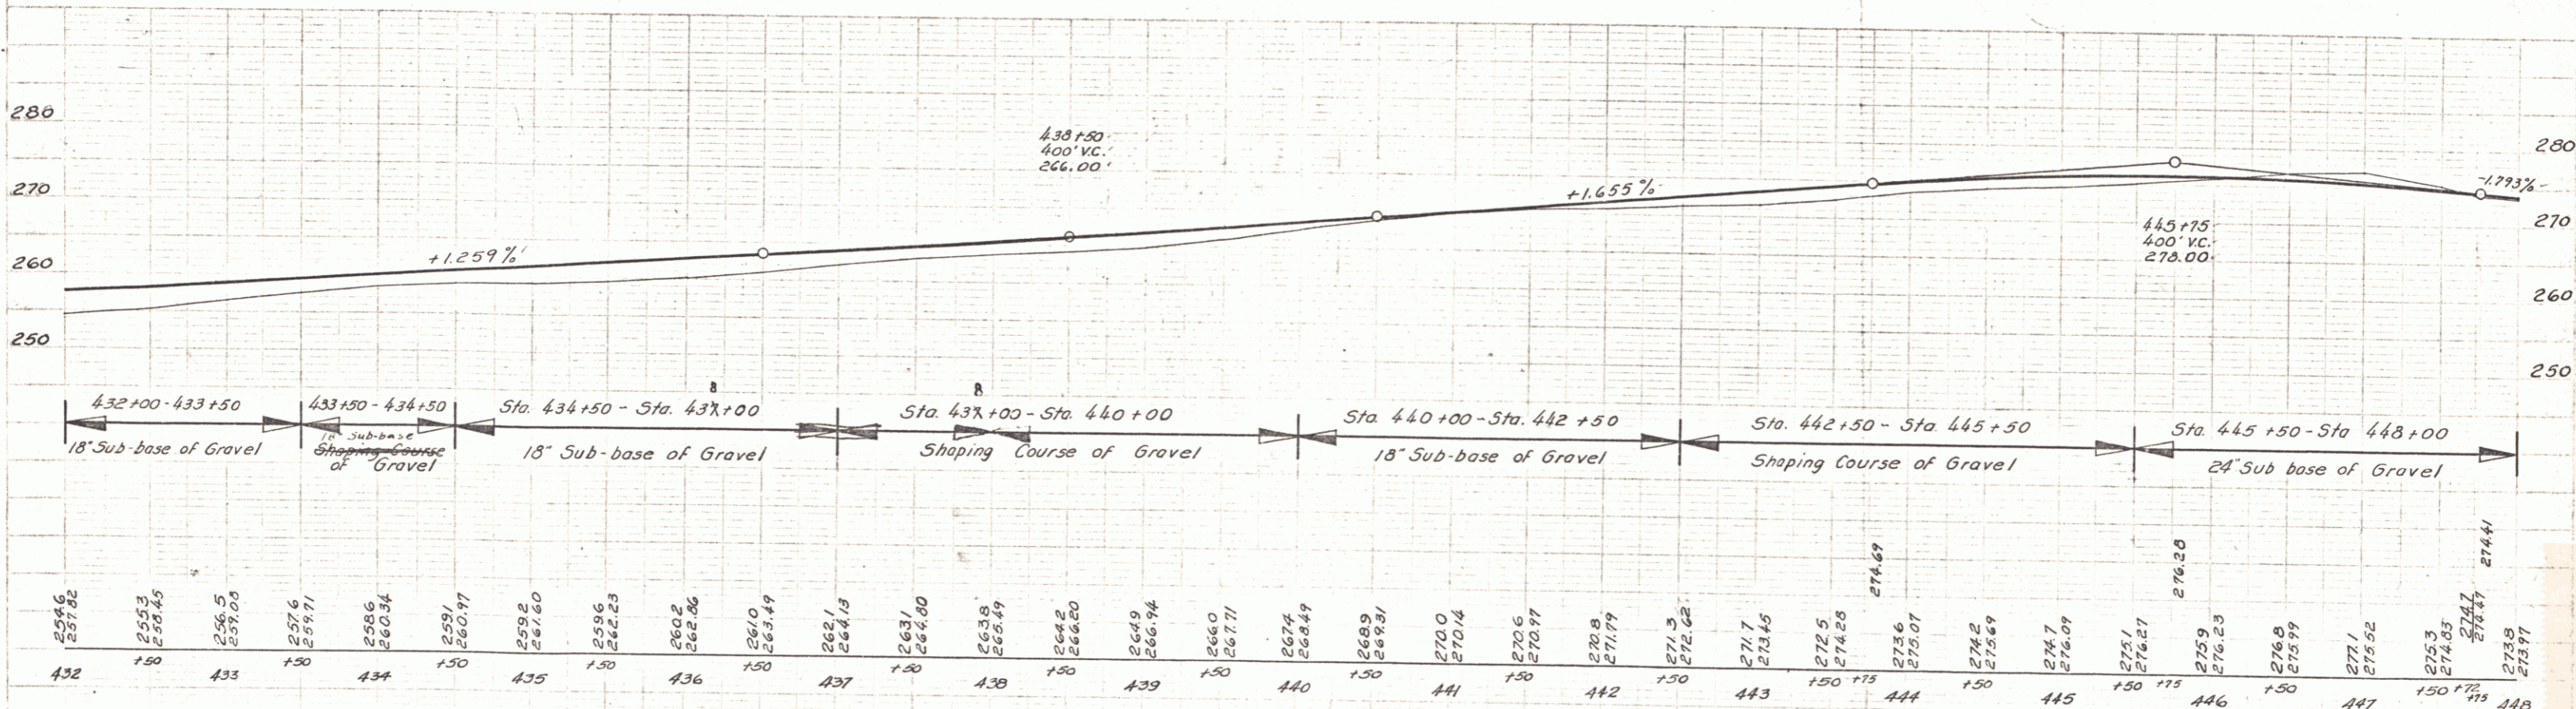


PARCEL	INSTRUMENT	DATE	GRANTOR	GRANTEE	RECORDED ADDITION	REMARKS
✓ A	W.D.O.E.	10-1-46	GAYLE & LAURA B. PUTNAM	ST. OF VT.	BOOK 29	PAGE 258-259 10-19-46
✓	W.D.O.E.	10-10-46	DOROTHY WINTERS	" " "	29	260-261 10-19-46 CULV. DITCH

A 0°-47' Lt  
 D 0-15'  
 R 229/18.3  
 T 156.3  
 L 313.3  
 E 2.1

518(3) 1946 18 117

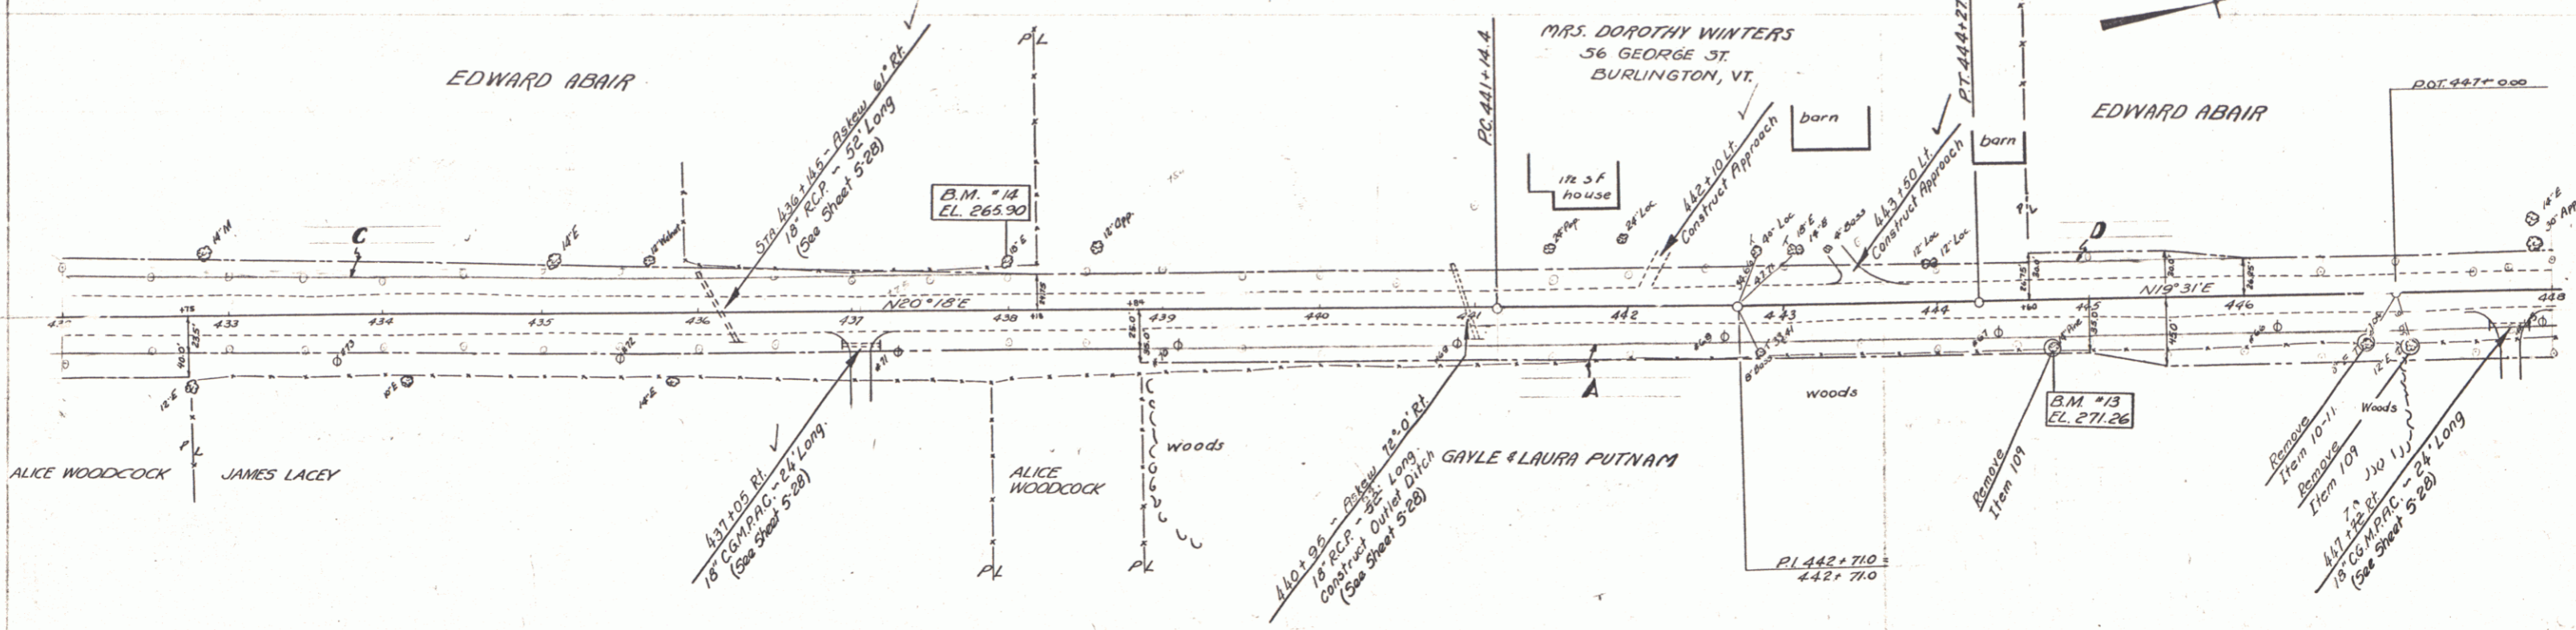

BM # 13 El. 271.26 S.I.R. 18" Pine 28 Ft. Rt. Sta. 444+60  
 BM # 14 El. 265.90 S.I.R. 18" E. 28 Ft. Lt. Sta. 436+99

Bridport - Addison  
 Series No. 18(3)  
 Sheet 10 of 117 sheets