
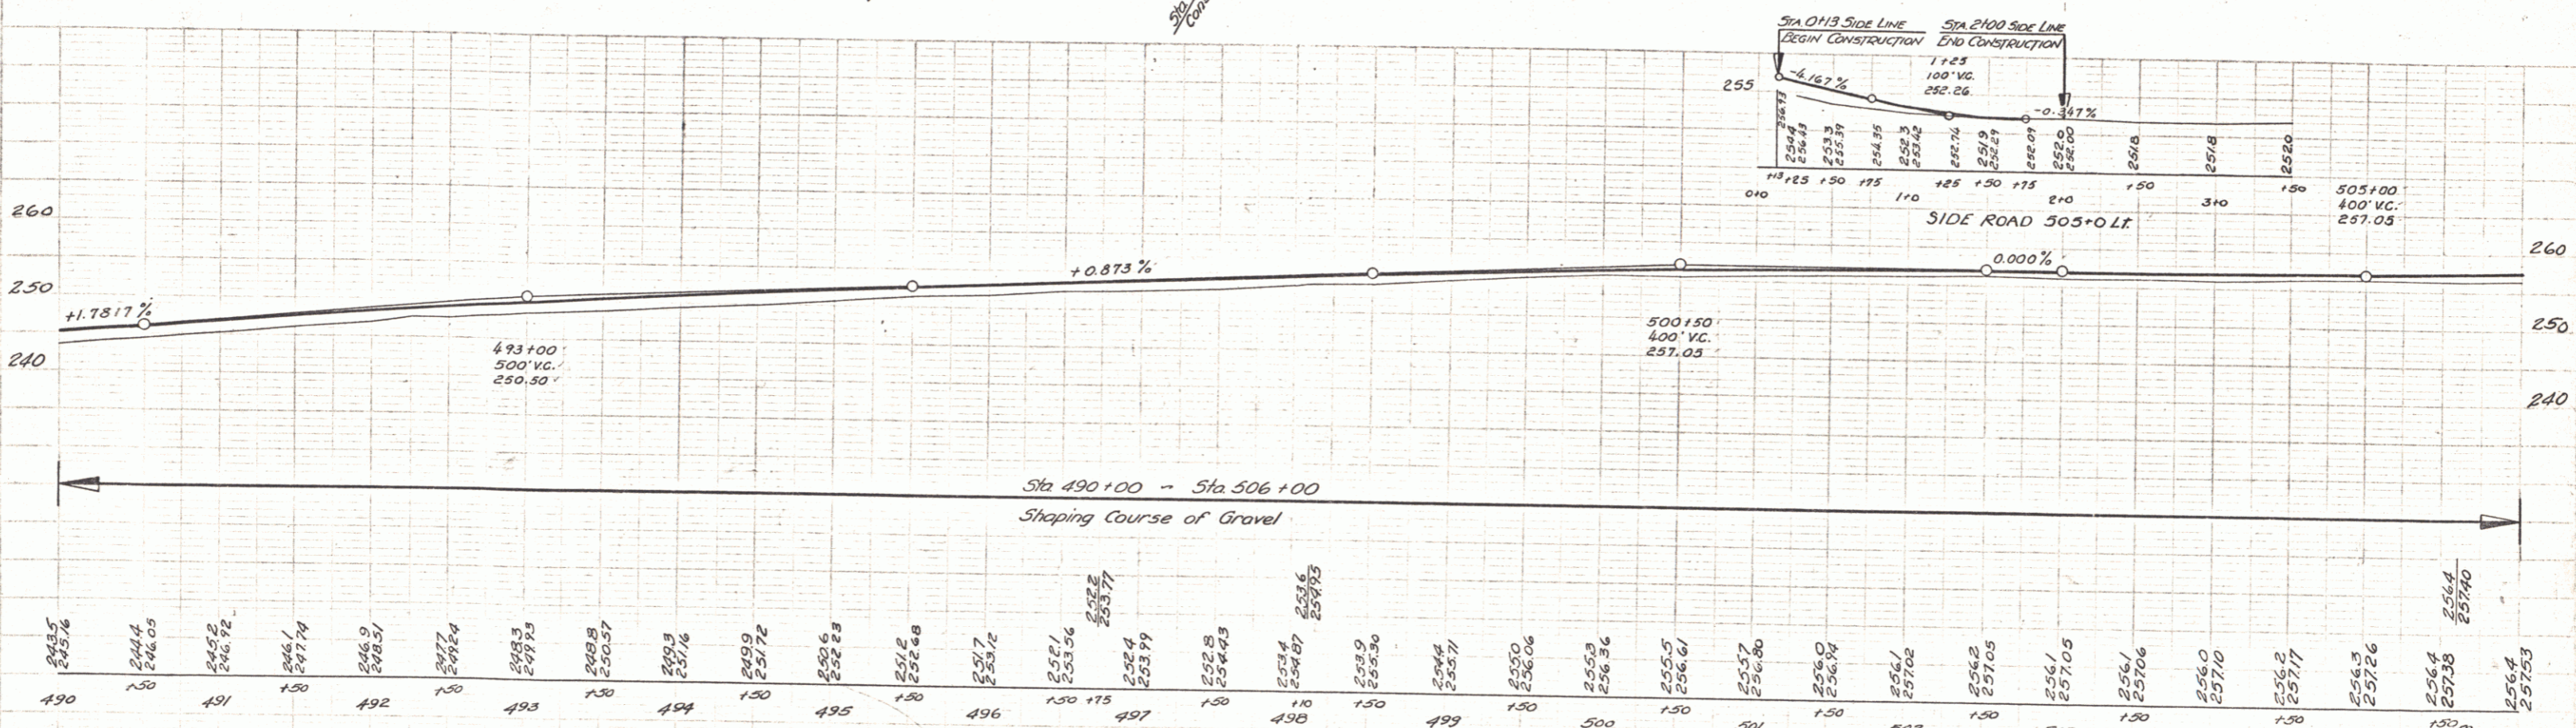


PARCEL	INSTRUMENT	DATE	GRANTOR	GRANTEE	RECORDED ADDITION	REMARKS
A	W.D.O.E.	10-10-46	GEO. H. & HILDA E. GARNEAU	ST. OF VT	BOOK 29 PAGE 259-260	10-19-46
B	W.D.O.E.	10-10-46	LAWRENCE & CECILE GEVRY	" " "	29 267-269	10-19-46
C	W.D.O.E.	10-10-46	LAWRENCE VINCENT	" " "	29 263-264	10-19-46

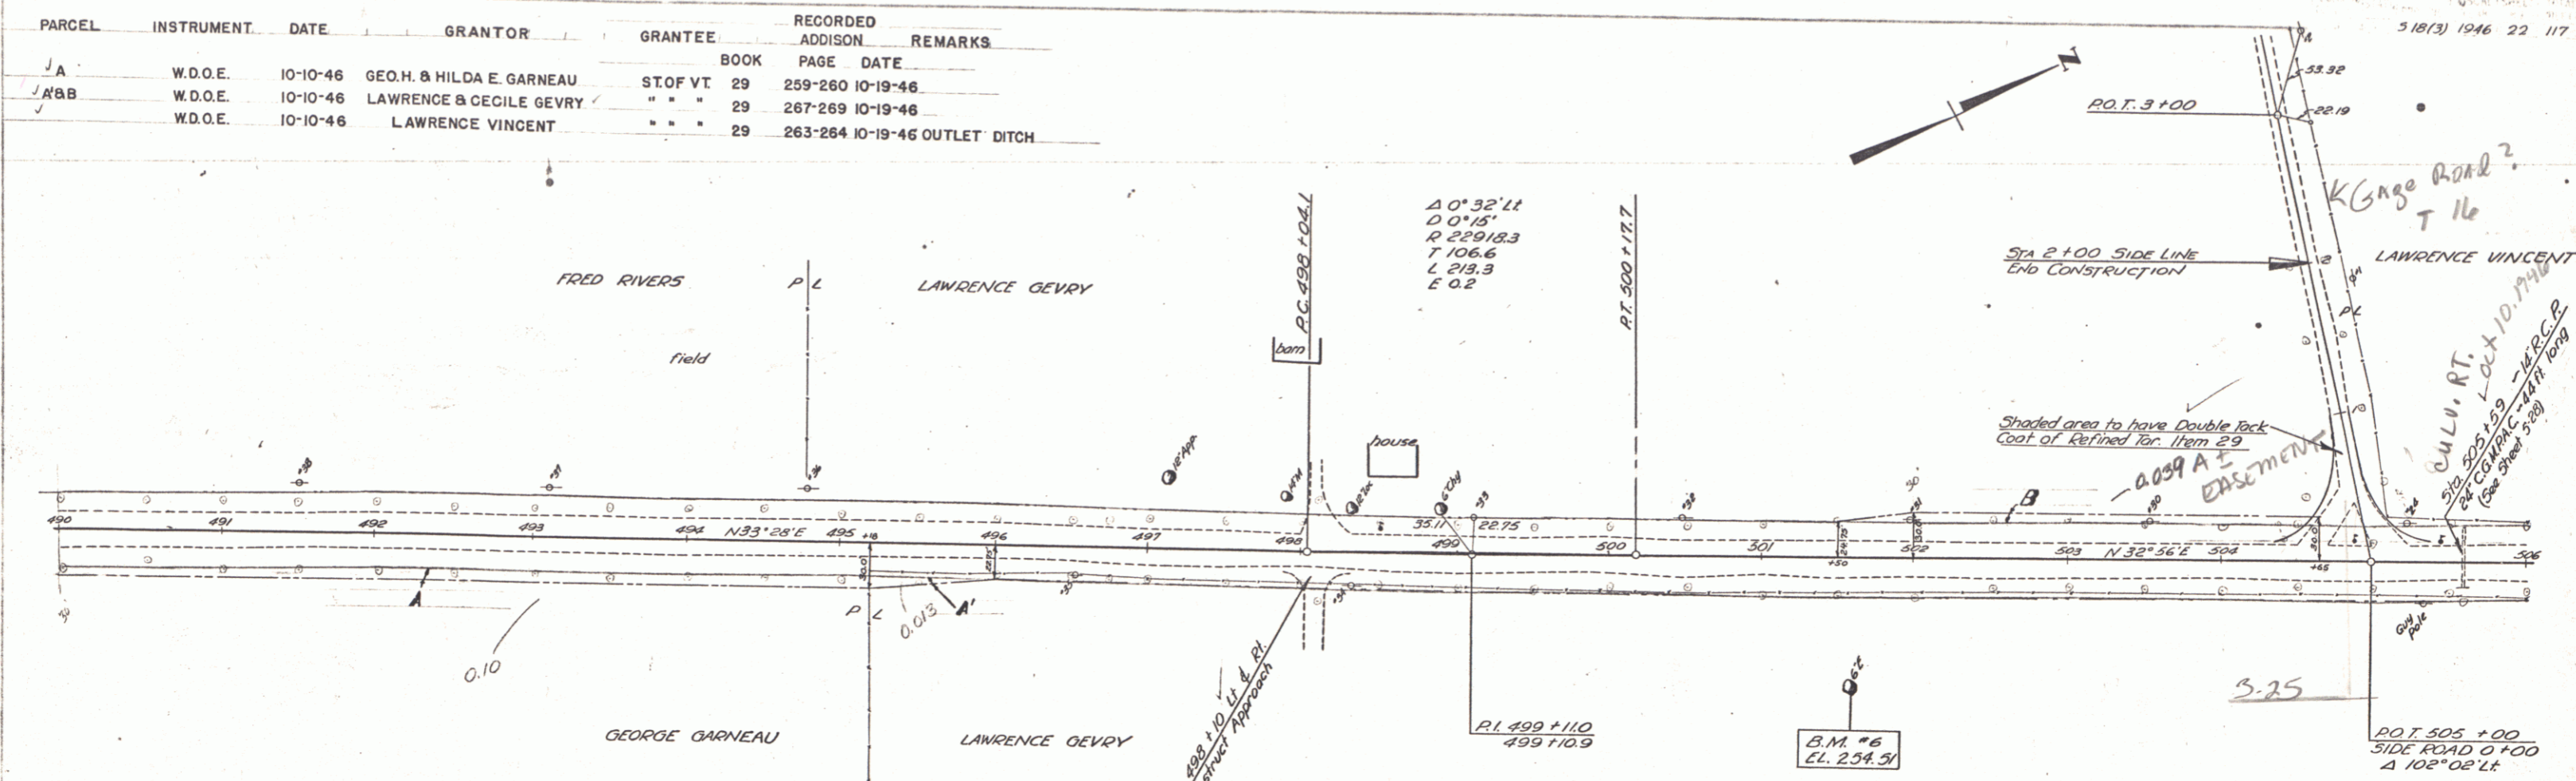

BM #6 E.I. 254.51 51.8' E. Clump 82 Ft. Rt. Sta 501+56

Bridgeport - Addition series 5 no. 18 (3) sheet 22 of 117 sheets