



PLAN  
 Spaulding  
 11-45  
 12-45  
 12-46  
 Traced  
 Lamin

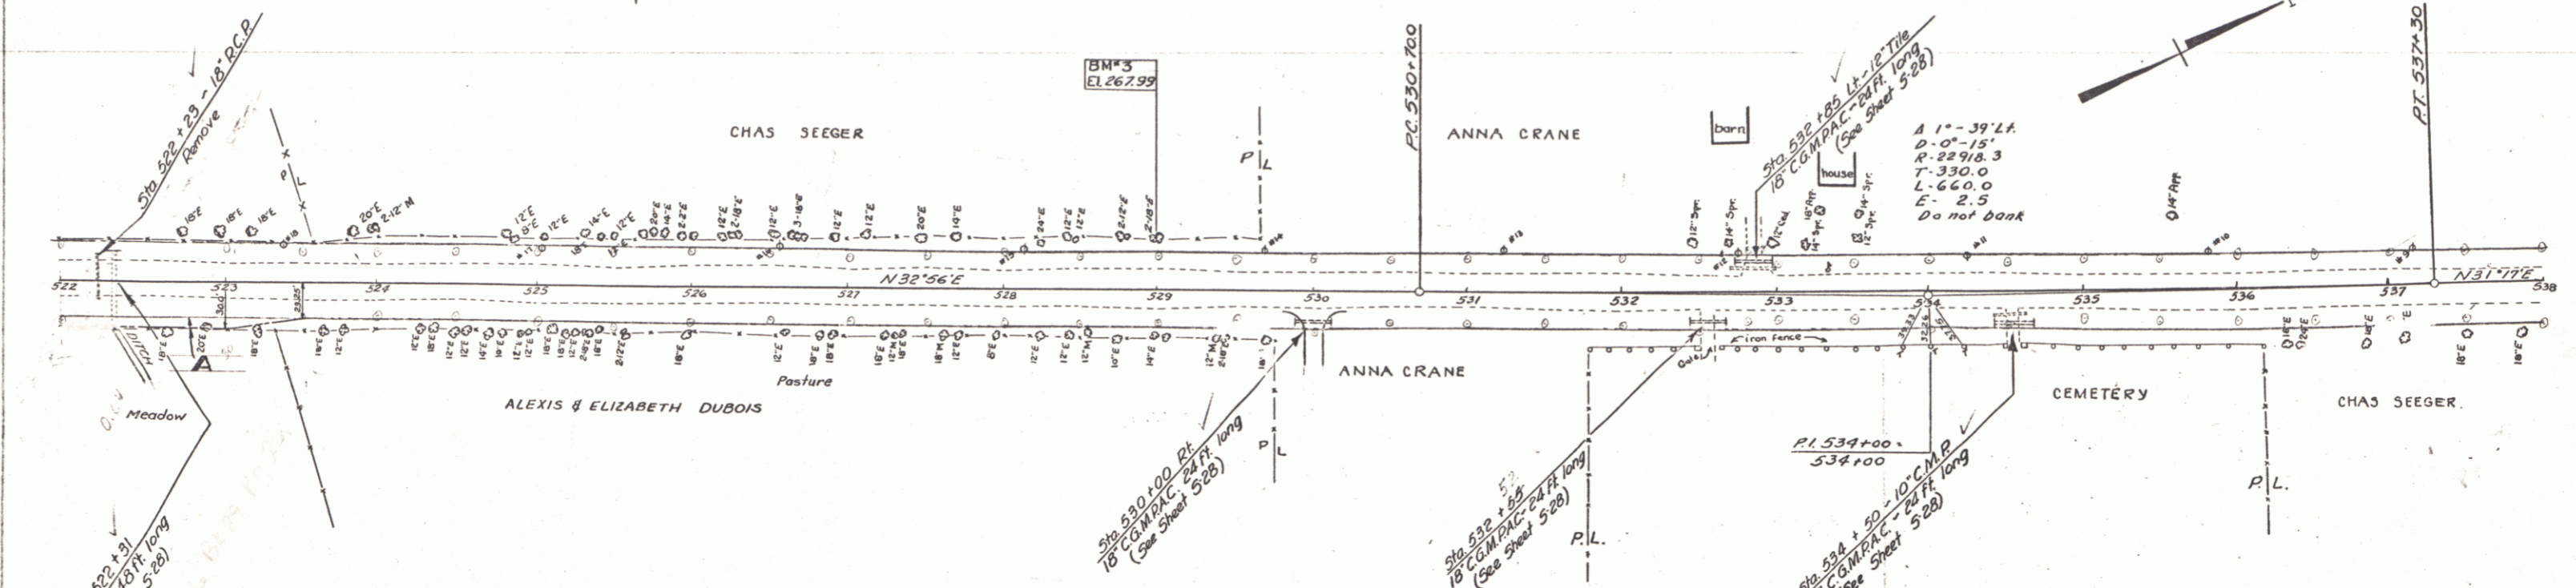

PARCEL	INSTRUMENT	DATE	GRANTOR	GRANTEE	RECORDED	REMARKS
A	W.D.O.E.	10-10-46	ALEXIS & ELIZABETH DUBOIS	ST. OF VT.	BOOK 29 PAGE 261	10-19-46

PLAN  
 Spaulding  
 11-45  
 12-45  
 12-46  
 Traced  
 Lamin

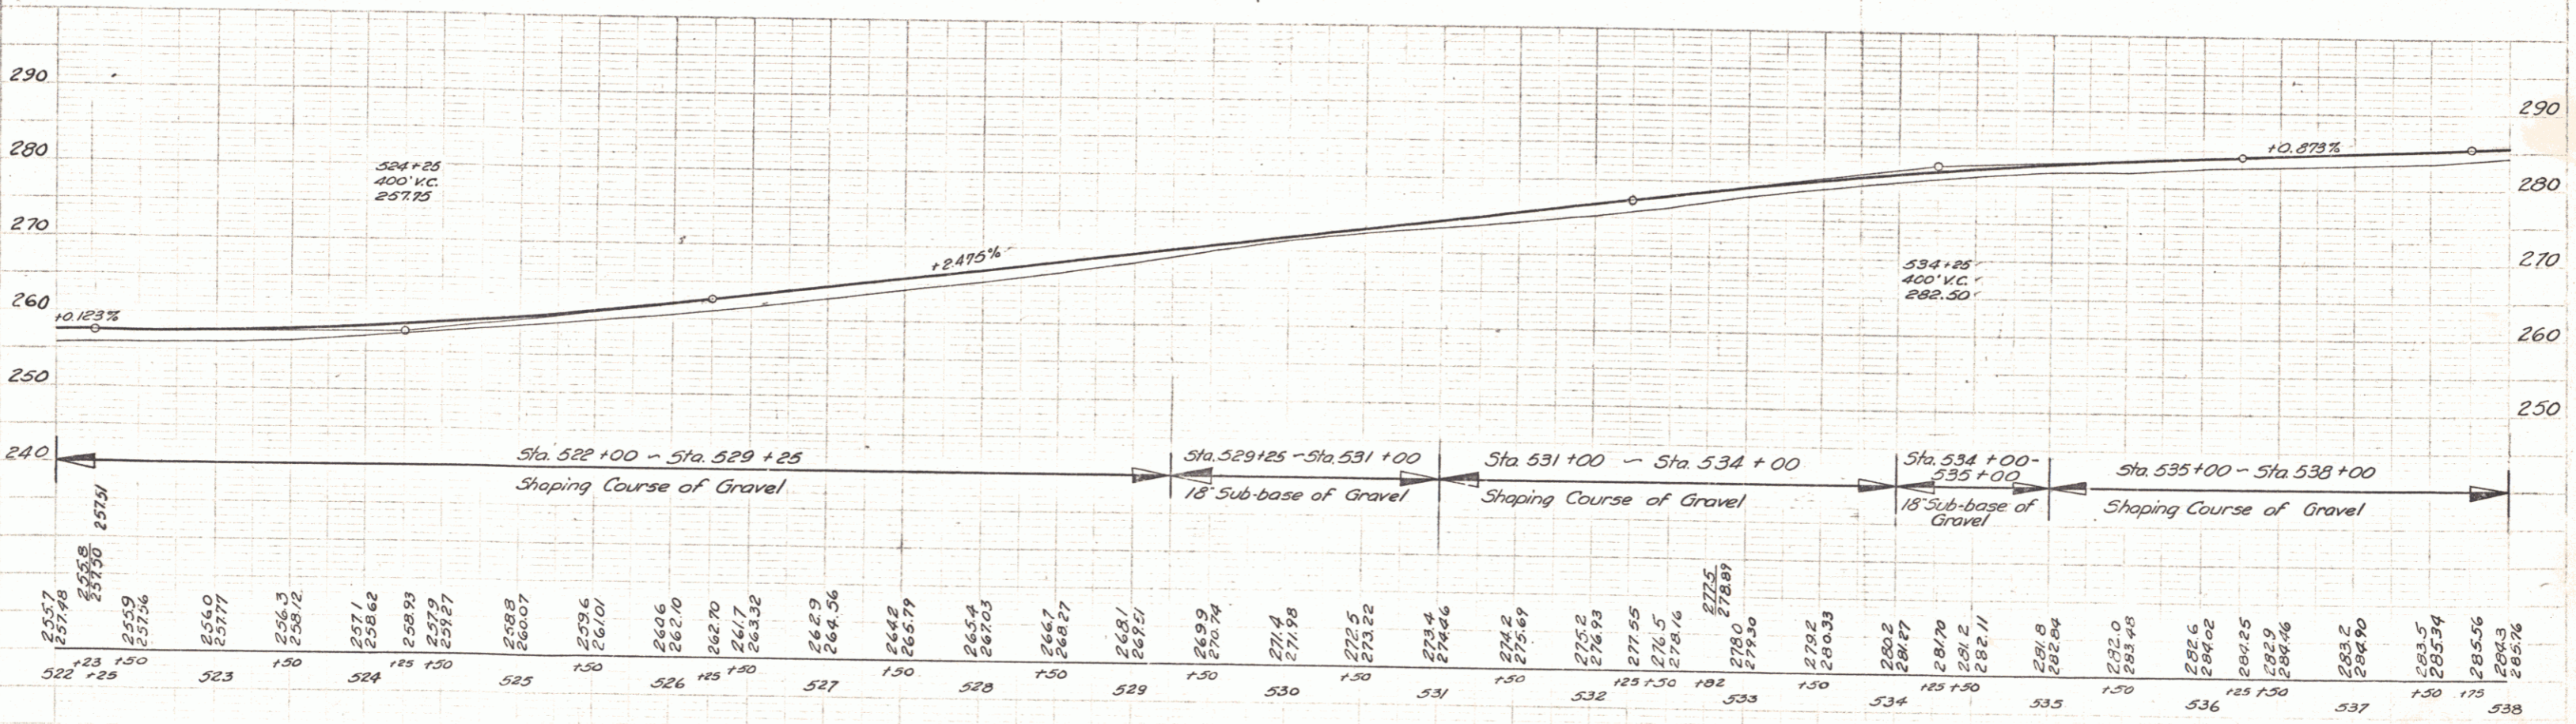

BN #3 EL 267.99 S/C 18" Twin E 31/F/Lt Sta 528+39

Bridport - Addison  
 Series 5 no. 18 (B)  
 sheet 24 of 117 sheets