


Sta	CULVERT QUANTITIES				GUIDE POSTS	
	Size	Length	Cost	Exc.	LT	RT
268+34	18"	12'			1-	1-
268+50	12"	20'			1-	1-

FED. ROAD DIST. NO.	STATE	PROJ. NO.	FISCAL YEAR	SHEET NO.	TOTAL SHEETS
9	VT	142	1933	5	34

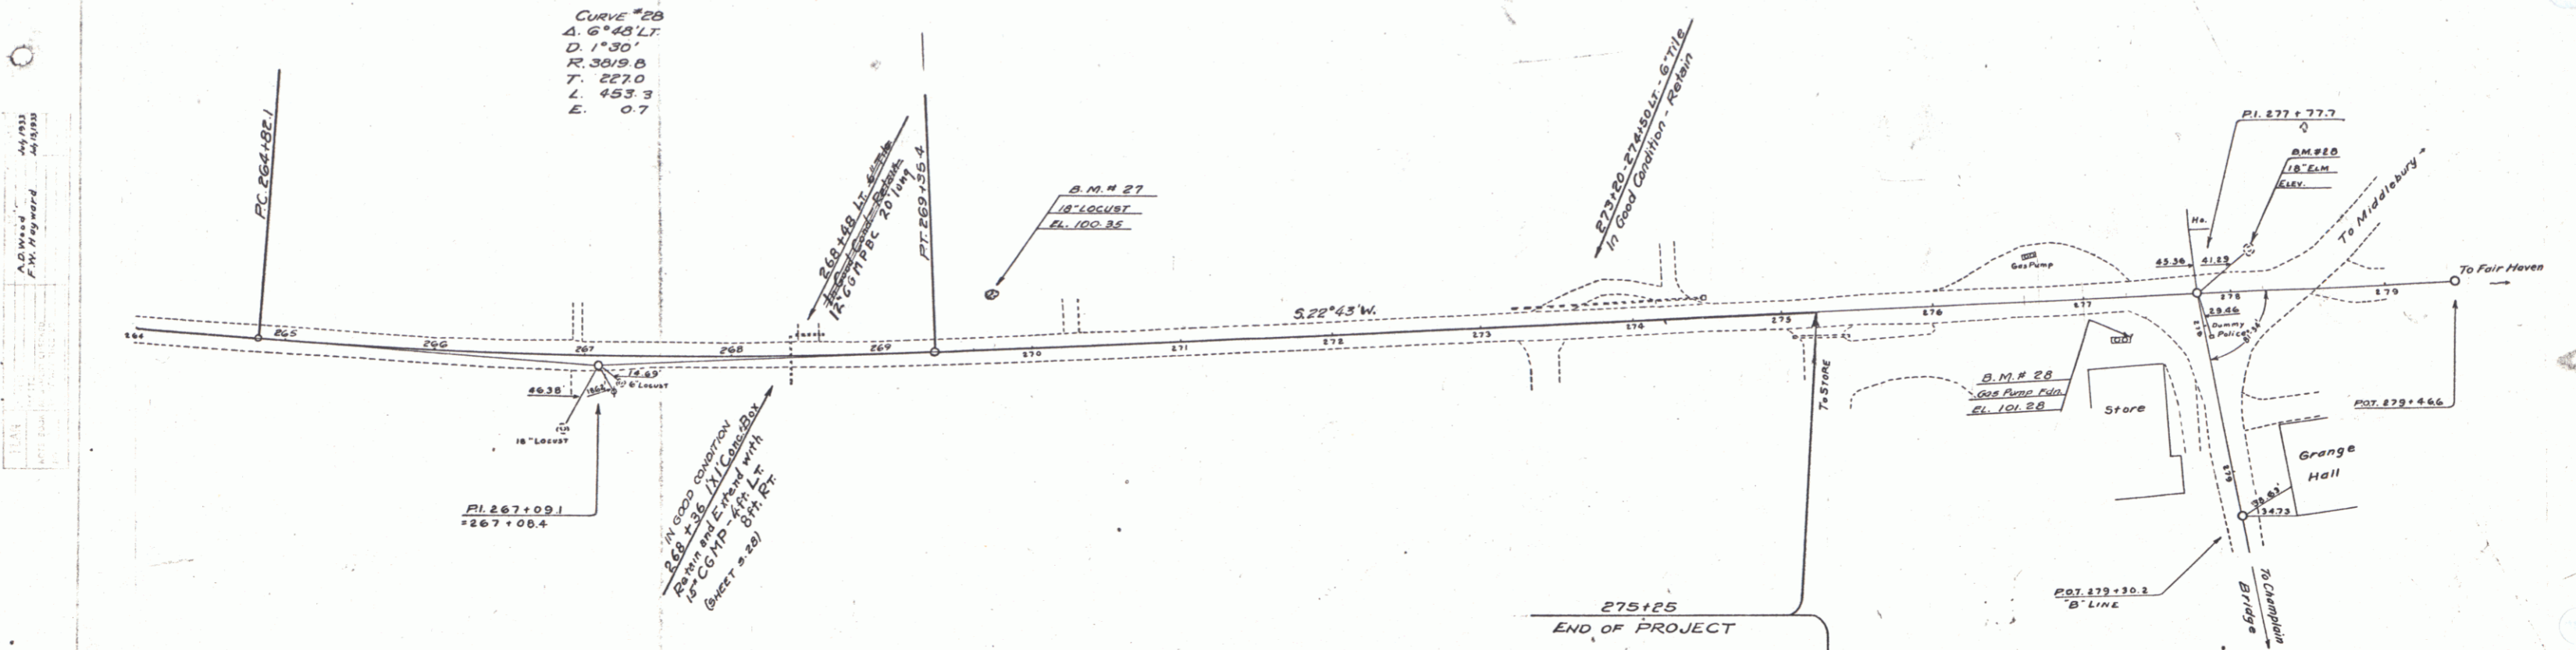

Station	Elevation	Station	Elevation	Station	Elevation
264	98.20	268	99.05	272	98.80
265	98.70	269	99.09	273	99.02
266	99.00	270	99.12	274	99.06
267	99.11	271	99.16	275	99.09
268	99.17	272	99.20	276	99.11
269	99.20	273	99.22	277	99.13
270	99.23	274	99.24	278	99.15
271	99.25	275	99.26	279	99.16
272	99.27	276	99.28	280	99.17
273	99.28	277	99.29		
274	99.30	278	99.31		
275	99.32	279	99.33		
276	99.34	280	99.35		
277	99.36				
278	99.38				
279	99.40				
280	99.42				

B.M. #27 - SPIKE IN ROOT 18' LOCUST 35 FT. LT. STA 269+75 - ELEV. 100.35.
 B.M. #28 - SPOT ON CONC. GAS PUMP FDN. 27 FT. RT. STA 271+29 - ELEV. 101.50

TOWN OF ADDISON
 SERIES JRS No. 142
 Sheet 6 of 34