


PLAN
 DATE: 5.22.62
 DRAWN BY: [Signature]
 CHECKED BY: [Signature]
 NO. 1

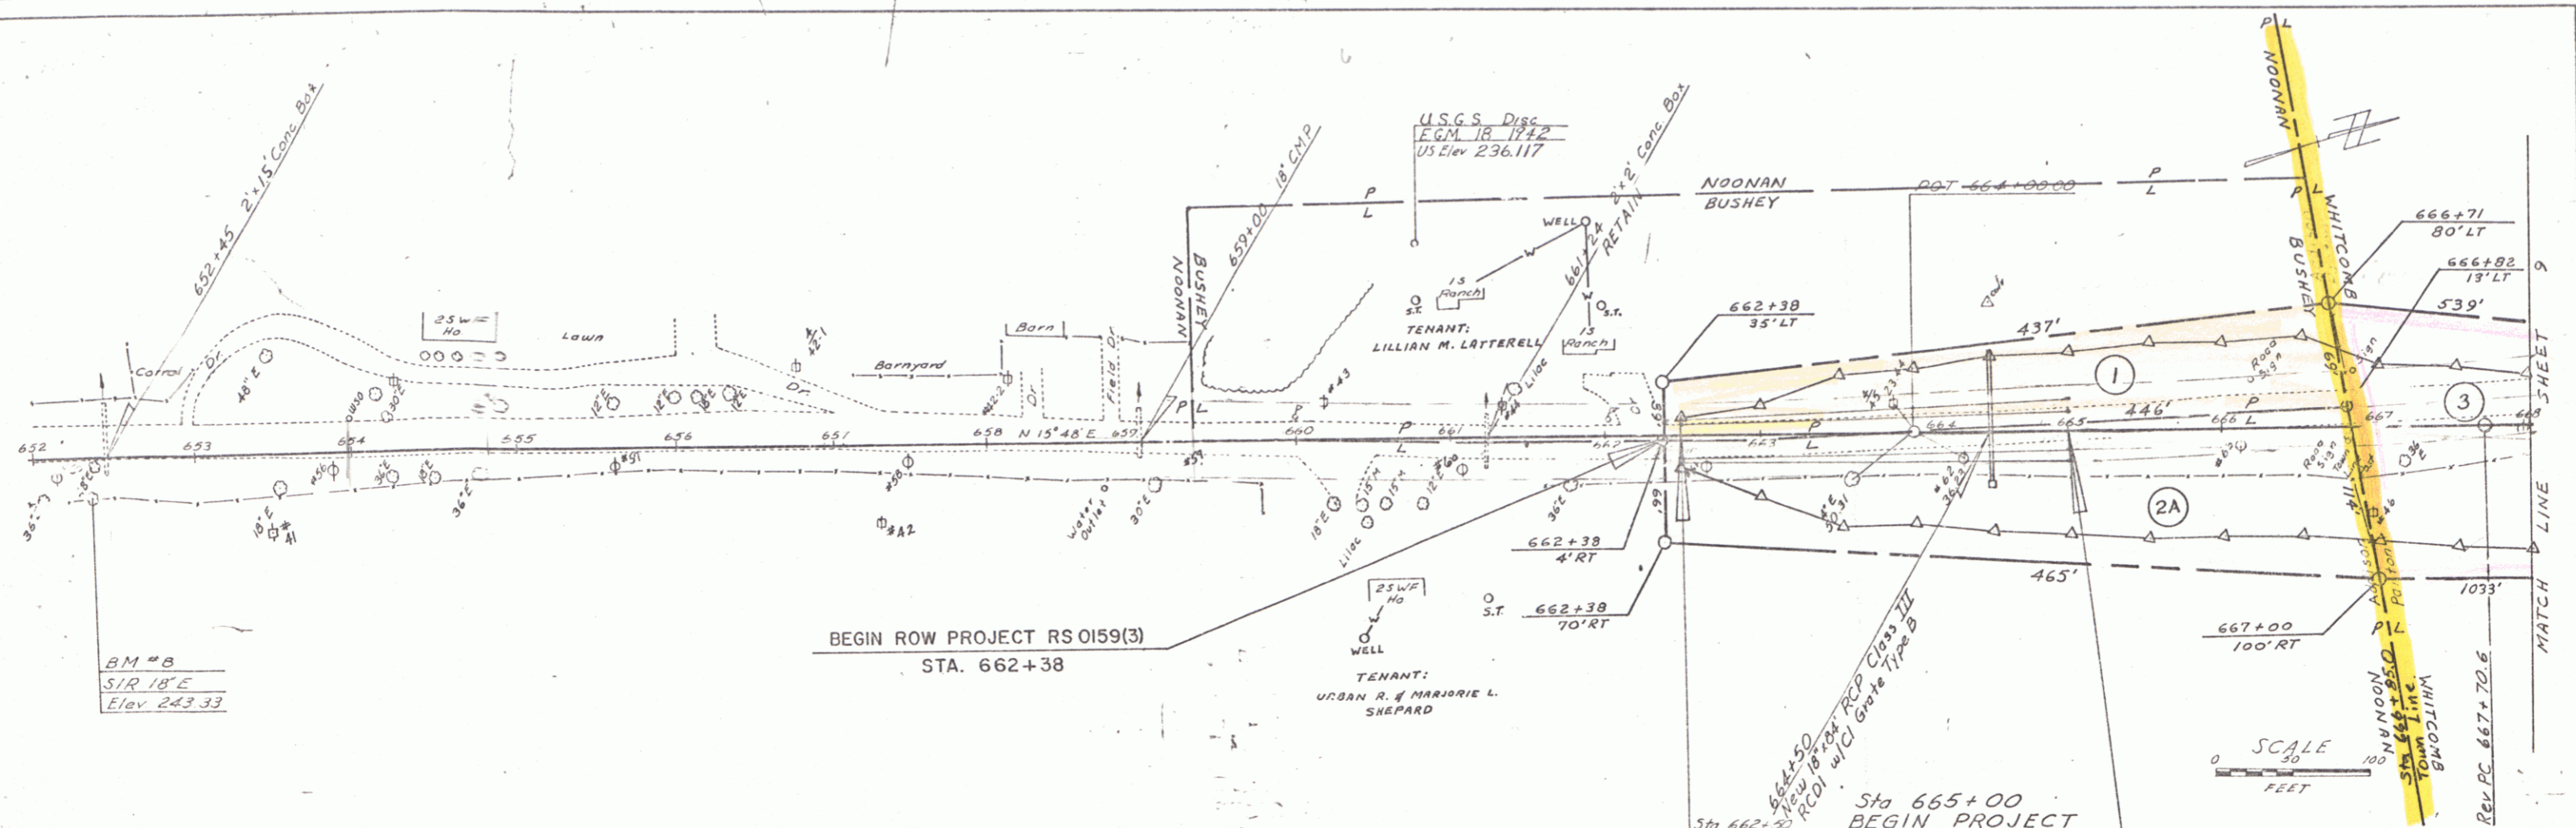

BM # 8
 SIR 18'E
 Elev 243.33


BEGIN ROW PROJECT RS 0159(3)
 STA. 662+38

SCALE
 1" = 40'

CONSTRUCTION NOTES:
 Drains are to be constructed to a minimum width of 12 feet with a minimum slope of 1% on the three areas indicated on the plans, or directed by the Engineer.
 All existing pavement within 2 feet of the subgrade shall be thoroughly scarified and broken up, payment to be included under the bid price at Common Excavation Item 123.6.1

Sta 662+50
 Begin Approach Construction
 Sta 665+00
 BEGIN PROJECT
 Construct Satisfactory Approach

PROFILE
 DATE: 5.22.62
 DRAWN BY: [Signature]
 CHECKED BY: [Signature]
 NO. 1

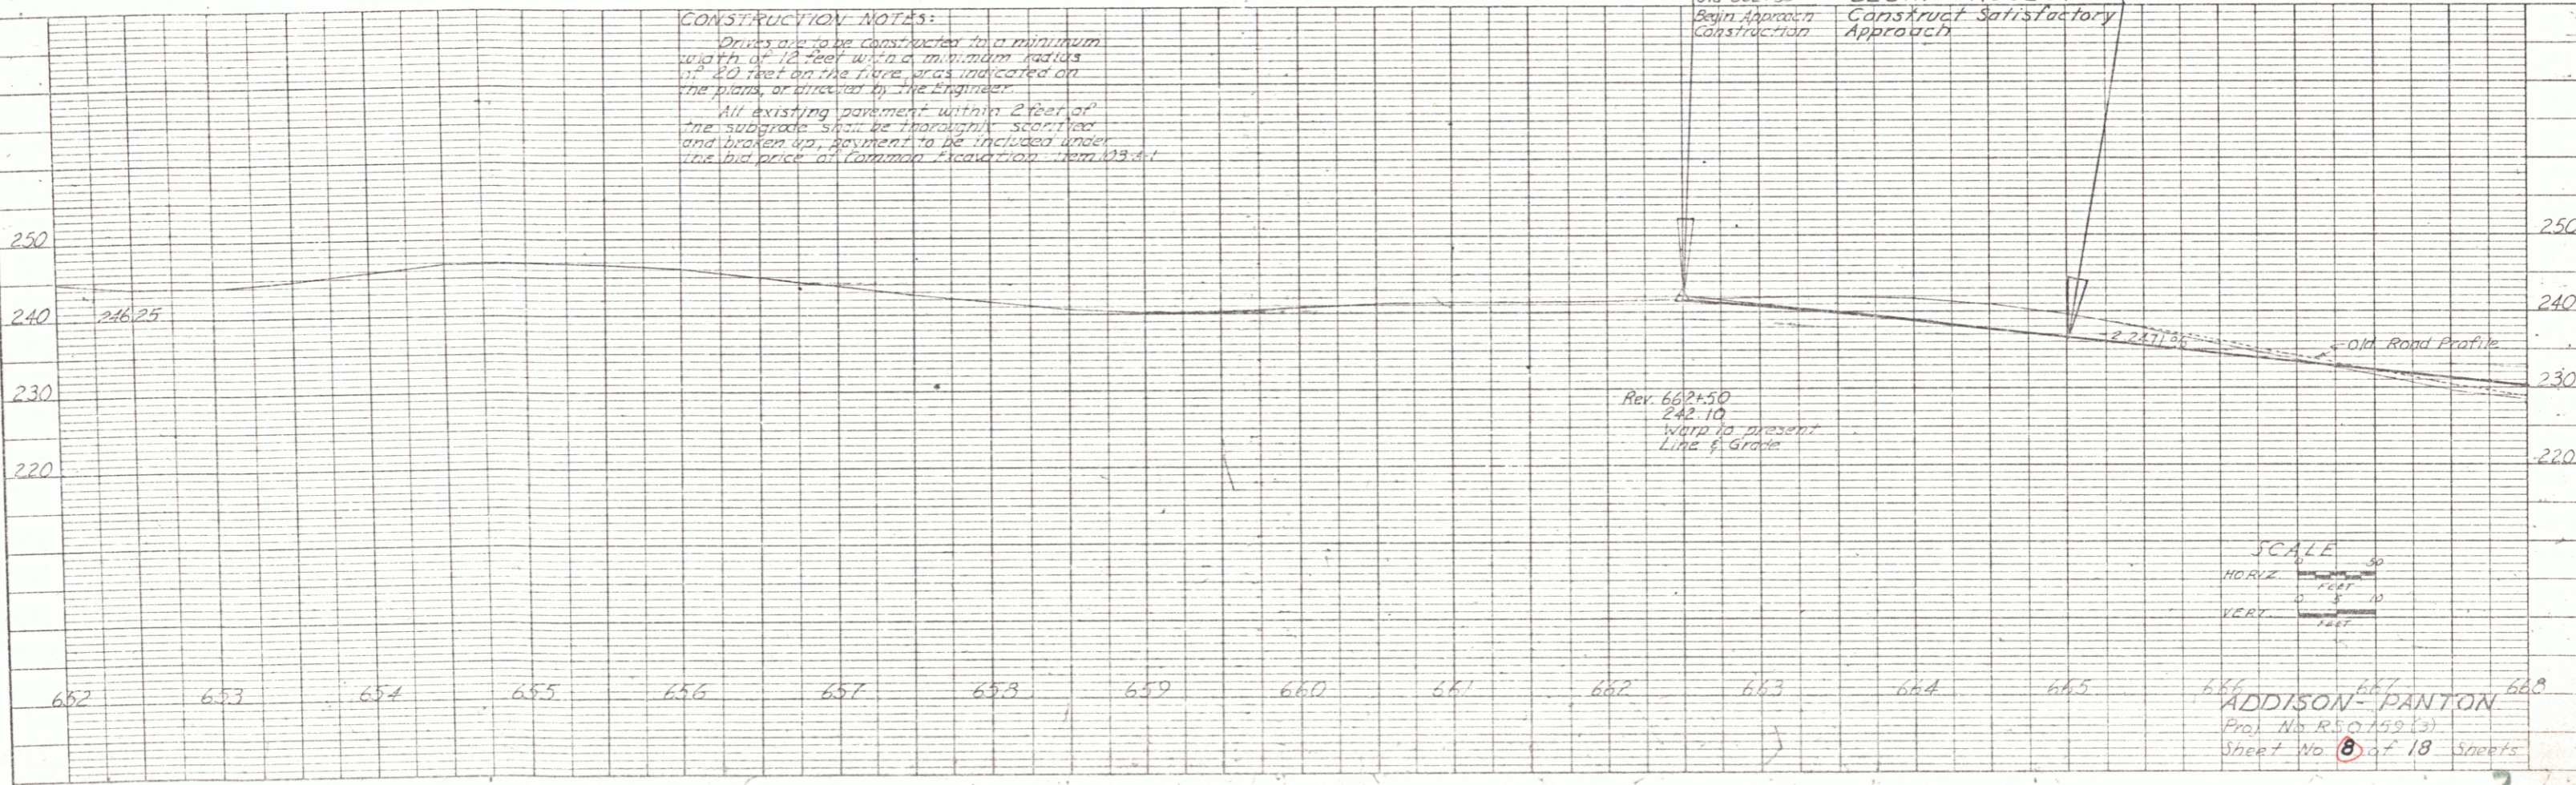

SCALE
 HORIZ: 1" = 40'
 VERT: 1" = 10'

ADDISON-PANTON
 Proj. No. RS 0159(3)
 Sheet No. 8 of 18 Sheets