
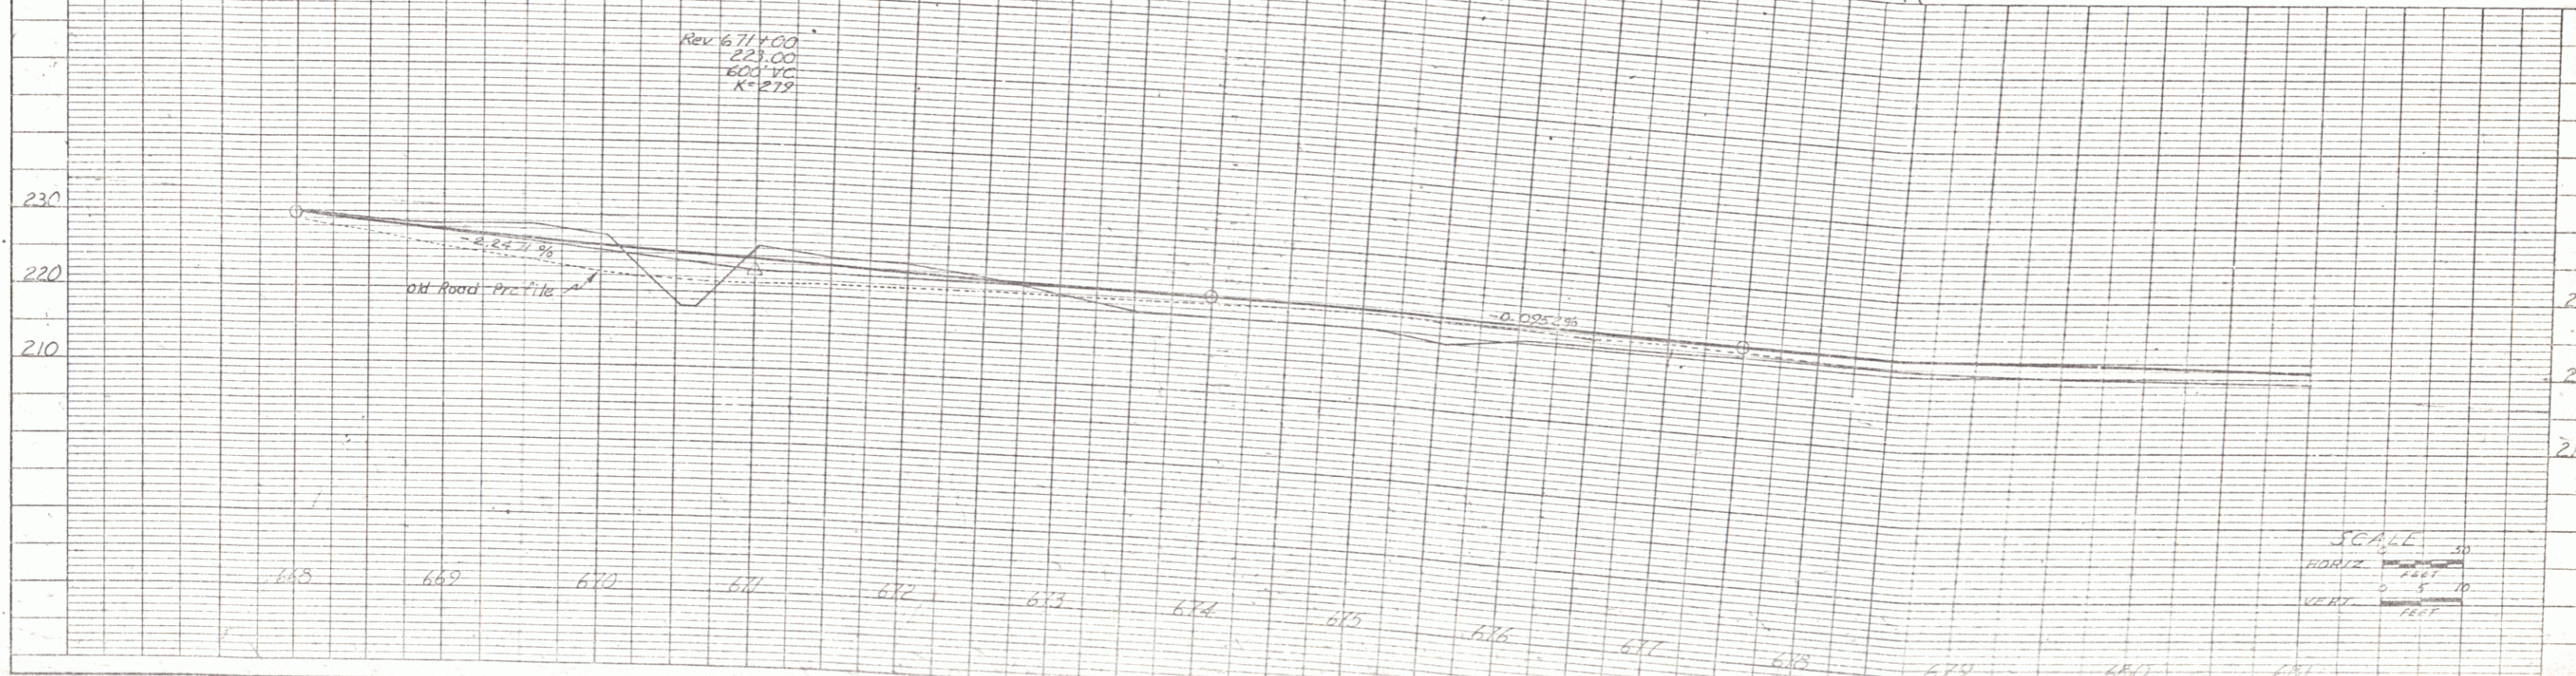


PLAN  
 DRAWN BY: [Signature]  
 CHECKED BY: [Signature]  
 DATE: 5-88  
 SCALE: AS SHOWN  
 NOTE: ALL DIMENSIONS IN FEET UNLESS OTHERWISE NOTED.  
 ALL WORK TO BE DONE IN ACCORDANCE WITH THE SPECIFICATIONS.

PROFILE  
 DRAWN BY: [Signature]  
 CHECKED BY: [Signature]  
 DATE: 5-88  
 SCALE: AS SHOWN  
 NOTE: ALL DIMENSIONS IN FEET UNLESS OTHERWISE NOTED.  
 ALL WORK TO BE DONE IN ACCORDANCE WITH THE SPECIFICATIONS.

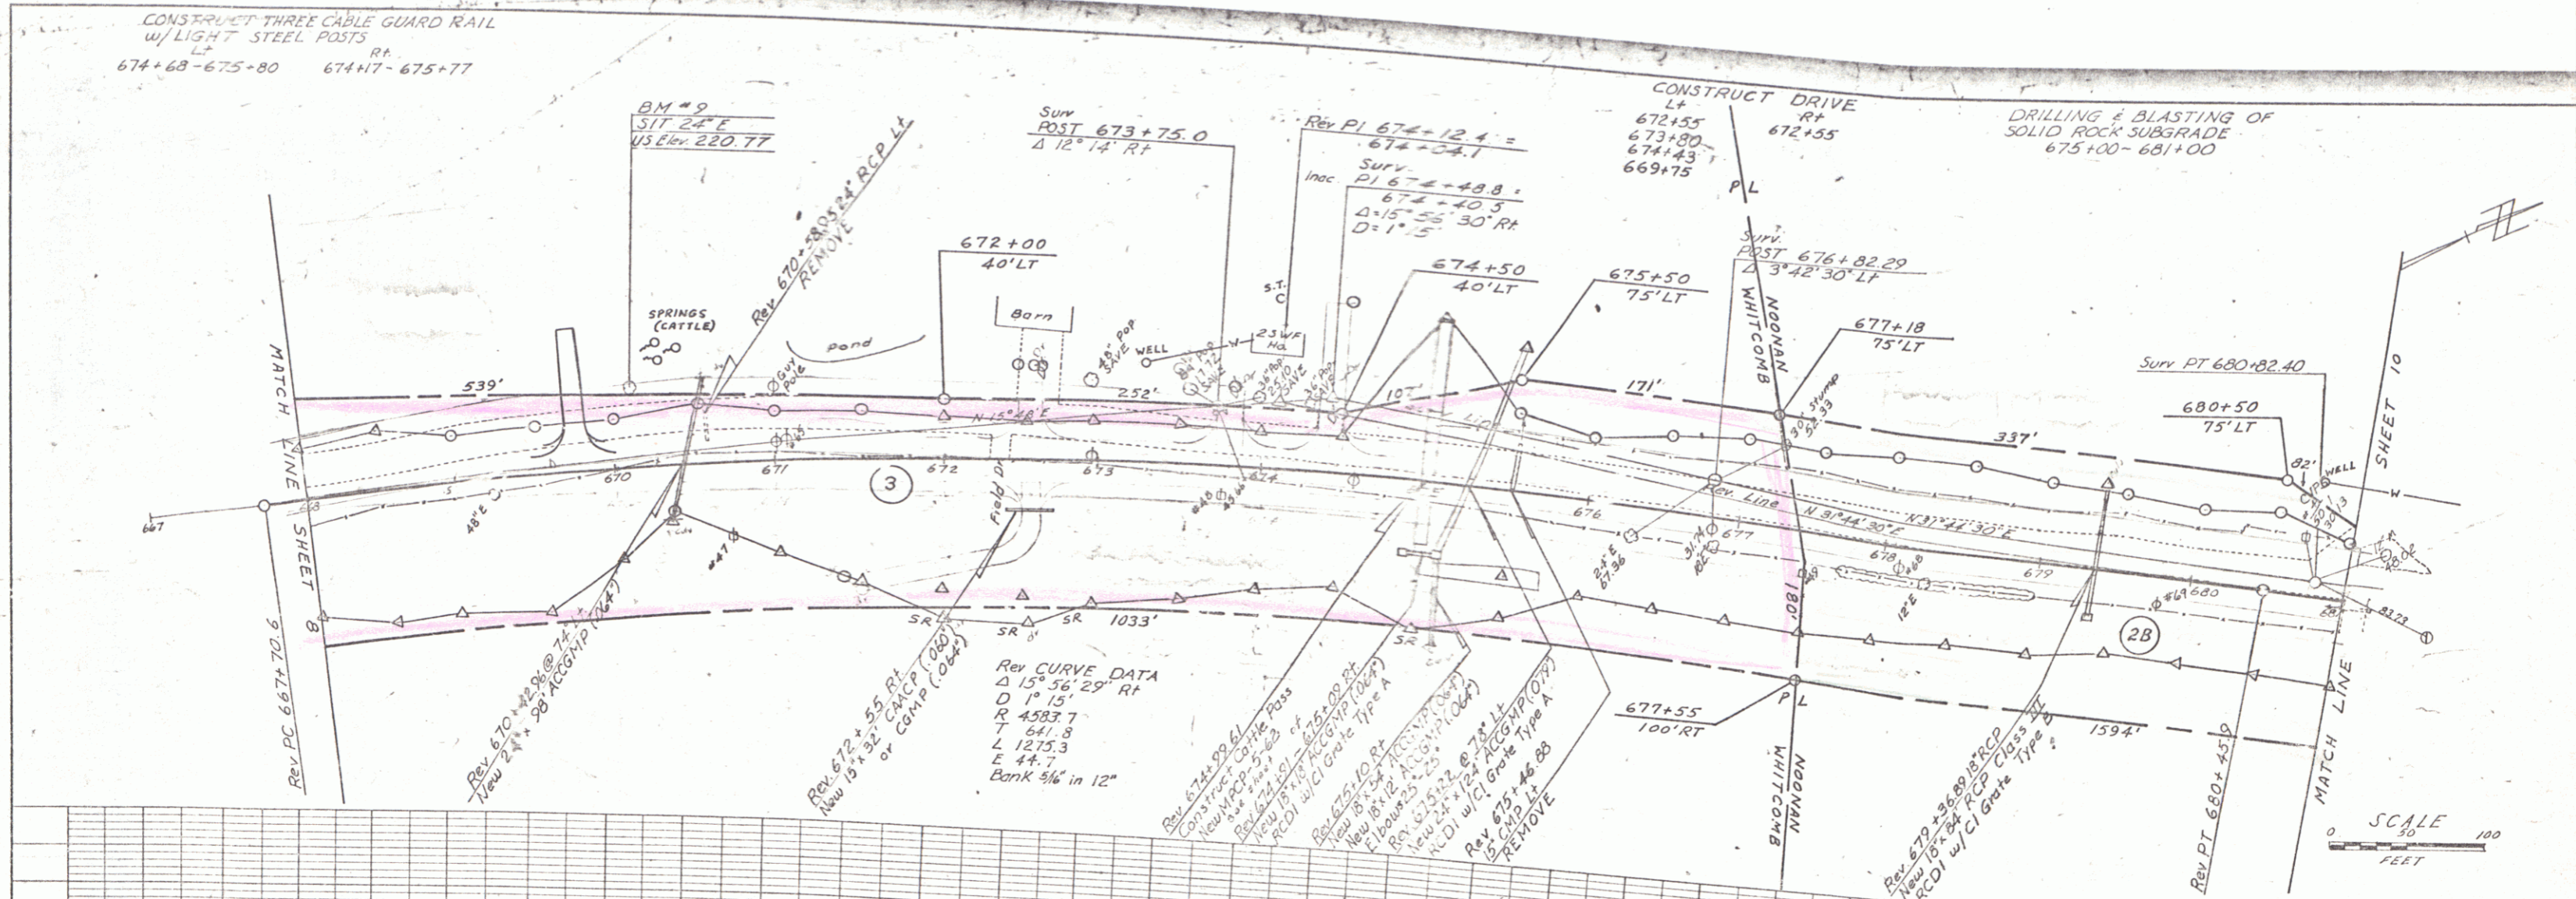

K&E PLATE 1, PLAN/PROFILE  
 10/10/88

ADDISON - PANTON  
 Proj No. RS015013  
 Sheet No. 9 of 18 Sheets