


Smith & Pava
4-65
Pava
4-65
Leonard

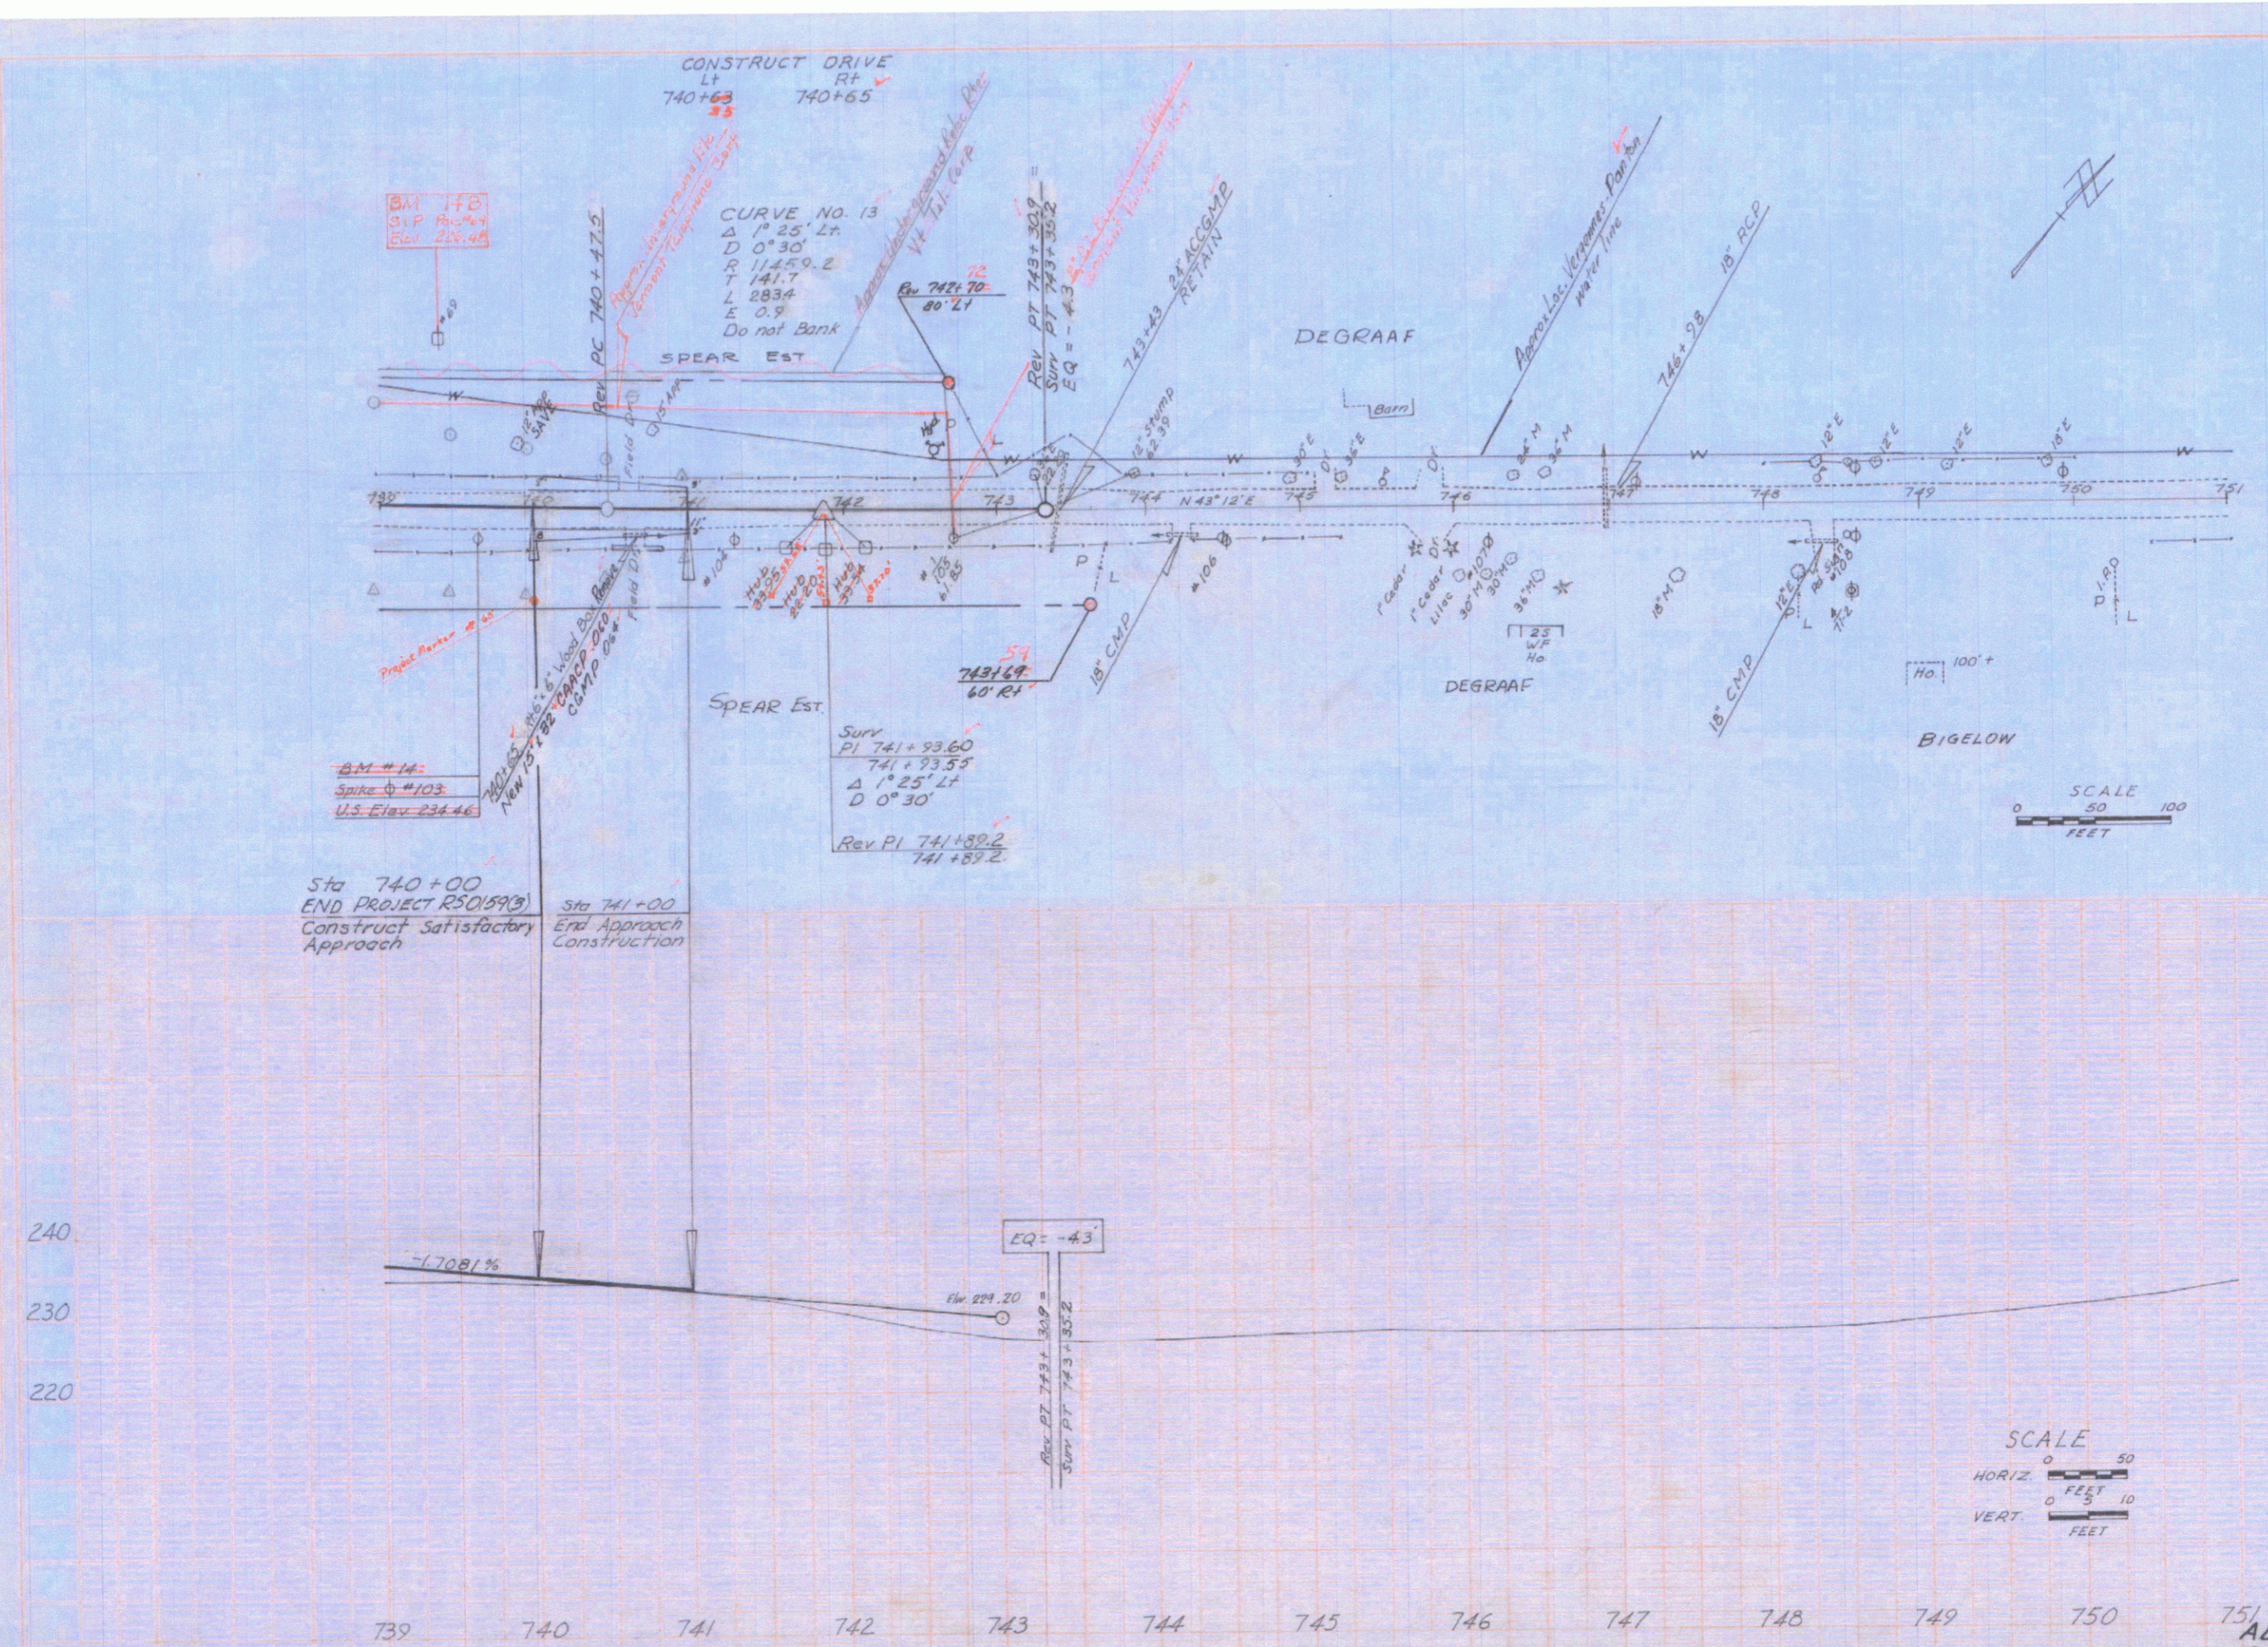

Sta 740+00
END PROJECT R50159(3)
Construct Satisfactory
Approach

Sta 741+00
End Approach
Construction

SCALE
HORIZ. 0 50
FEET
VERT. 0 5 10
FEET

751
ADDISON - PANTON
Proj No. R50159(3)
Sheet No. 22 of 93 Sheets