


PARCEL	INSTRUMENT	DATE	GRANTOR	GRANTEE	RECORDED HARDWICK BOOK PAGE	REMARKS
A	W.D.O.E.	10-20-42	ALPHEGE & ANNE MARIE LEMAY	ST OF VX	40 441	12-10-42
A <sup>1</sup>	W.D.O.E.	9-12-42	Geo. OLIVETTE GUILLET	ST OF VX	40 413	9-18-42
A <sup>2</sup>	W.D.O.E.	10-3-42	J. B. SILVER	ST OF VX	40 443-44	12-15-42
A <sup>3</sup>	W.D.O.E.	12-7-42	EDITH LAMONDA	ST OF VX	40 442	12-10-42

NOTE: Sta. 35+00 - 38+50 and 43+50 - 52+00 Poor Foundation Material to be removed as shown on plans or as ordered by the Engineer. Poor Foundation Material to be used on embankment between Vanite and land slope at locations shown on plans or as ordered by the Engineer. Hauling, rehandling and disposal of Poor Foundation Material to be included in bid-price for Common Excavation Incl. Borrow, Item 10-11. Excavation of Poor Foundation Material to be paid for as Common Excavation including Borrow Item 10-11, measured in its original location.

Note: Grade from Sta 39+50 to end of project raised 1.0'

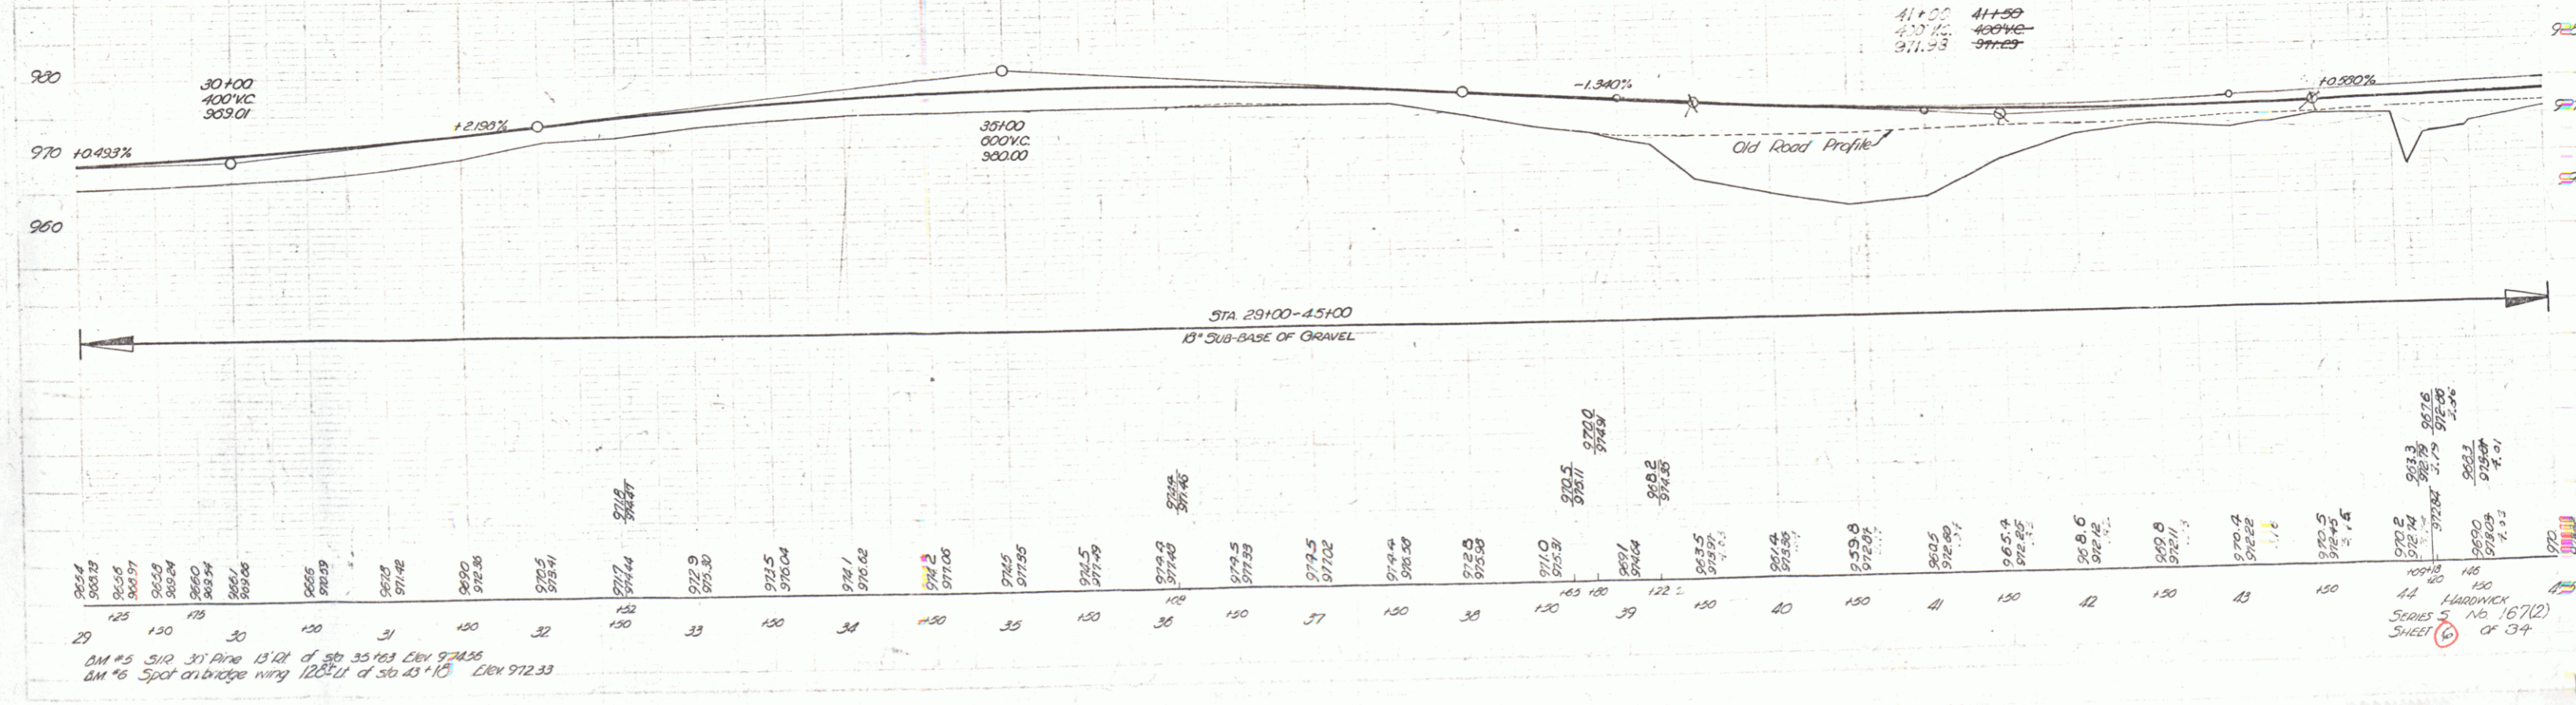

DM #5 512 31 Ave 13'12" d. 30 35'103 Elev 974.36  
DM #6 Spot on bridge wing 120'11" d. 30 45'10 Elev 972.33

44 HARDWICK SERIES NO. 67(12) SHEET 34 OF 34