


NOTE: Construct Open Ditch Sta. 49+00-50+50 RT, to be paid for as Common Excavation Incl. Barrow, Item 10-11.

REV. CURVE	Δ	12°00'00"	D	3"	R	1810.1	T	2007.1	L	400.0	E	10.5	Bank	3/4	Per	FT.
PARCEL	INSTRUMENT	DATE	GRANTOR	GRANTEE	RECORDED	REMARKS										
B, C	W. D. O. E.	10-3-42	J. B. SILVER	ST OF VT.	40	443-44	12-15-42									
B'	W. D. O. E.	12-7-42	EDITH LAMONDA	ST OF VT.	40	442	12-10-42									

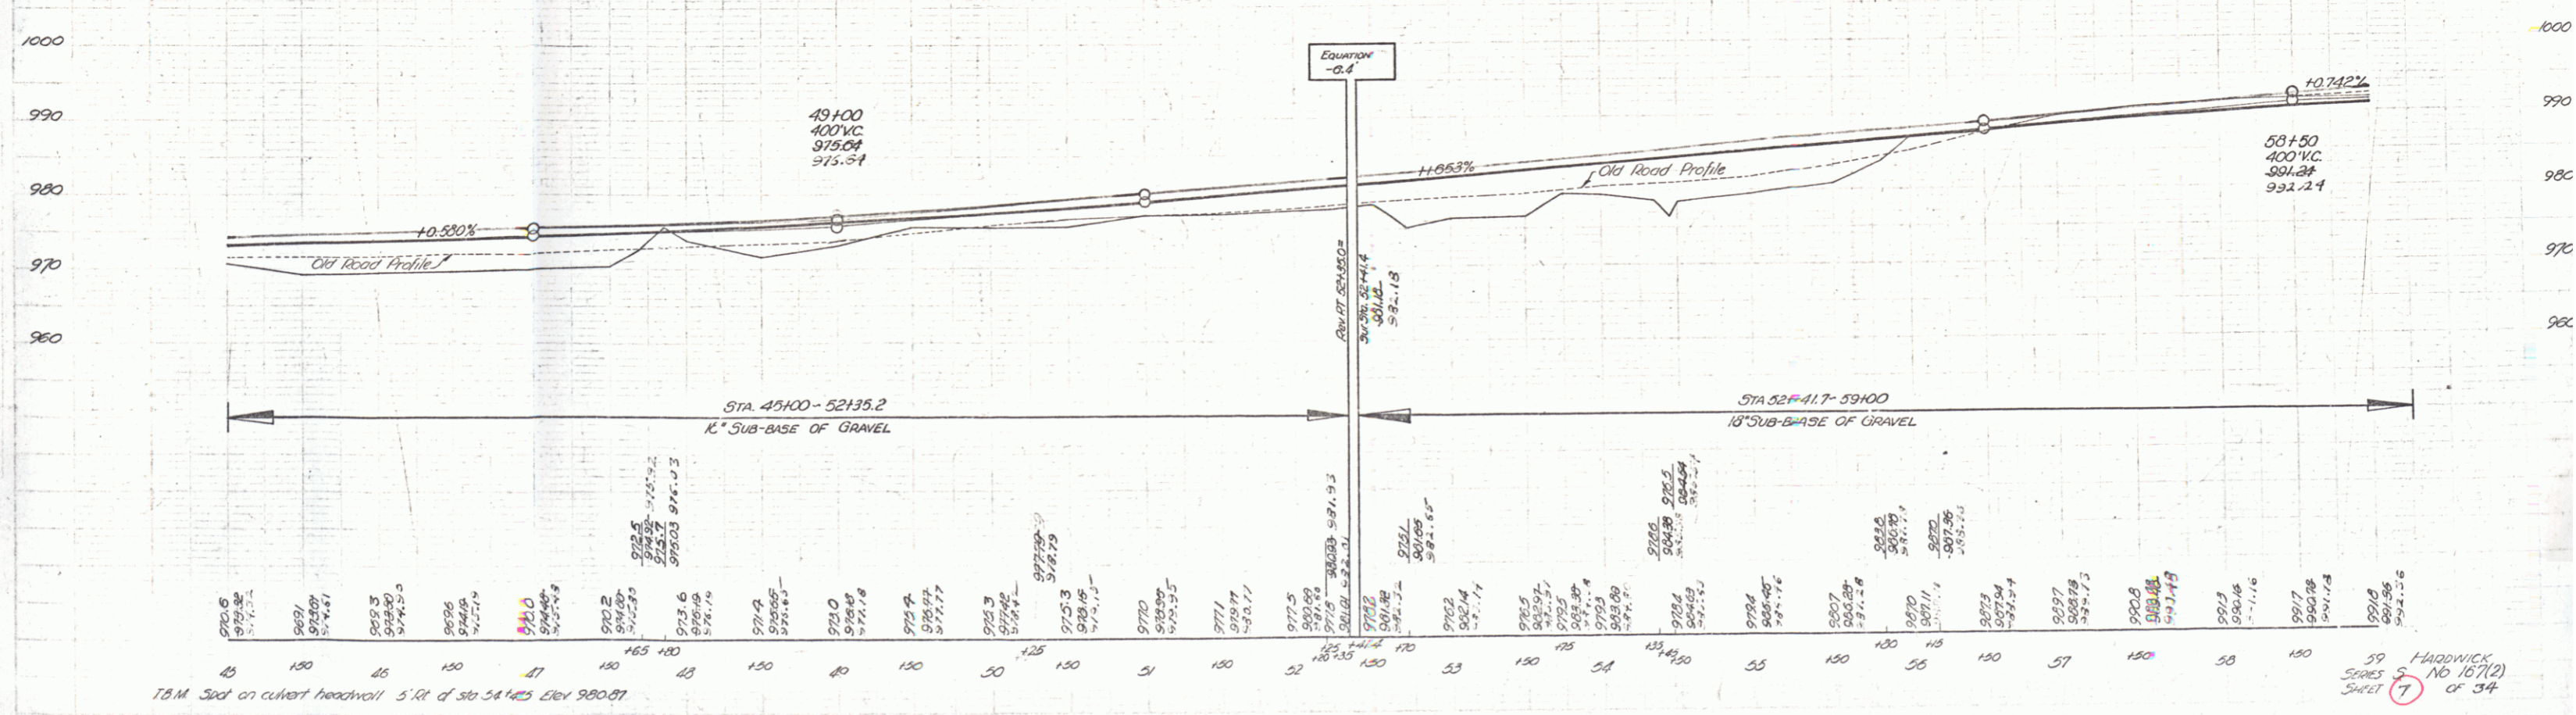

5 1078
2 Lower
142

5 1078
2 Lower
142

T.M. Sect on culvert headwall 5' RI of Sta 54+425 Elev 980.81

59 HADWICK
SHEET 5 NO. 167(2)
7 OF 34