



JOHN B. SILVER
 PARCEL # 1
 INSTRUMENT W. D. O. E.
 DATE 7-10-90
 GRANTOR ROBERT & RUTH PHILBROOK
 GRANTEE ST. OF VT.
 RECORDED HARDWICK
 BOOK 48
 PAGE 77
 DATE 7-26-90
 REMARKS: CONT. ON SHEET 29

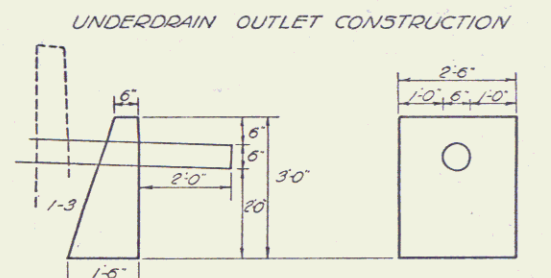

Cement Rubble Masonry Headwall Item 411
 Wood Guide Posts Item 542 to indicate outlet
 6 Perforated Asphalt Coated Cor. Galv. Metal
 Underdrain Item 531 Pipe to extend 2'-0"

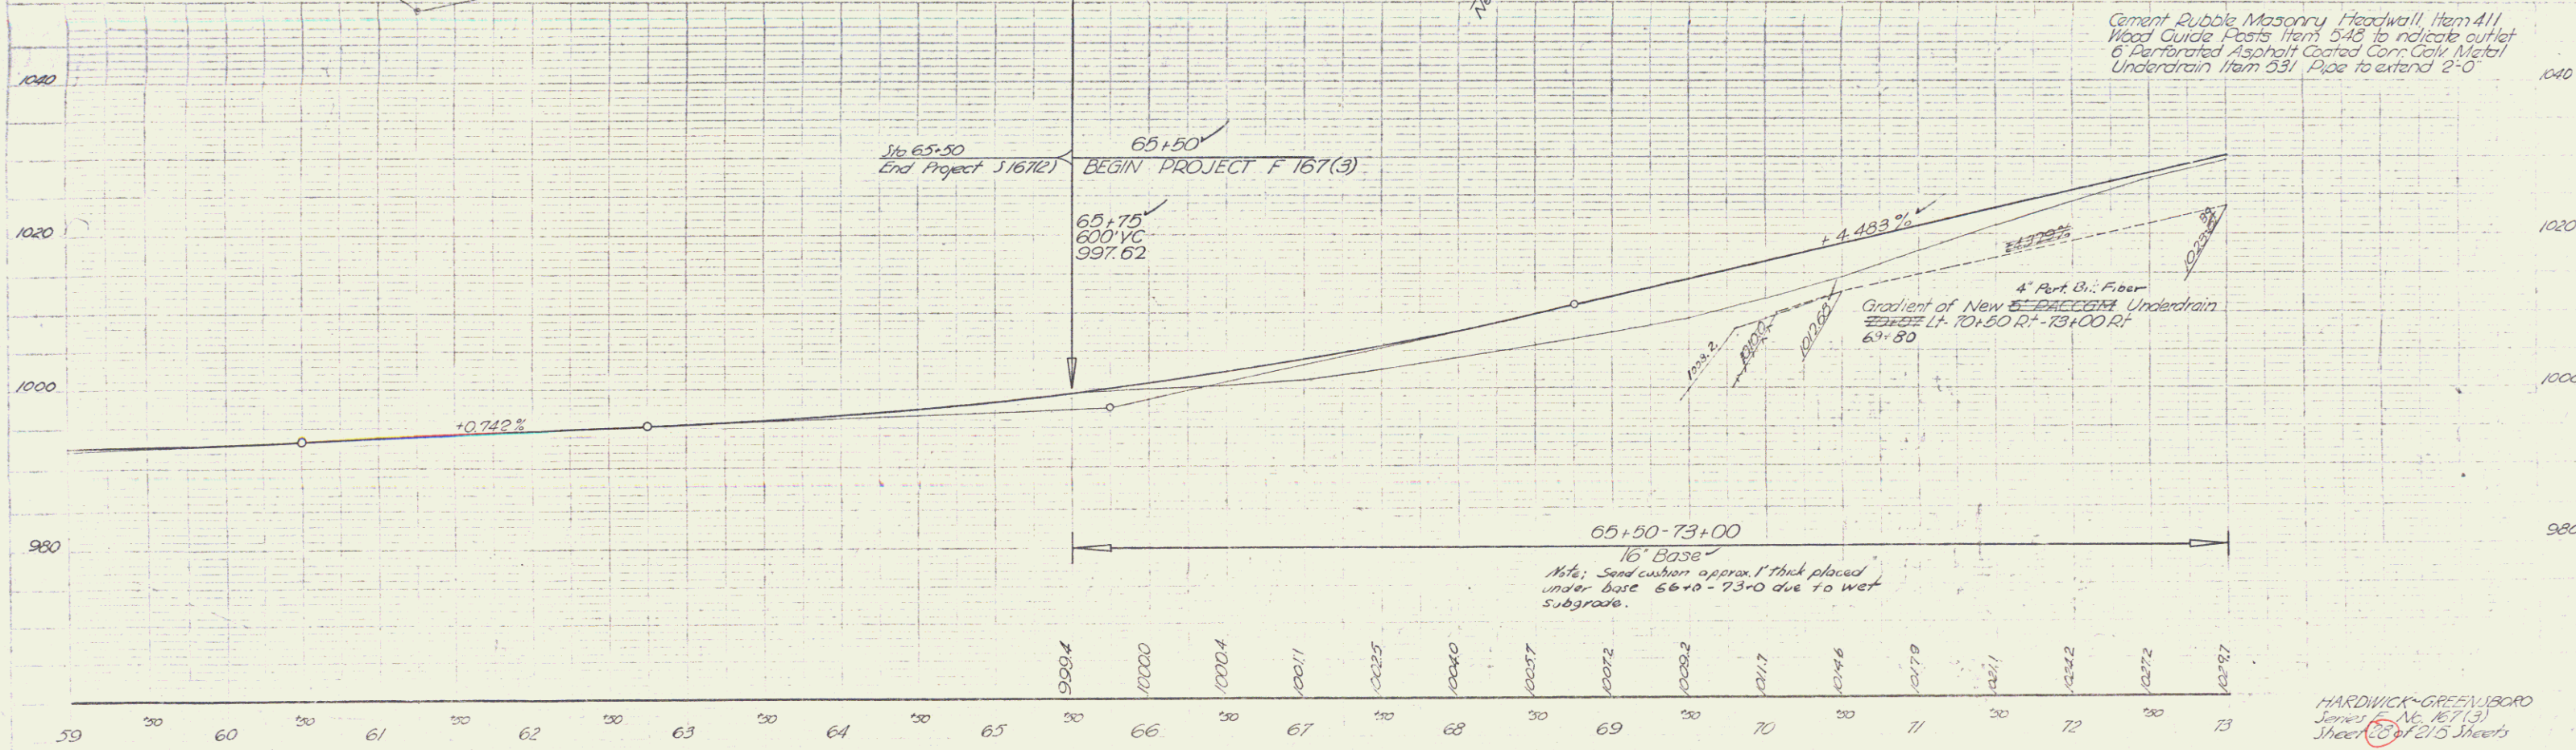

BM # 7 S 1/2 18' Doplar 73 ft. to 62+43 Elev 993.08
 BM # 8 S 1/2 30' Pine 80 ft. to 70+72 Elev 1024.29

HARDWICK-GREENLBORO
 Surveyors No. 167(3)
 Sheet 2 of 2 Sheets