
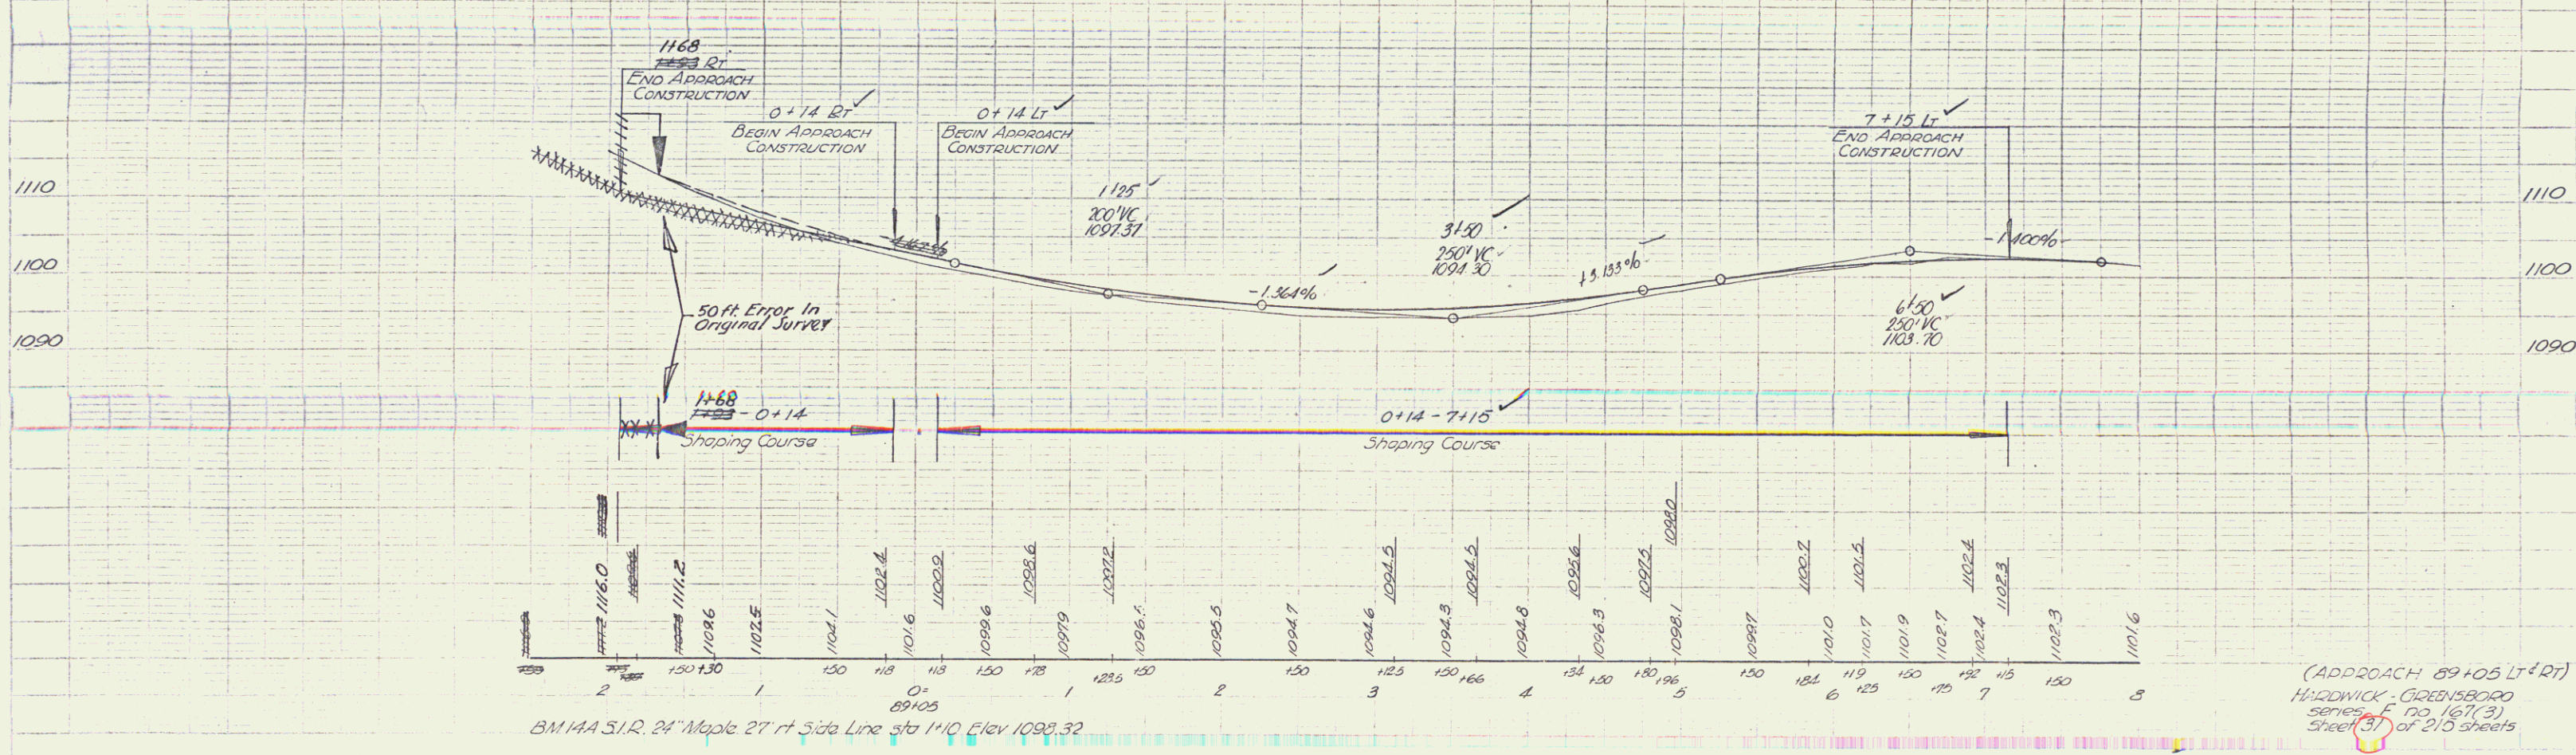
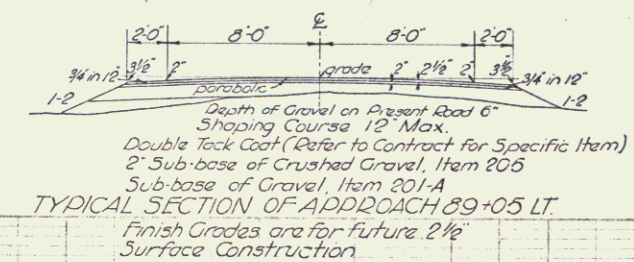
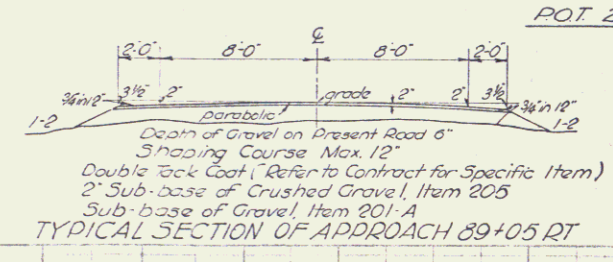


DATE	
BY	
CHECKED	
SCALE	
PROJECT	
DESCRIPTION	
REVISIONS	

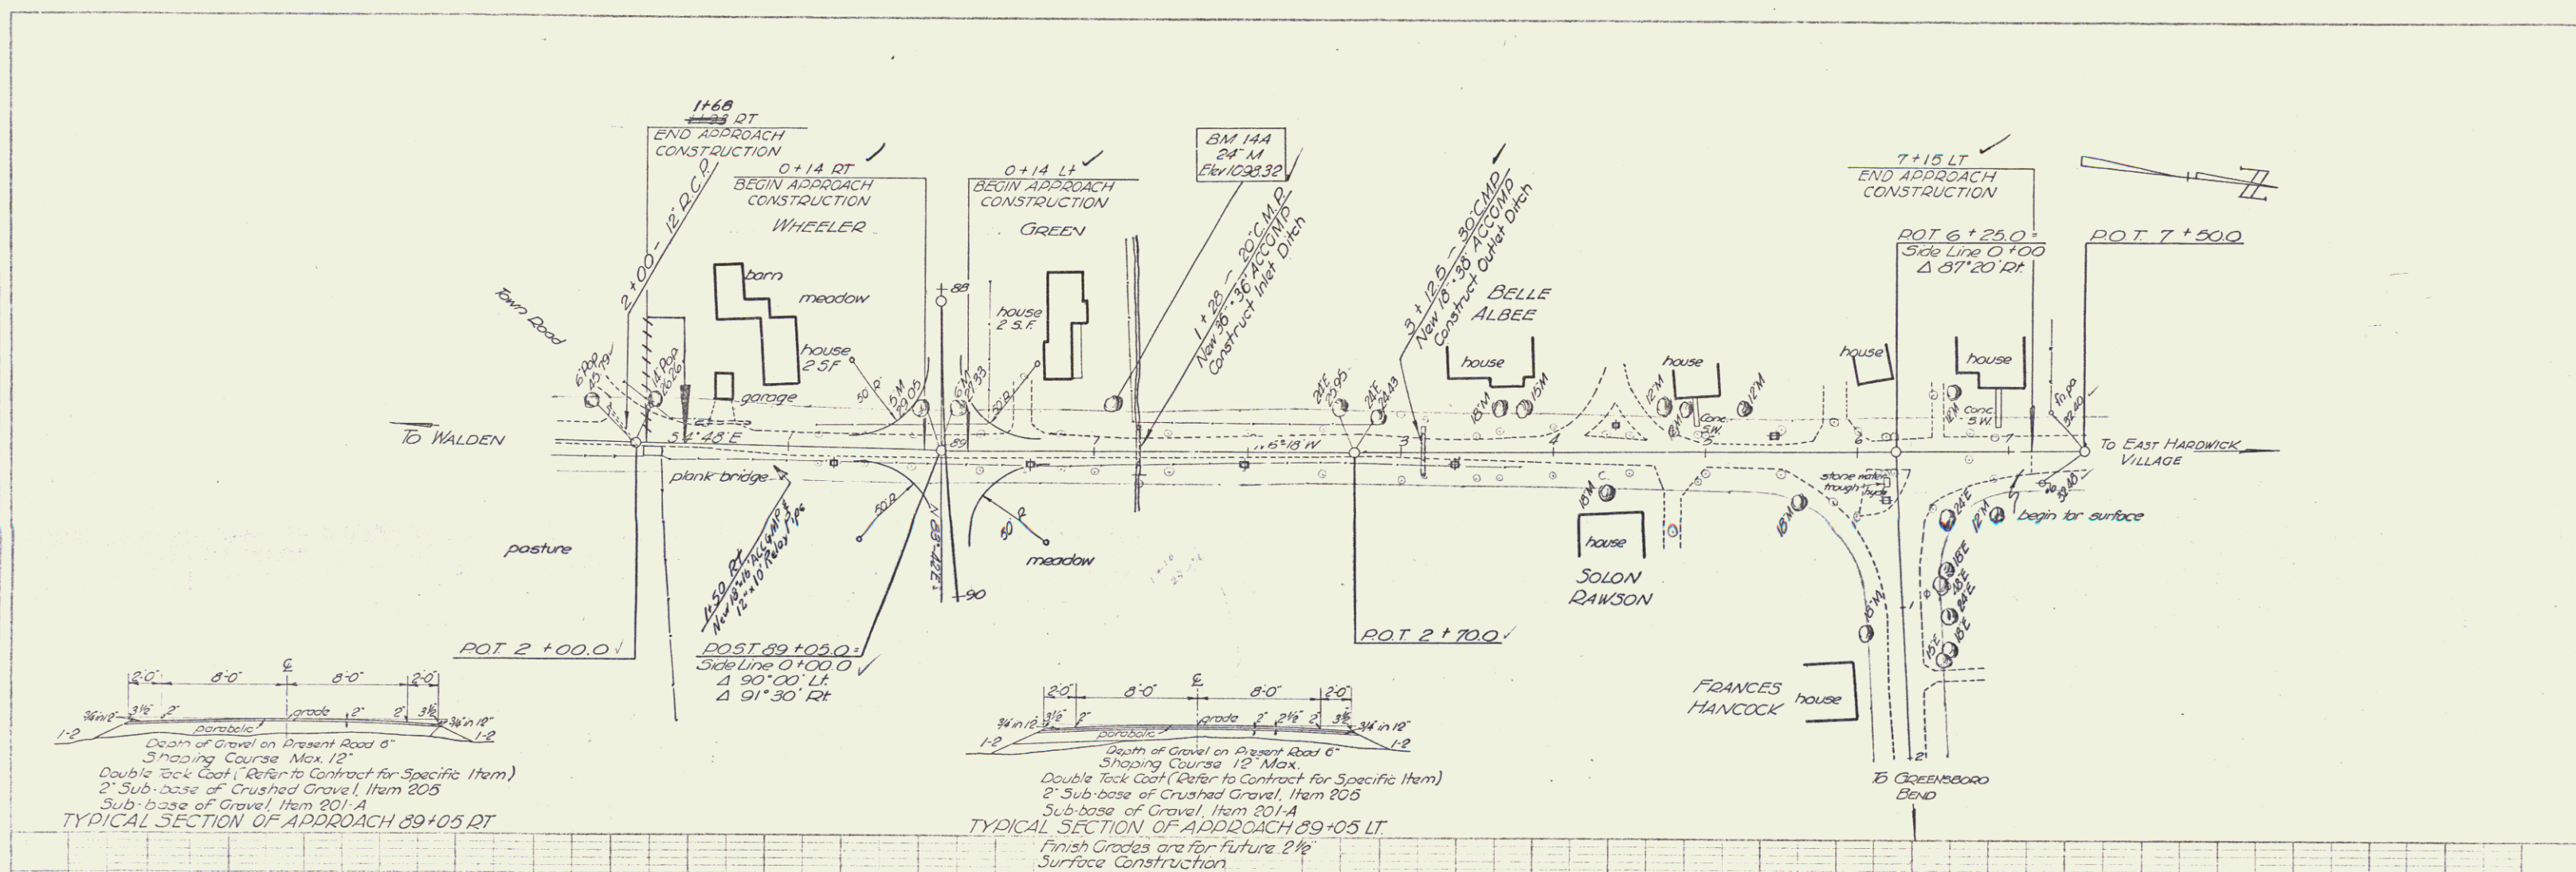

(APPROACH 89+05 LT & RT)  
 HARDWICK - GREENSBORO  
 SERIES NO. 167(3)  
 SHEET 31 OF 215 SHEETS