


FED. STATE	PROJ. NO.	FISCAL YEAR	TOTAL SHEETS
VT.			

PARCEL # 20
INSTRUMENT W.D.O.E.
DATE 6-29-30

GRANTOR Myron C. & Ona B. Dresser
GRANTEE St. of Vt.

RECORDED HARDWICK
BOOK 49
PAGE 62
DATE 7-26-50
REMARKS-

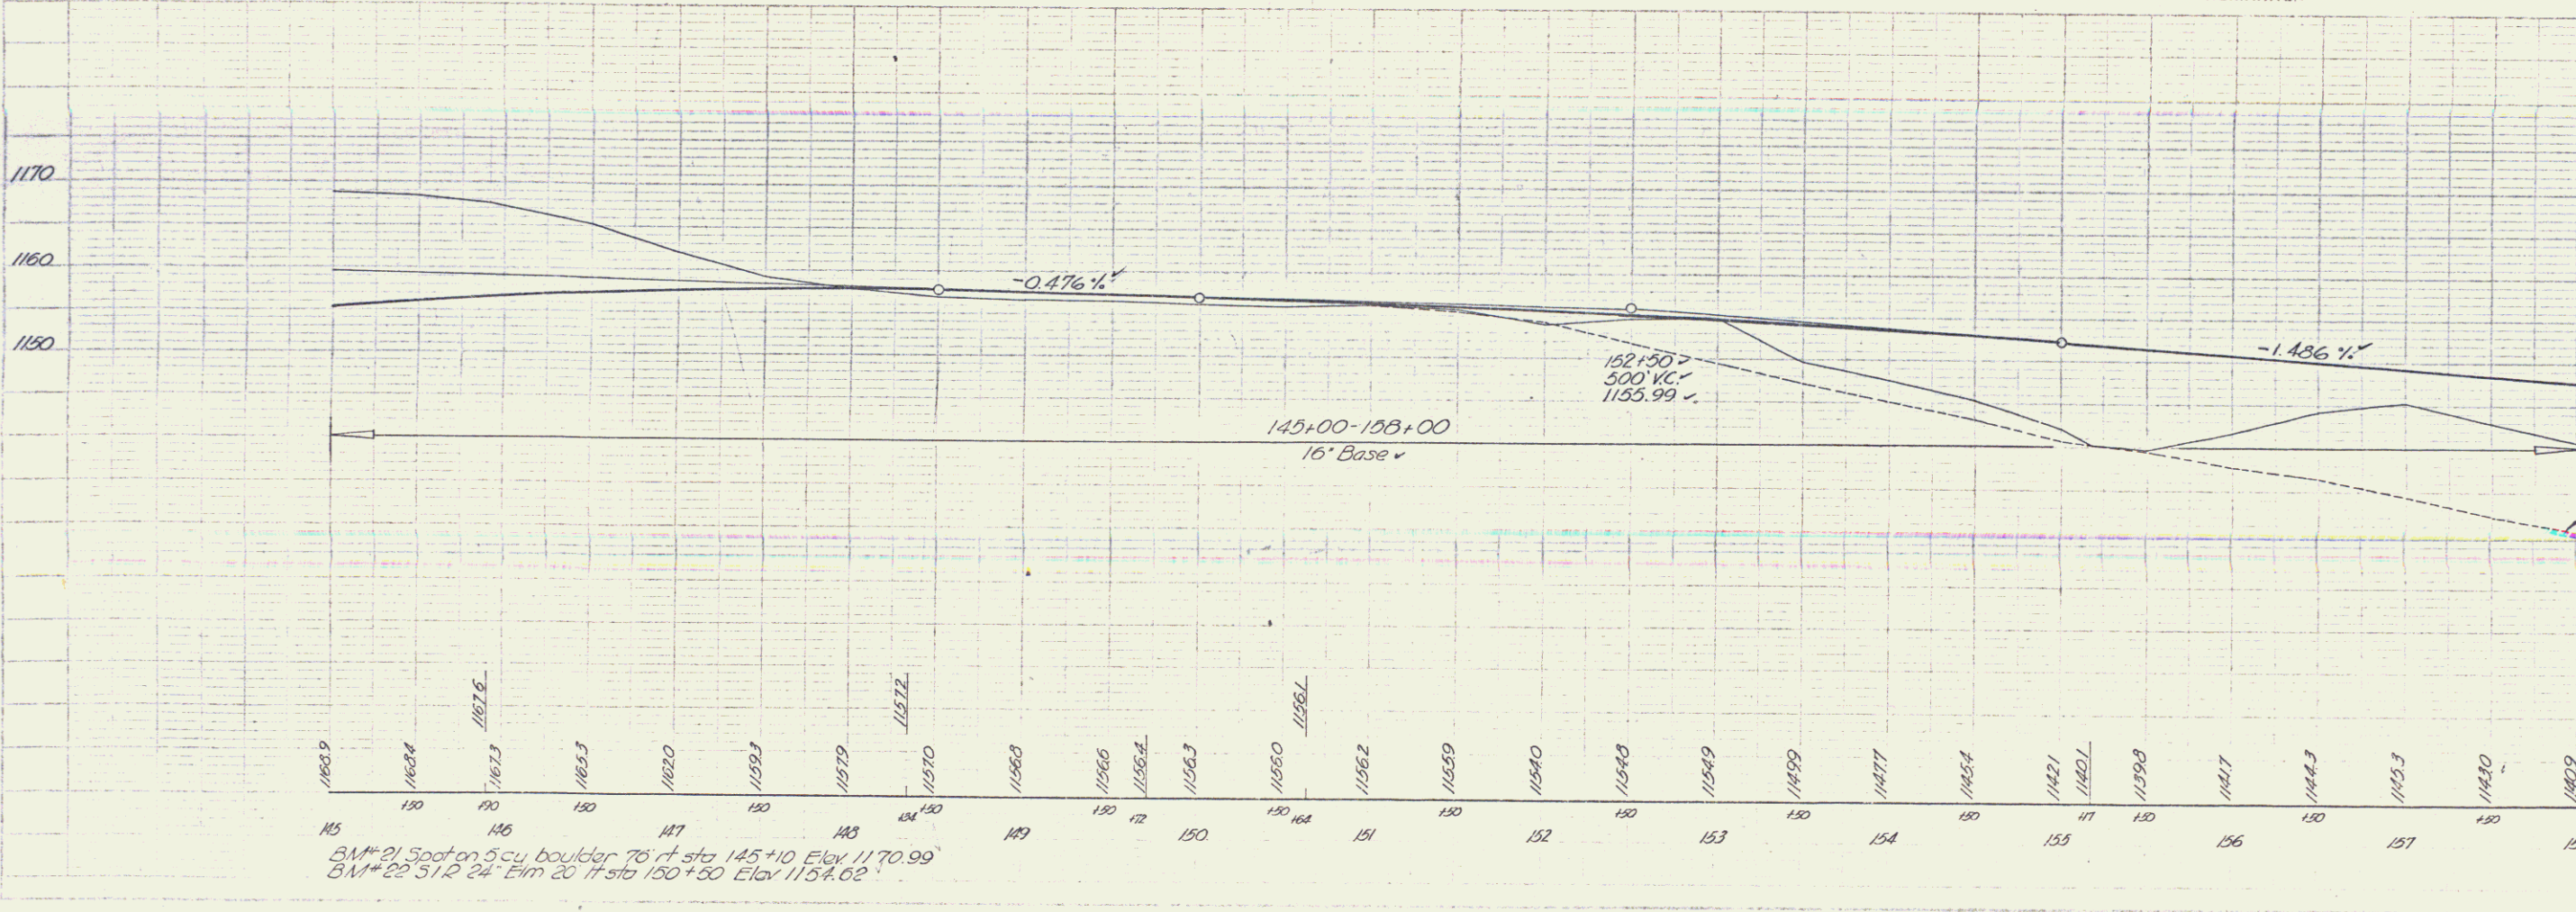

BM*21 Spot on 5 cy boulder 70 ft Sta 145+10 Elev 1170.99
BM*22 S/R 24' Elm 20 ft Sta 150+50 Elev 1154.02

Hardwick - Greenboro
Series F No 167(3)
Sheet 85 of 215 Sheets