


PARCEL NO.	STATE	PROJ. NO.	FISCAL YEAR	SHEET NO.	TOTAL SHEETS
9	Vt.				

$\Delta 2^{\circ}08'14''$
 $D 11^{\circ}$
 $R 15729.7'$
 $T 106.7'$
 $L 213.3'$
 $E 1.0'$
 Do not Bank

THREE CABLE GUARD RAIL
 204+98-206+56 RT
 211+00 214+86 RT
FLANK GUARD RAIL
 217+00-217+50 RT
 218+00 RT (on old road)
WOOD GUIDE POSTS
 208+51-210+22 RT

CONSTRUCT DRIVE
 208+50 LF
 210+00 LF
 211+60 LF
 216+50 LF
 217+60 RT

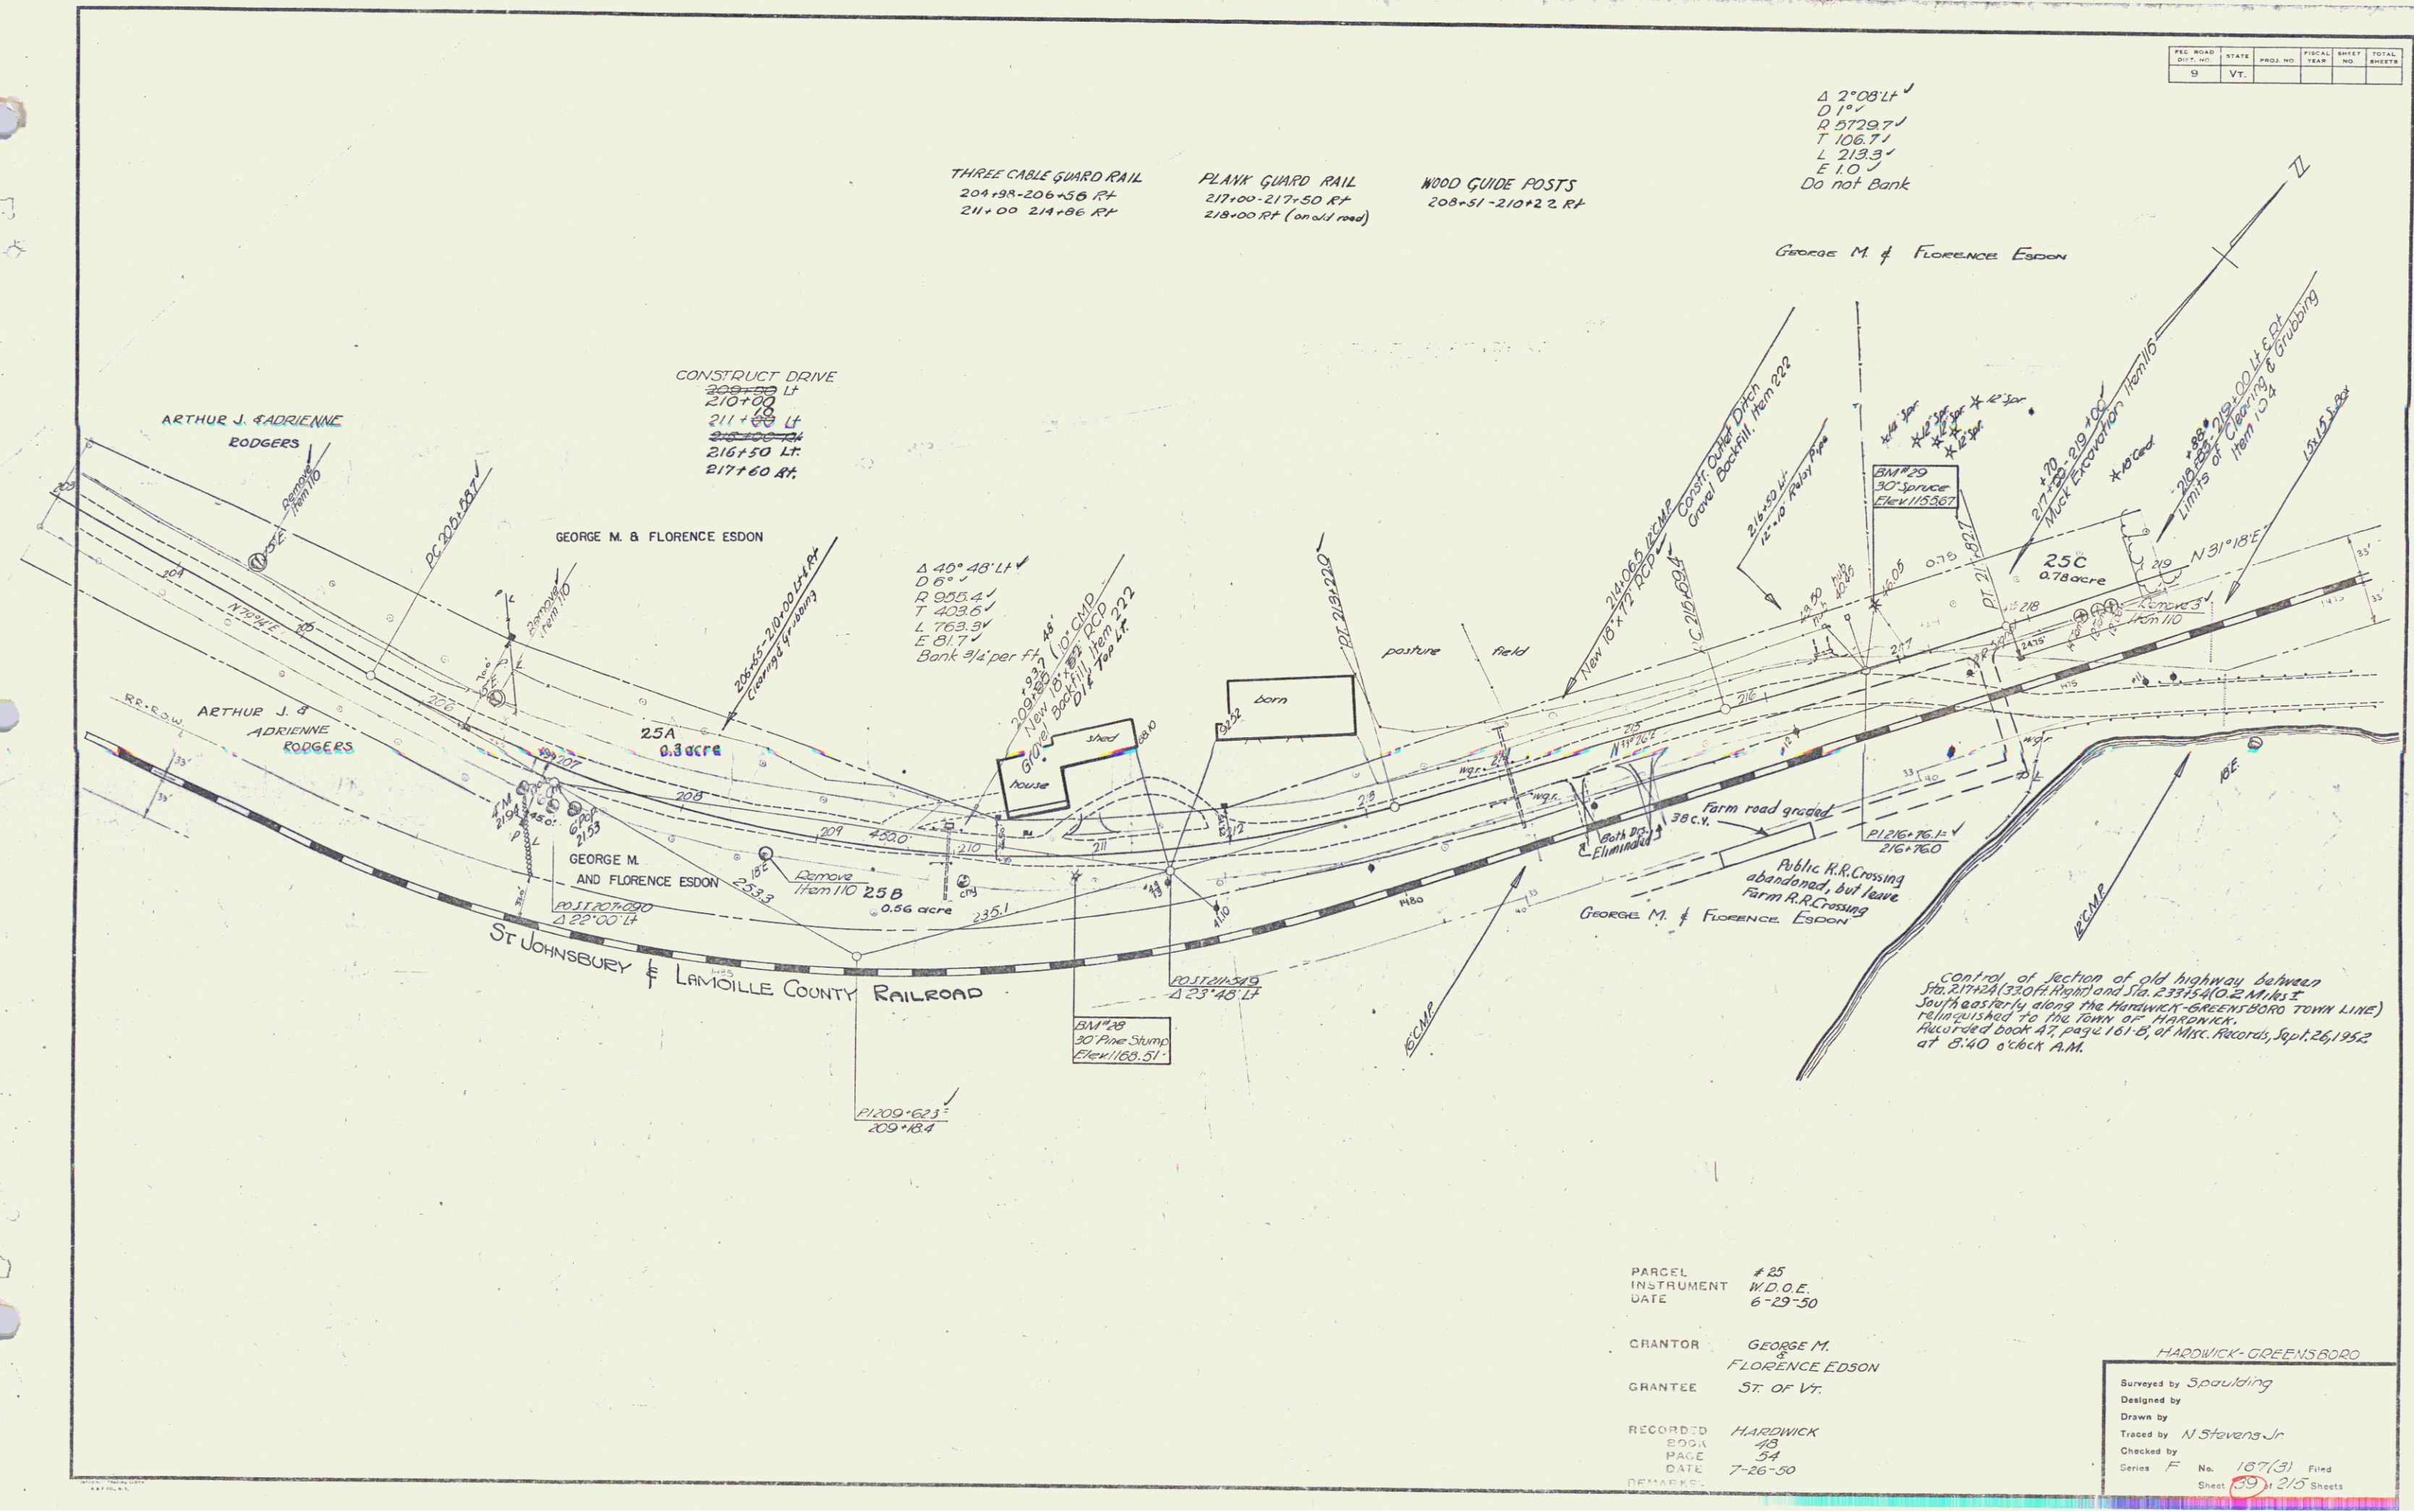

PARCEL # 25
 INSTRUMENT W.D.O.E.
 DATE 6-29-50

GRANTOR GEORGE M.
 FLORENCE ESDON
 GRANTEE ST. OF VT.

RECORDED HARDWICK
 BOOK 43
 PAGE 54
 DATE 7-26-50

HARDWICK-GREENSBORO
 Surveyed by Spaulding
 Designed by
 Drawn by
 Traced by N. Stevens Jr.
 Checked by
 Series F No. 167(3) Filed
 Sheet 19 of 215 Sheets