


PARCEL #35
INSTRUMENT W.D.O.E.
DATE 6-29-50

GRANTOR HOWARD G. CONLEY

GRANTEE ST. OF VT.

RECORDED GREENSBORO
BOOK
PAGE 126
DATE 7-26-50

REMARKS:-

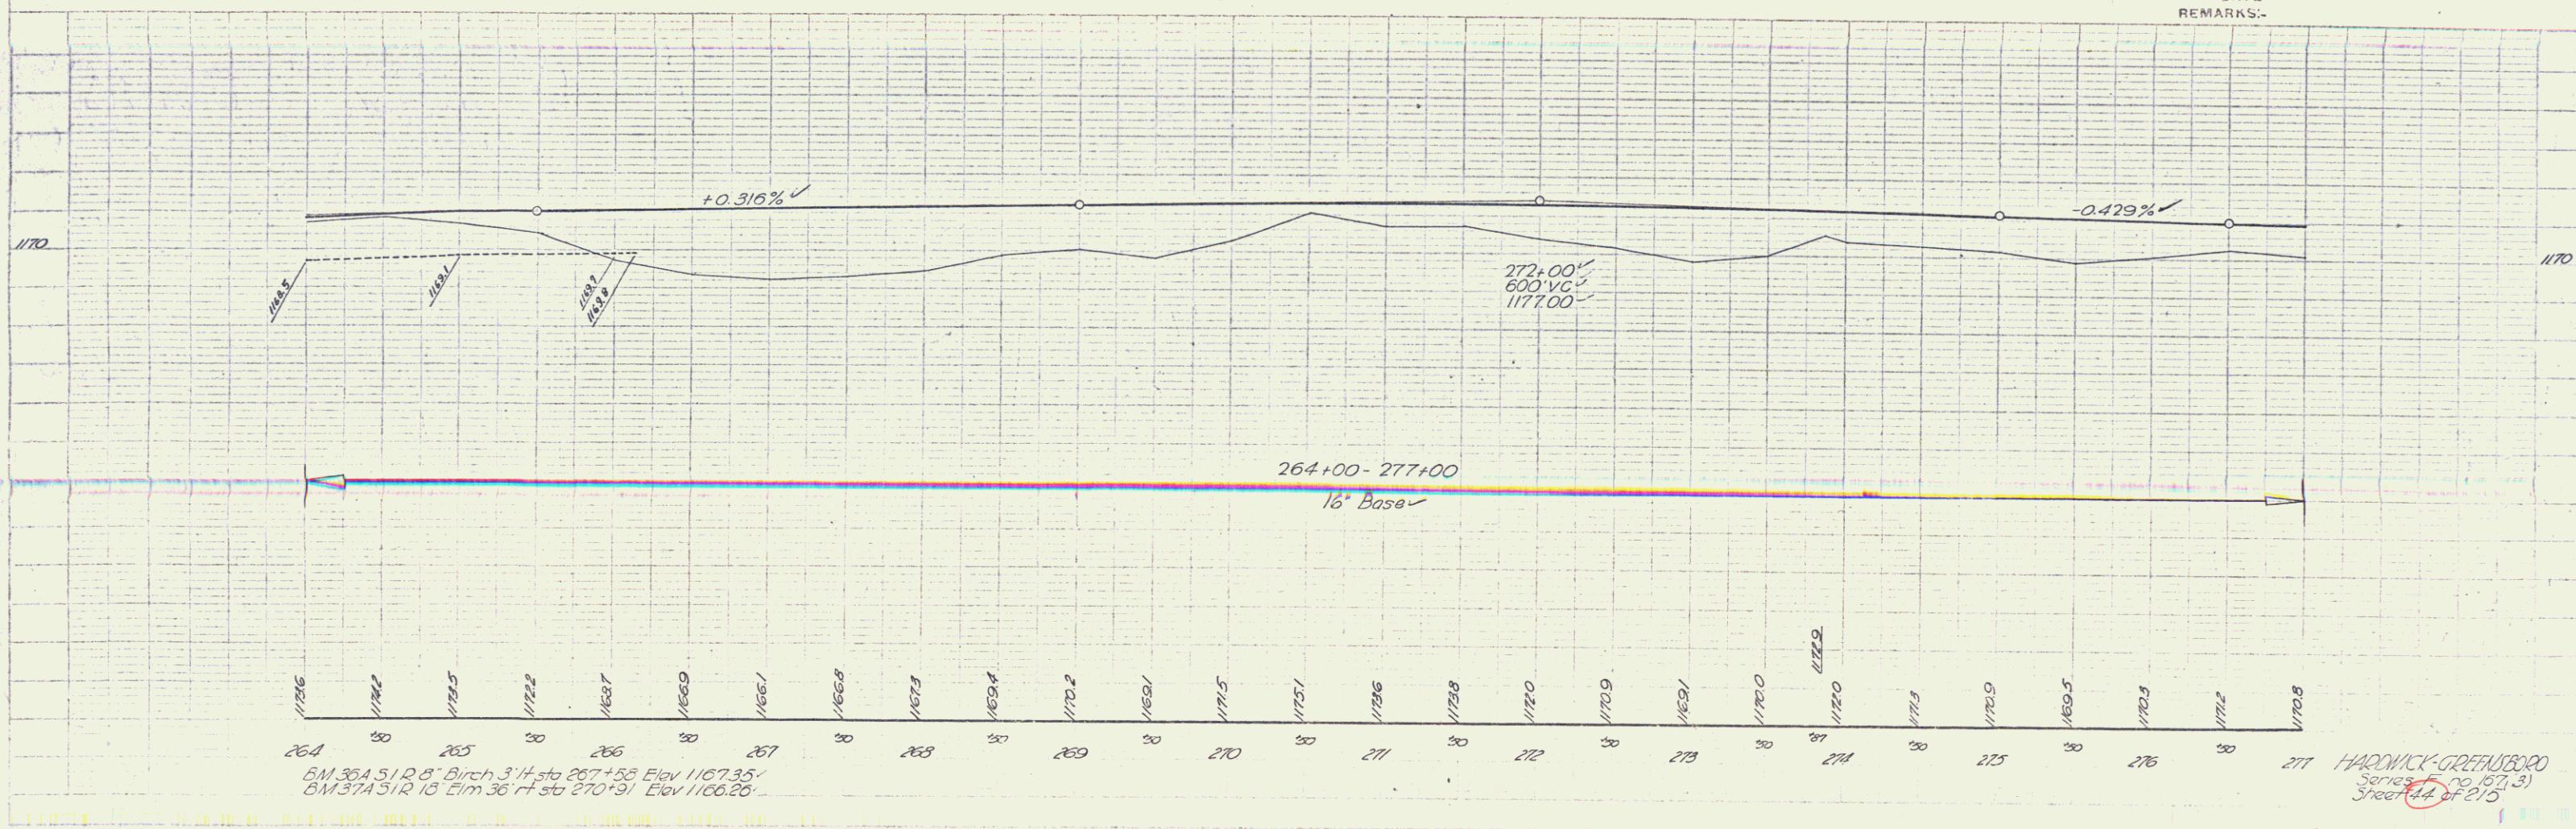

HARDWICK-GREENSBORO
Series 20, 167, 3
Sheet 44 of 215