


PARCEL #36 ABAC
 INSTRUMENT W.D.E.
 DATE 6-29-50

GRANTOR CARROLL R. & MARY C. SMITH

GRANTEE ST. of VT.

RECORDED GREENSBORO
 BOOK 127
 PAGE 7-26-50
 DATE

REMARKS #36 CON SHEETS 17+18

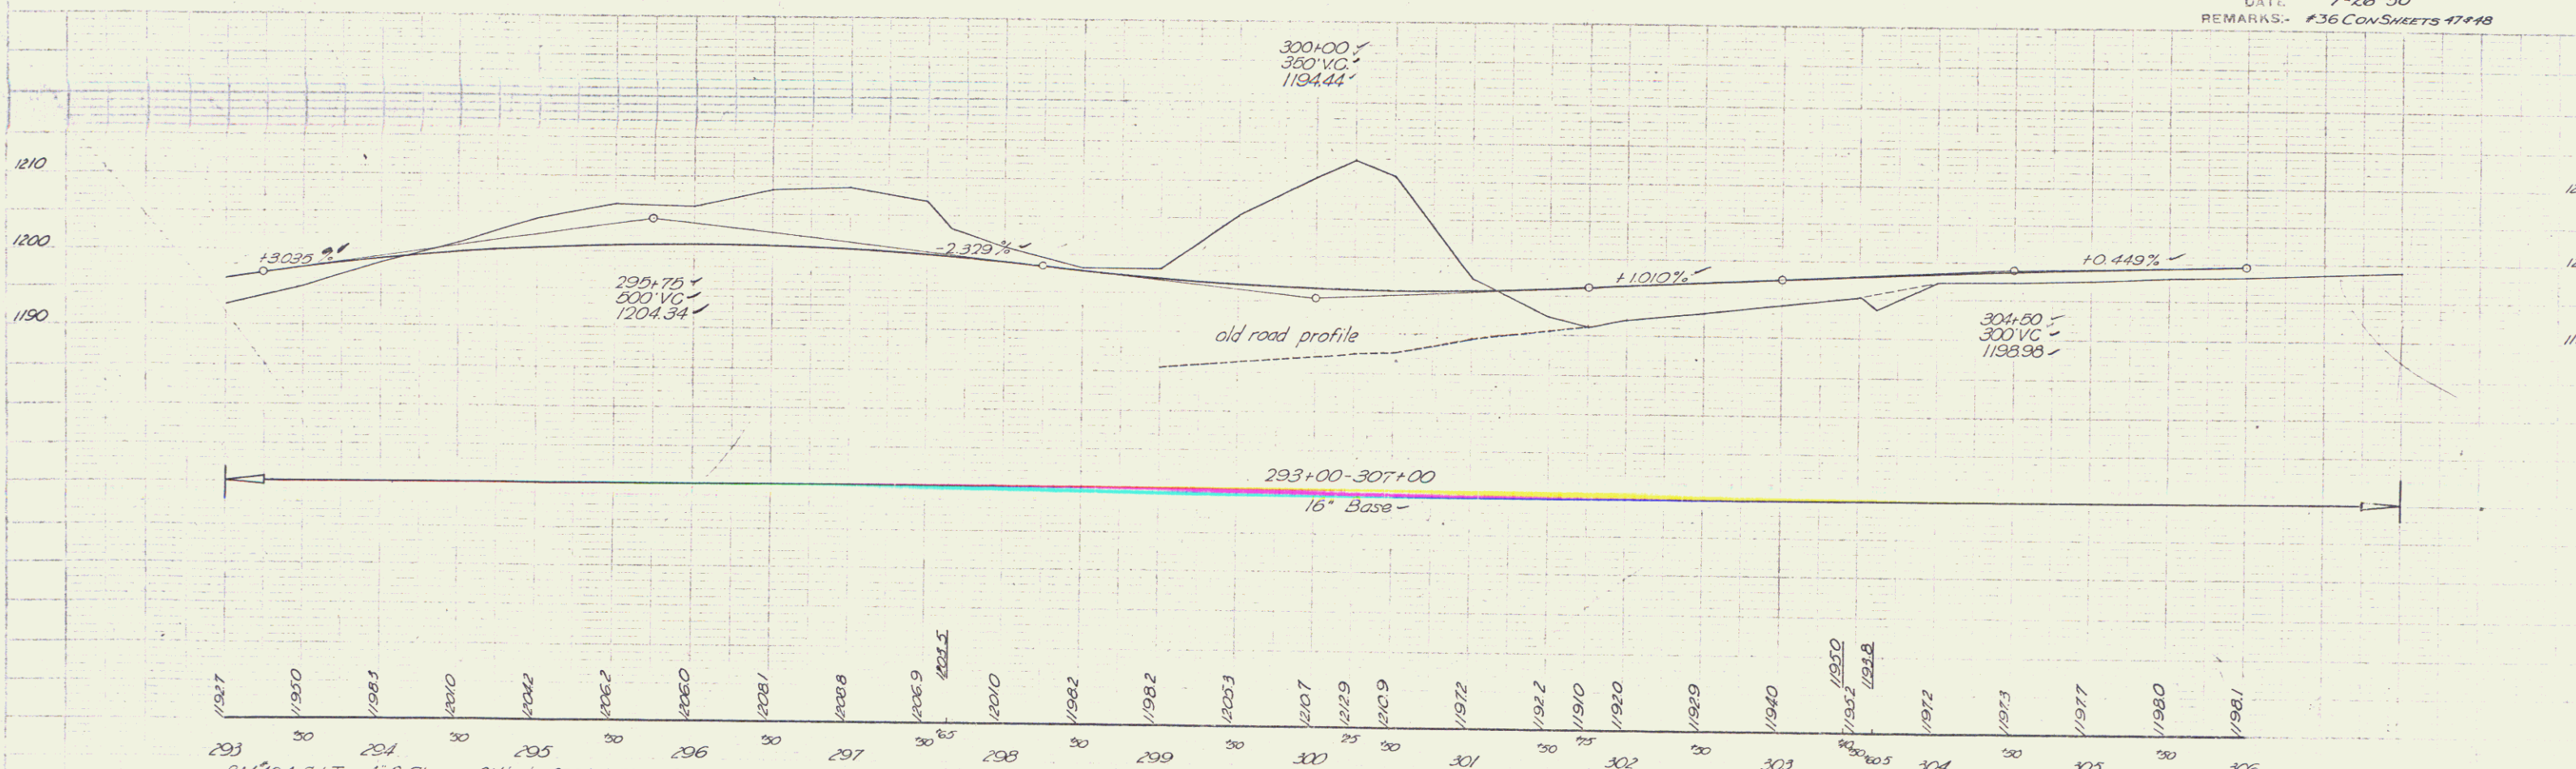

BM 204 51 Top 4" B. Cherry 2 1/4" Sta 206+11 Elev. 1208.85'
 BM 211A 3rd on 2cy boulder 3 1/4" Sta 303+71 Elev. 1201.96'

HARDWICK-GREENSBORO
 Series F no 107(3)
 Sheet 30 of 215