
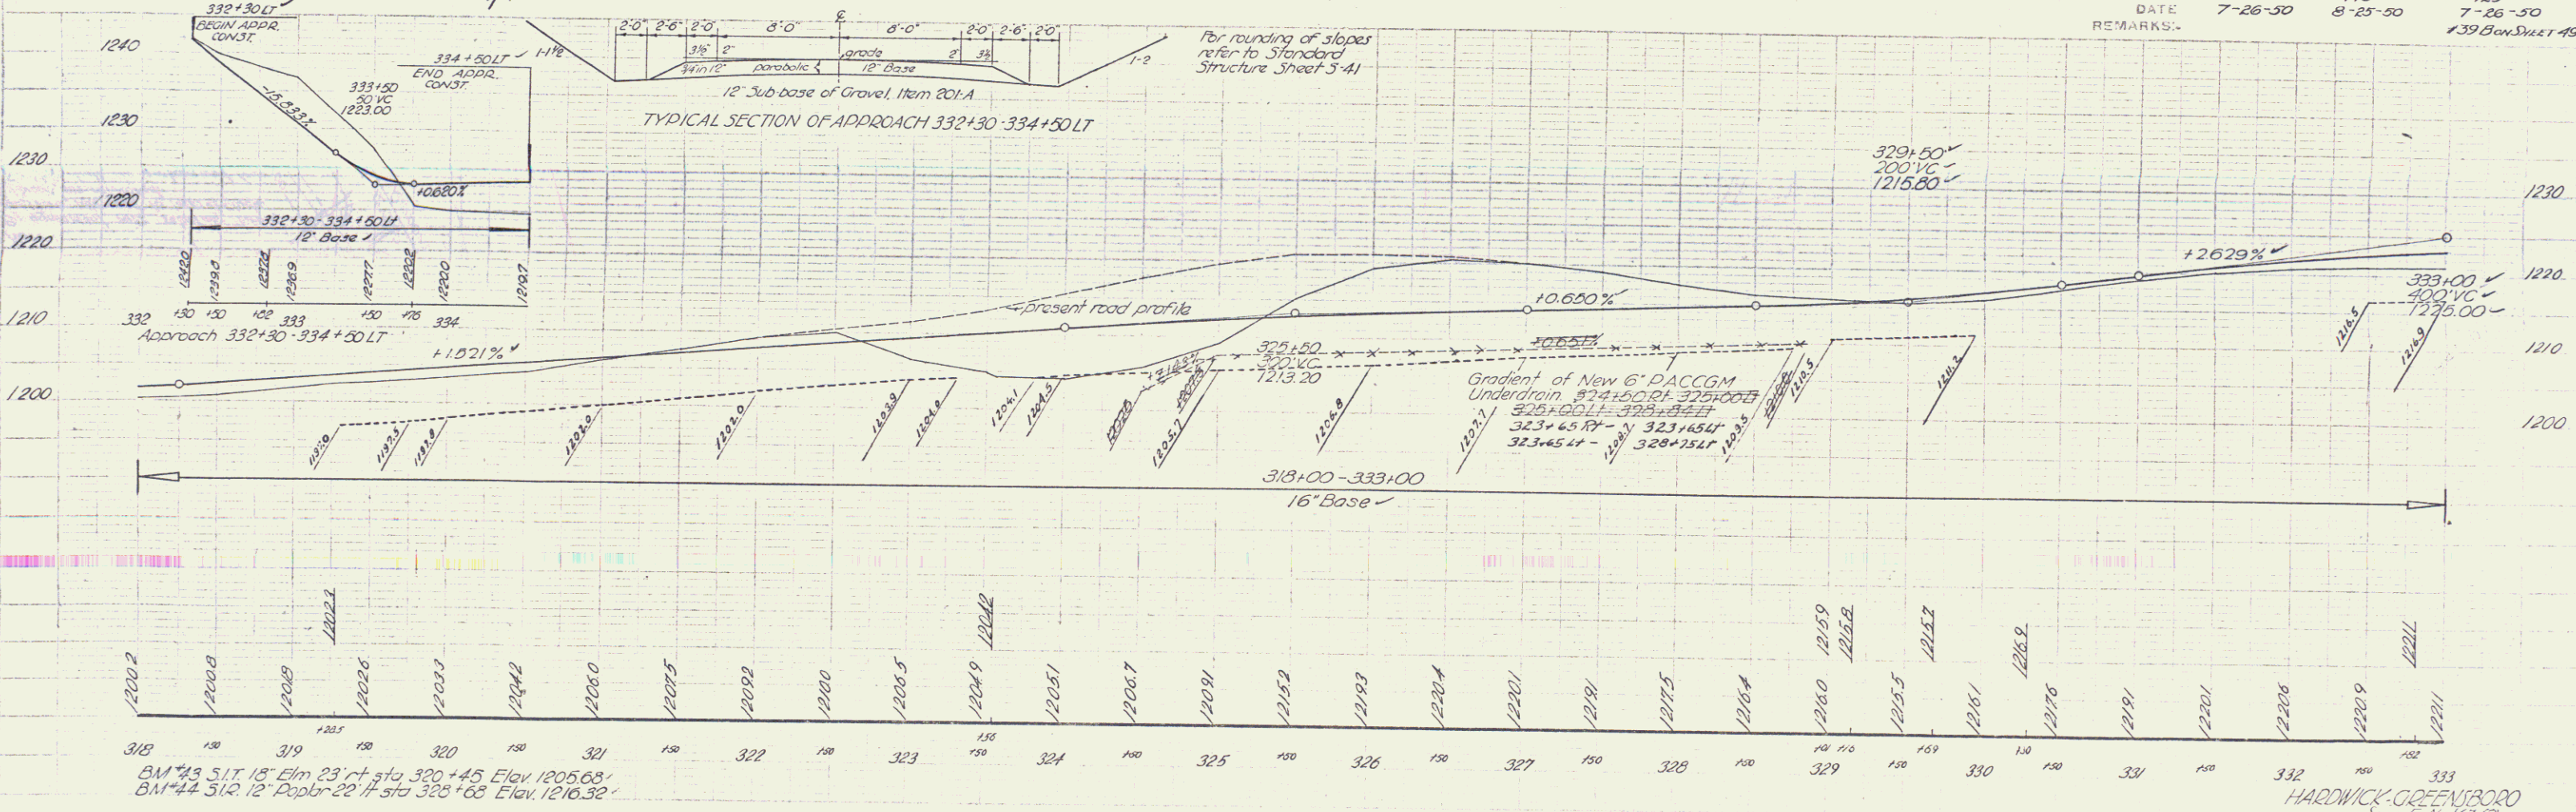


PLAN
 Scale
 1" = 40'
 7-49
 7-49
 7-49

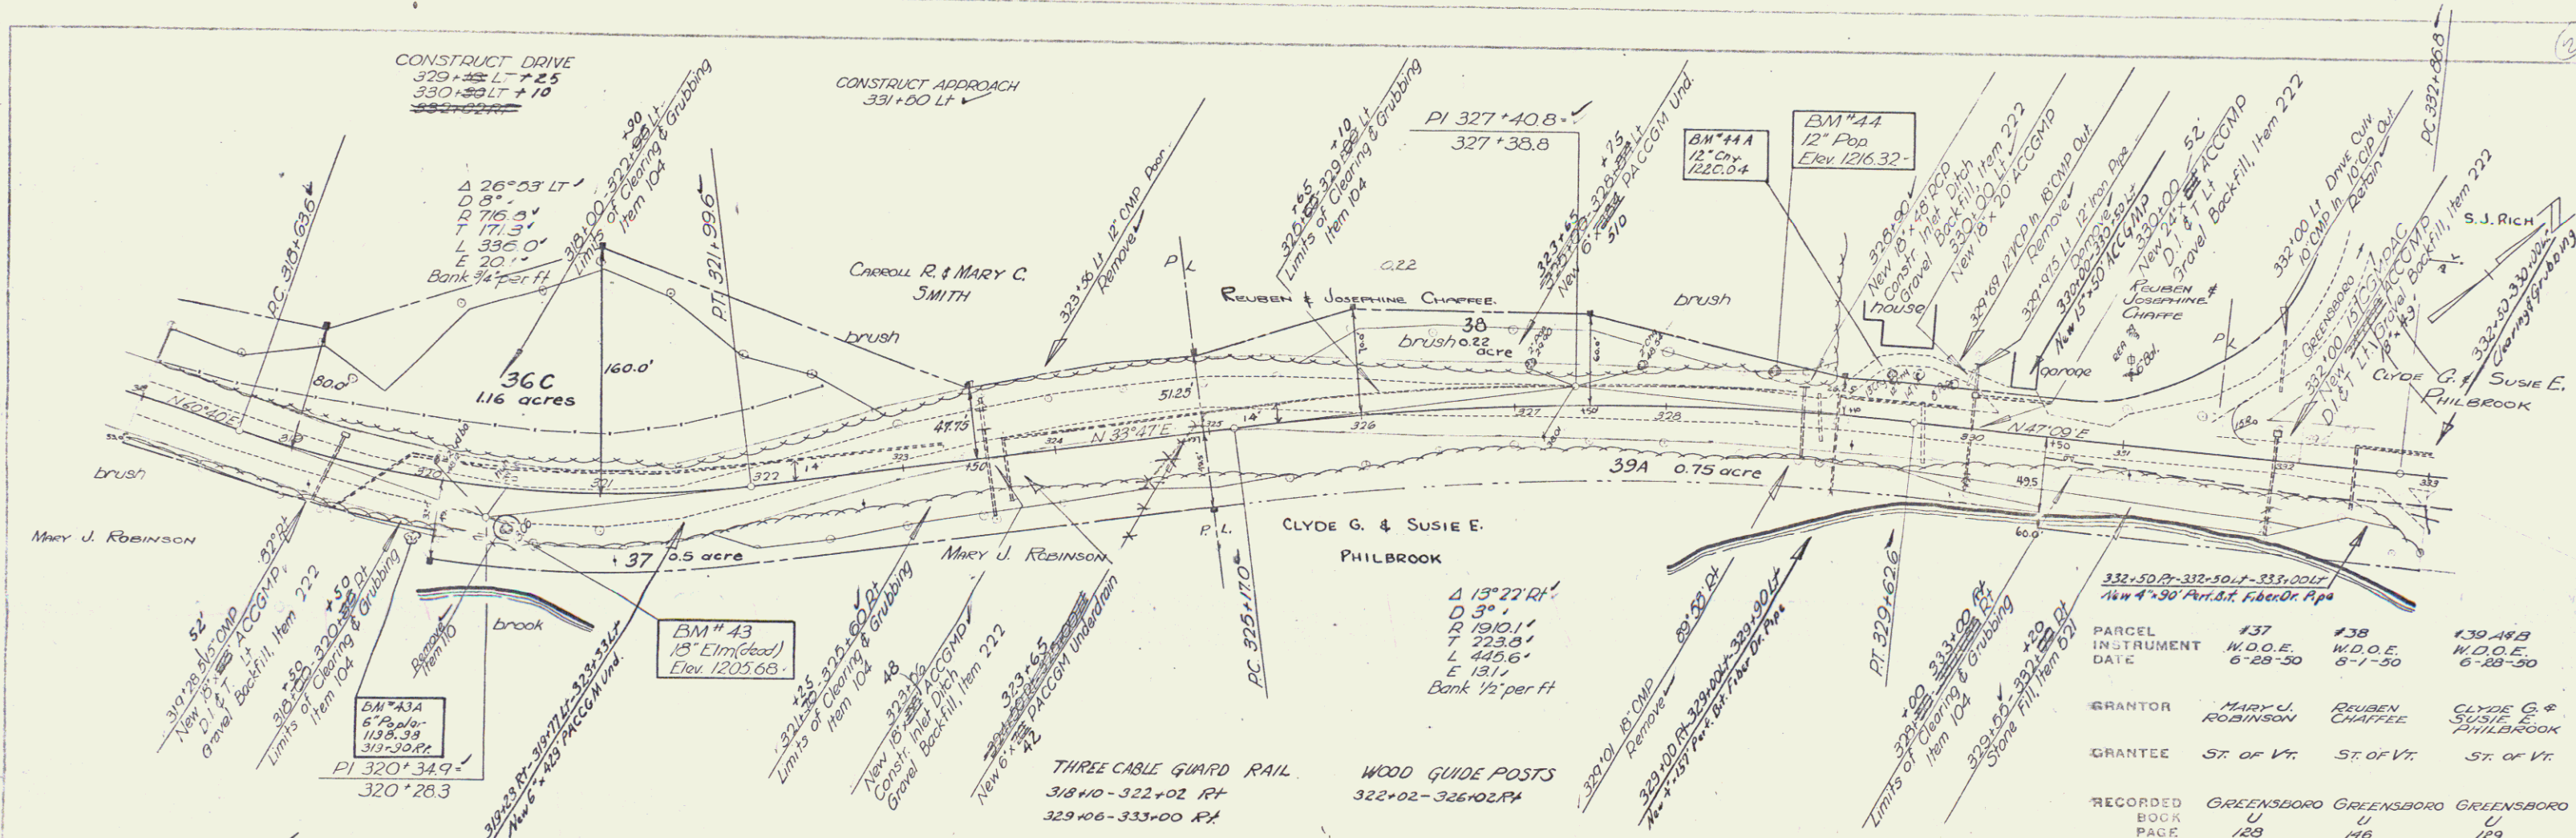

PARCEL	#37	#38	#39
INSTRUMENT	W.D.O.E.	W.D.O.E.	W.D.O.E.
DATE	6-28-50	8-1-50	6-28-50
GRANTOR	MARY J. ROBINSON	REUBEN CHAFFEE	CLYDE G. & SUSIE E. PHILBROOK
GRANTEE	ST. OF VT.	ST. OF VT.	ST. OF VT.
RECORDED BOOK	GREENSBORO	GREENSBORO	GREENSBORO
PAGE	128	146	129
DATE	7-26-50	8-25-50	7-26-50
REMARKS			#39 Ben. Sheet 49

BM #43 S.T. 18' Elm 23 ft sta 320+45 Elev 1205.68
 BM #44 12' Pop 22 ft sta 326+68 Elev 1216.32

HARDWICK GREENSBORO
 Series 7 16 167 (3)
 Sheet 45 of 215