
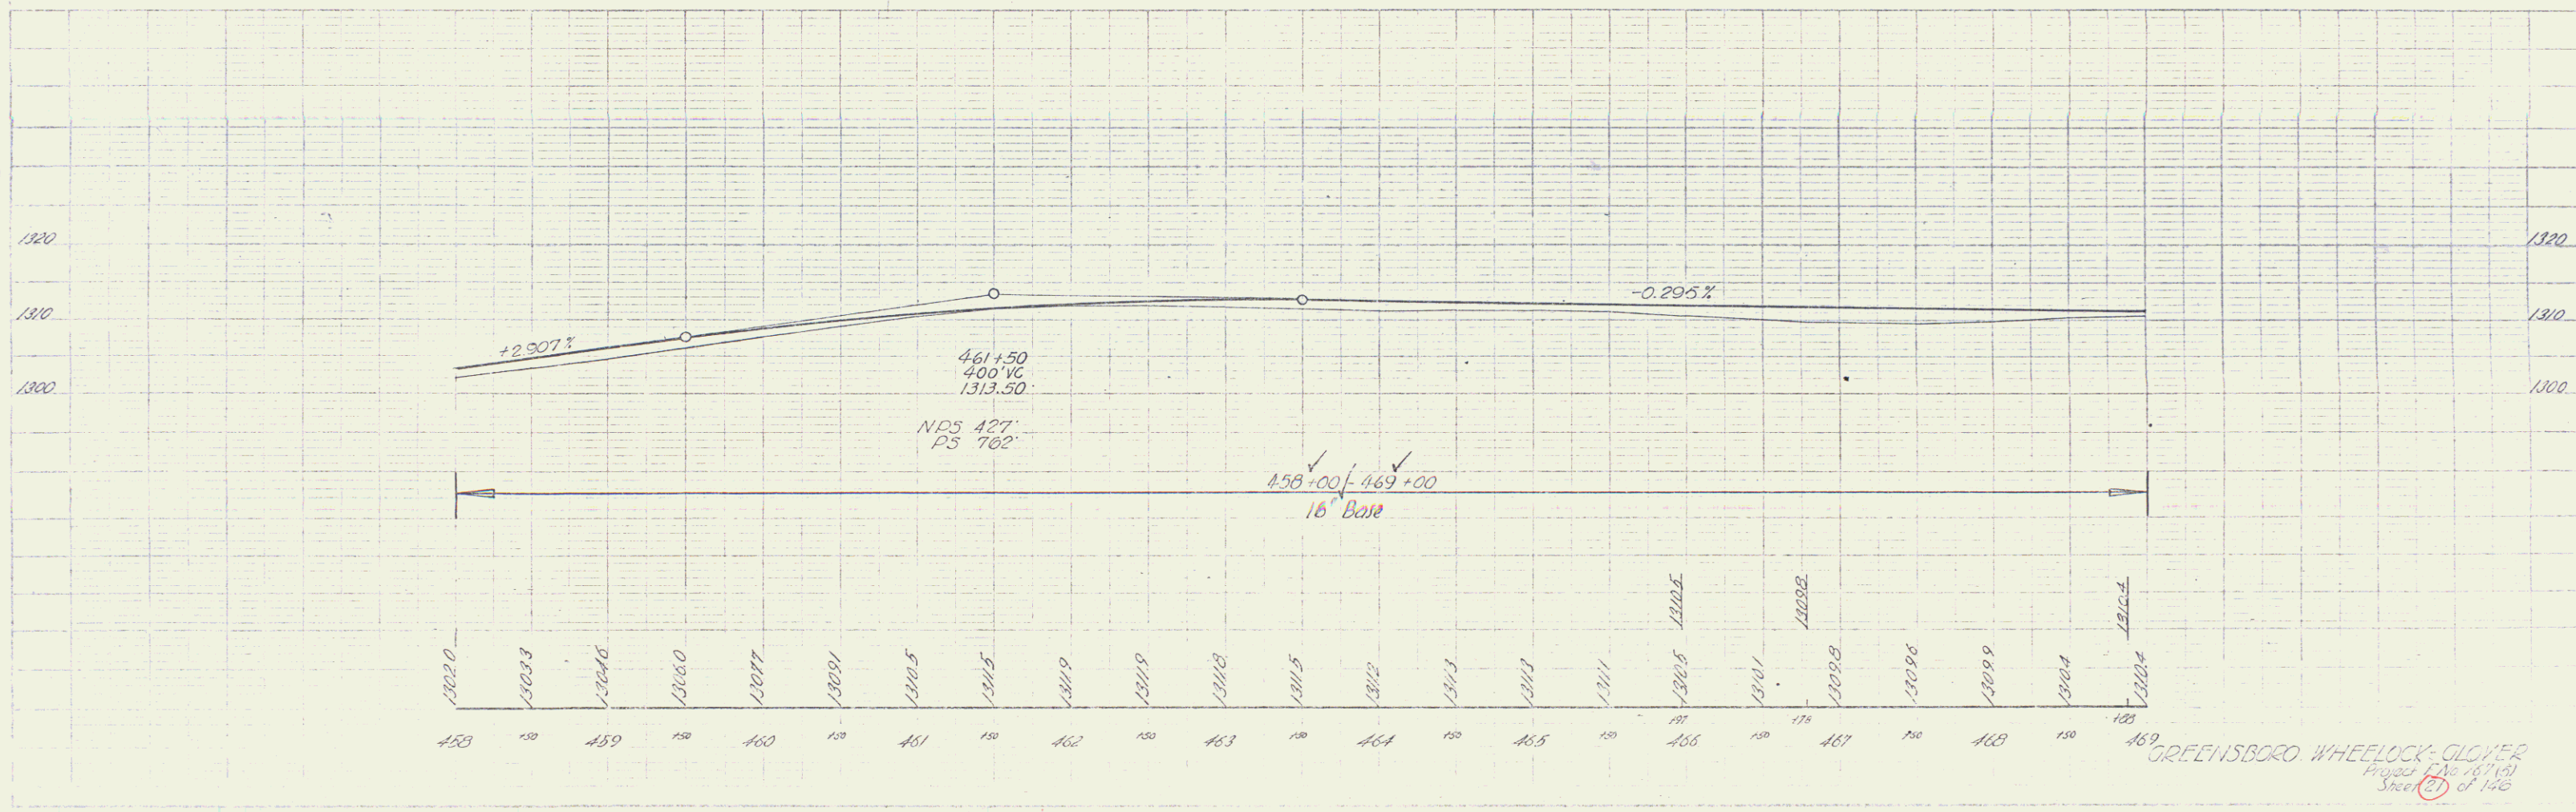


DRAWING NO. 7-49
 DATE 7-49
 DRAWING
 7-49

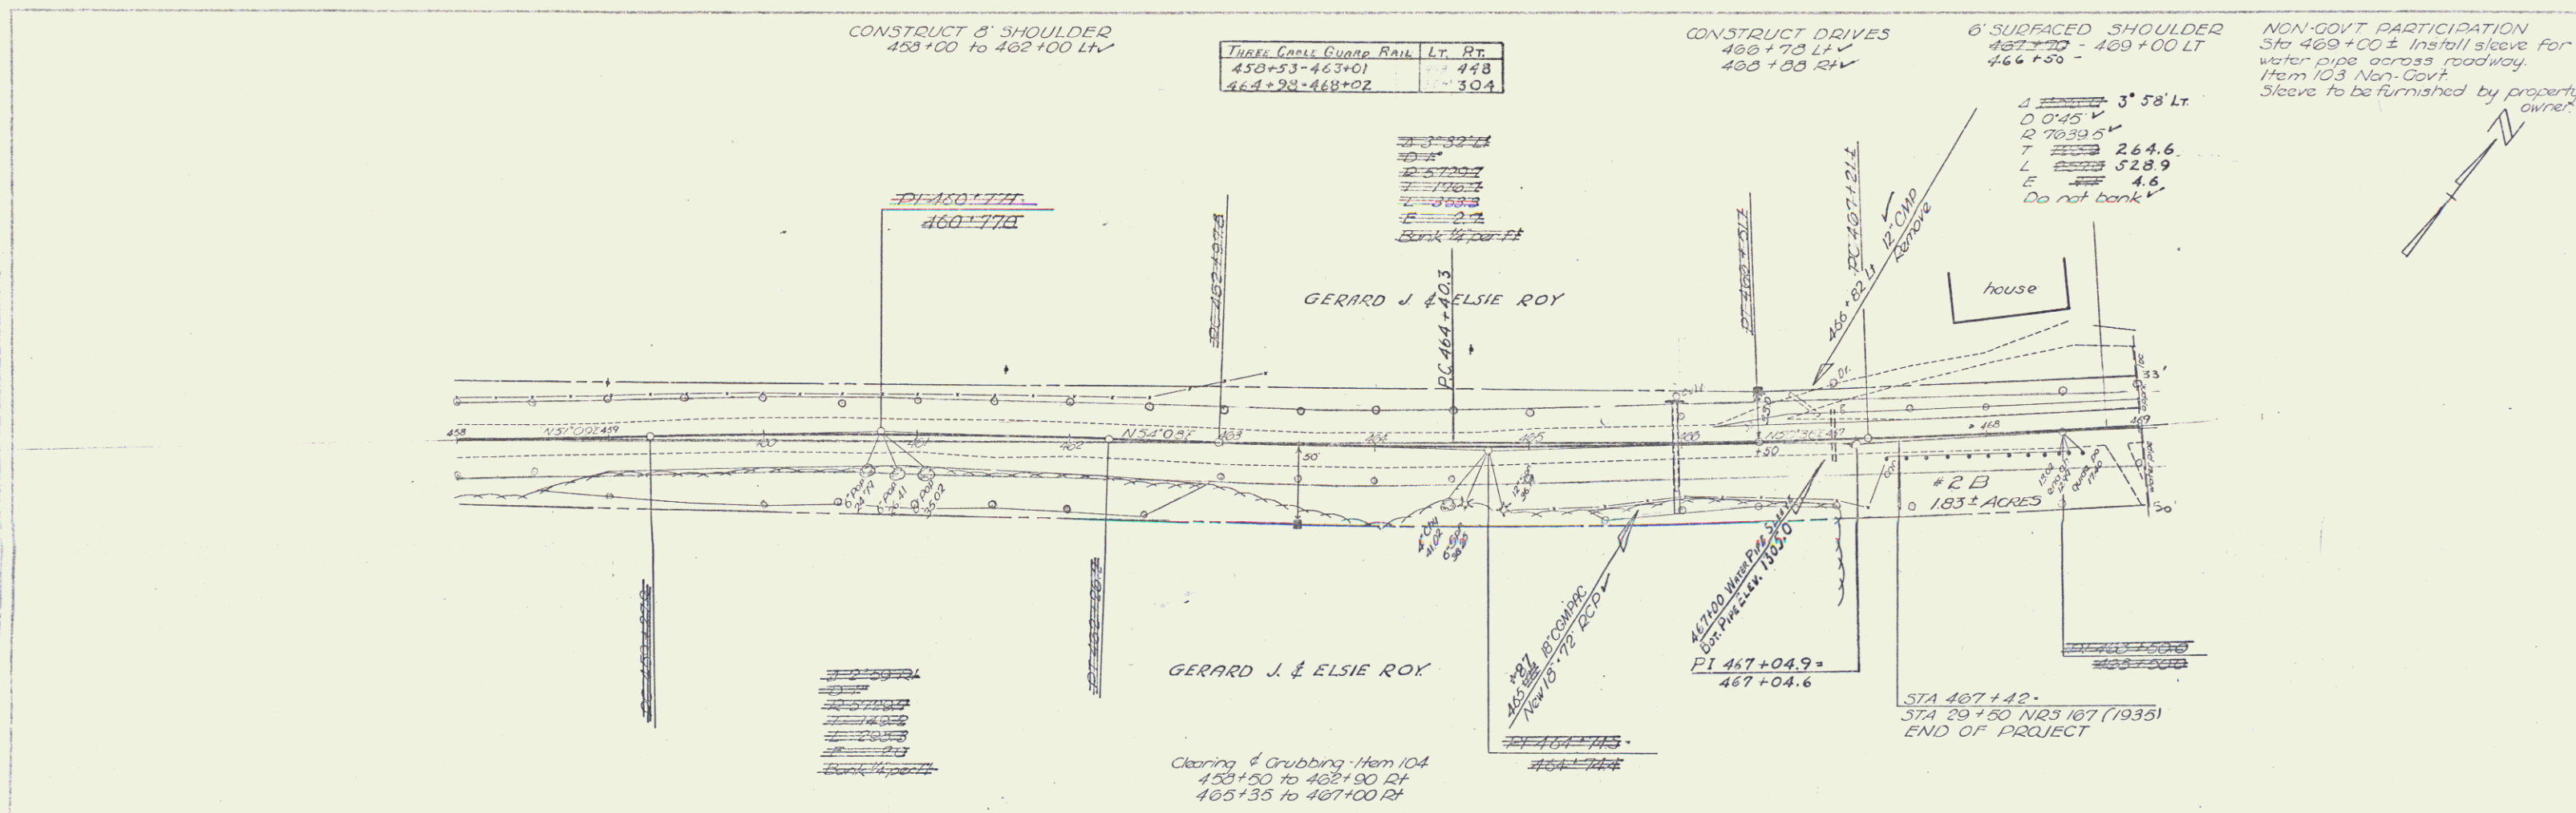

GREENSBORO WHEELLOCK-GILMER
 Project No. 471(4)
 Sheet 2 of 126