
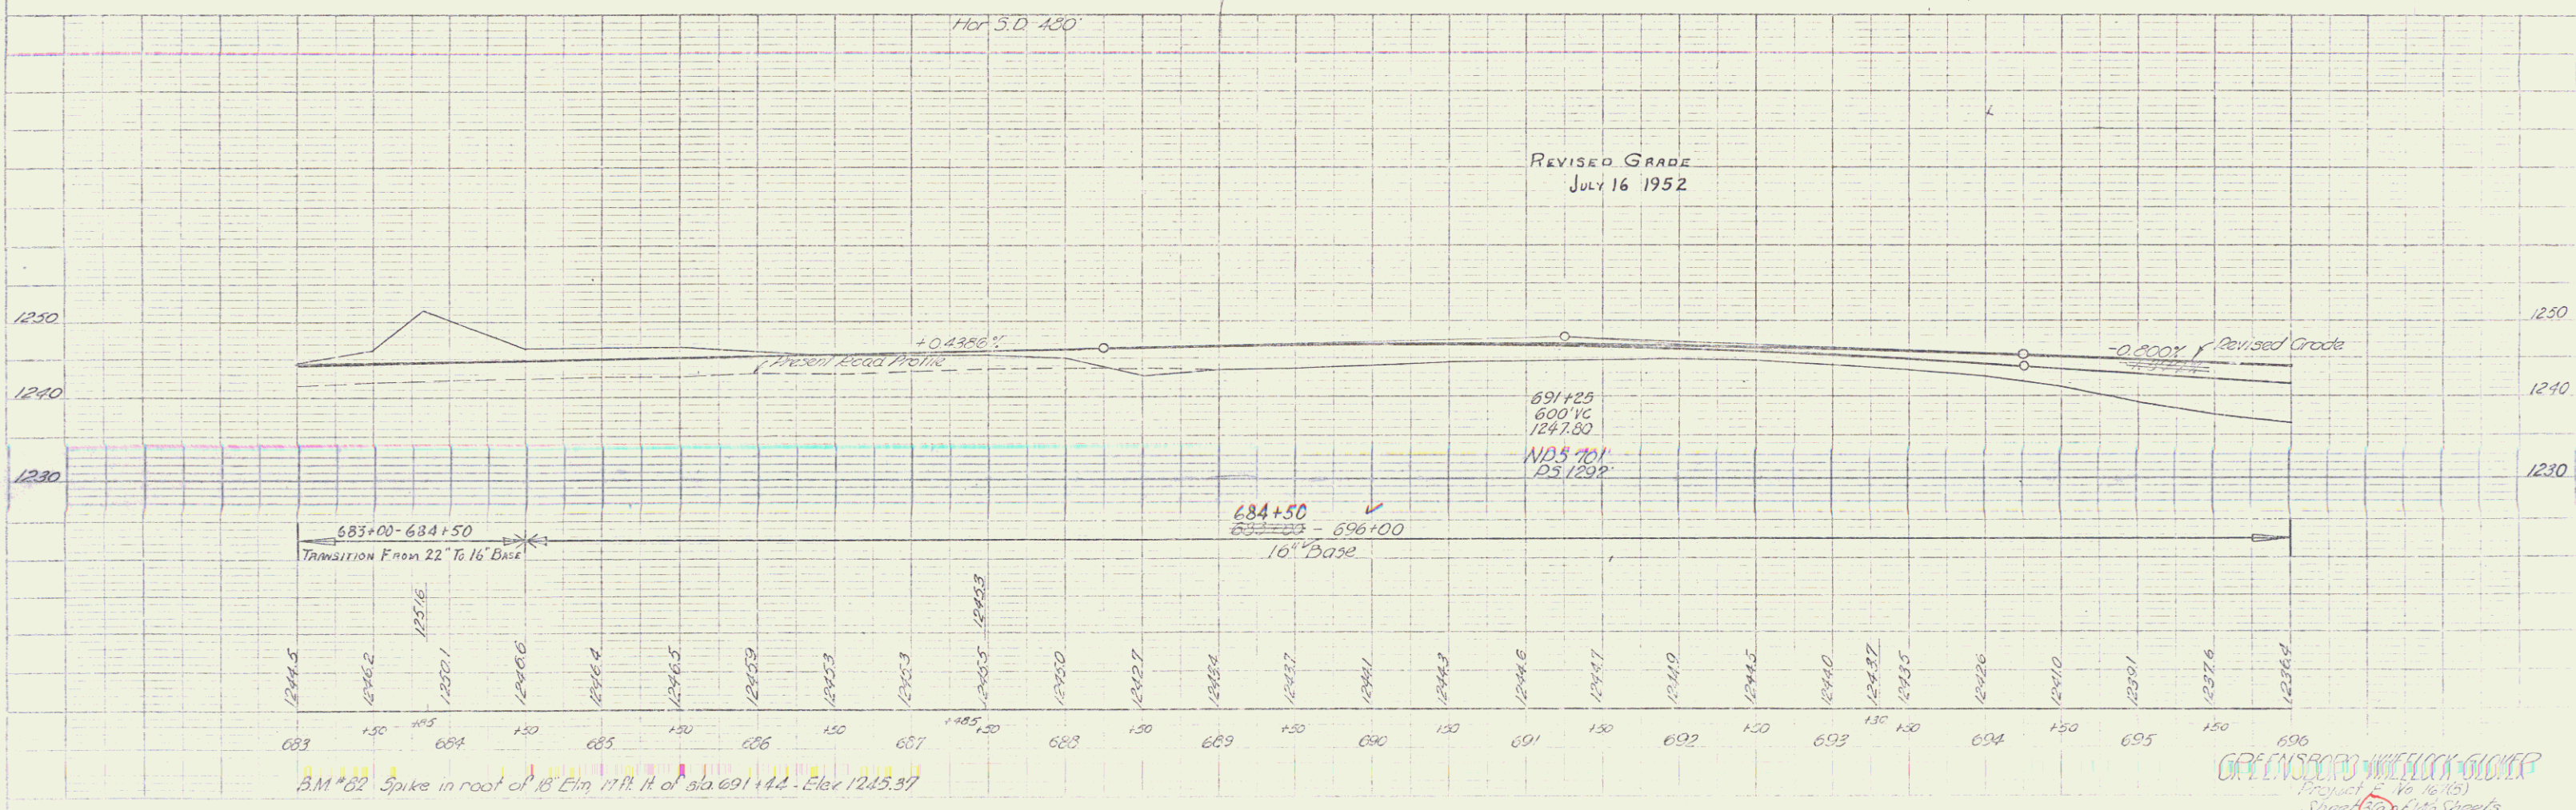


PLAN
 1" = 40'
 1" = 100'
 1" = 200'

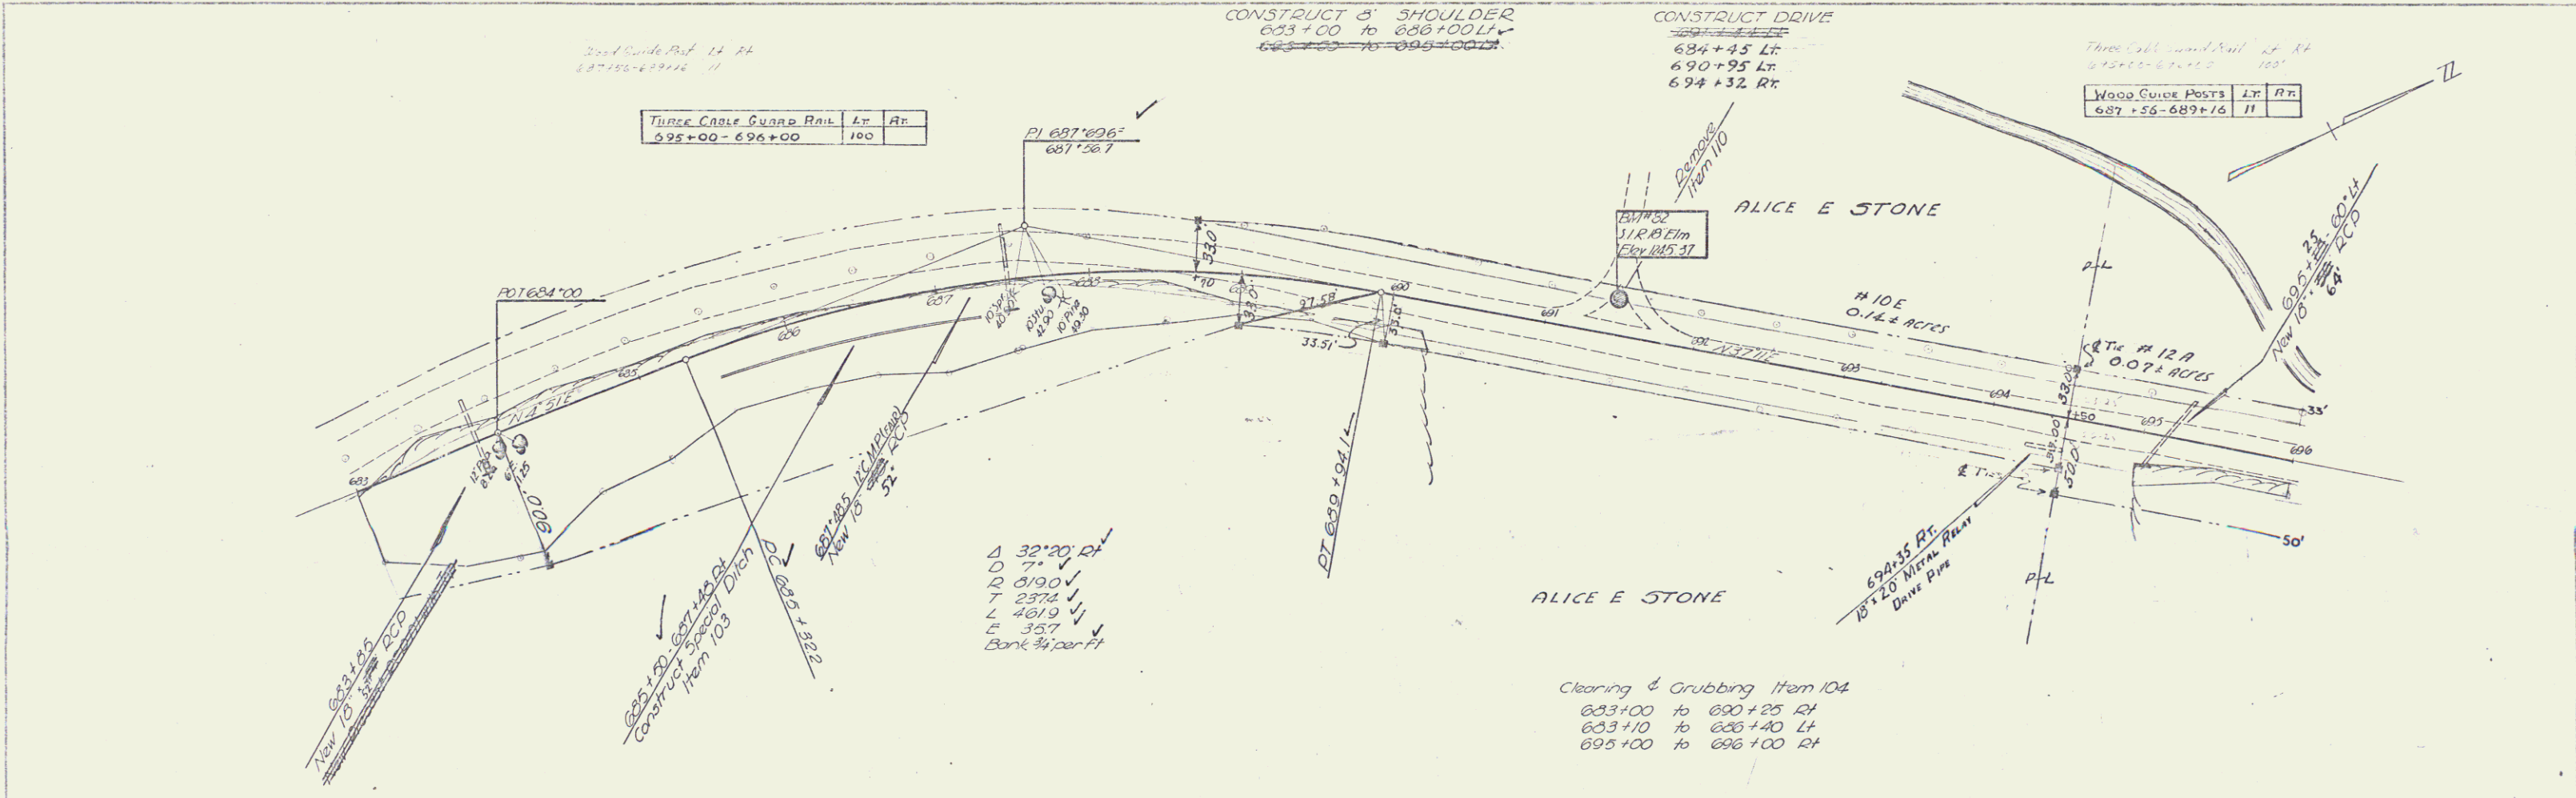

GREENSBORO ENGINEERING
 Project E-10-16 (15)
 Sheet 89 of 125 Sheets