


INSTRUMENT	GRANTOR	GRANTEE	BOOK	PAGE	DATE	REMARKS
PARCEL AND DATE 12 A, B, C, D. GUYARD. 5-7-52	WATERFORD ESTATES, INC.	ST. OF VT.	24	202-04	5-10-52	See also Sheets 38, 39, 40

Clearing & Grubbing - Item 104  
 696+00 to 700+50 RT  
 699+15 to 700+50 LT  
 701+10 to 702+10 RT  
 701+10 to 702+10 LT  
 704+00 to 704+50 LT  
 704+55 to 710+00 RT

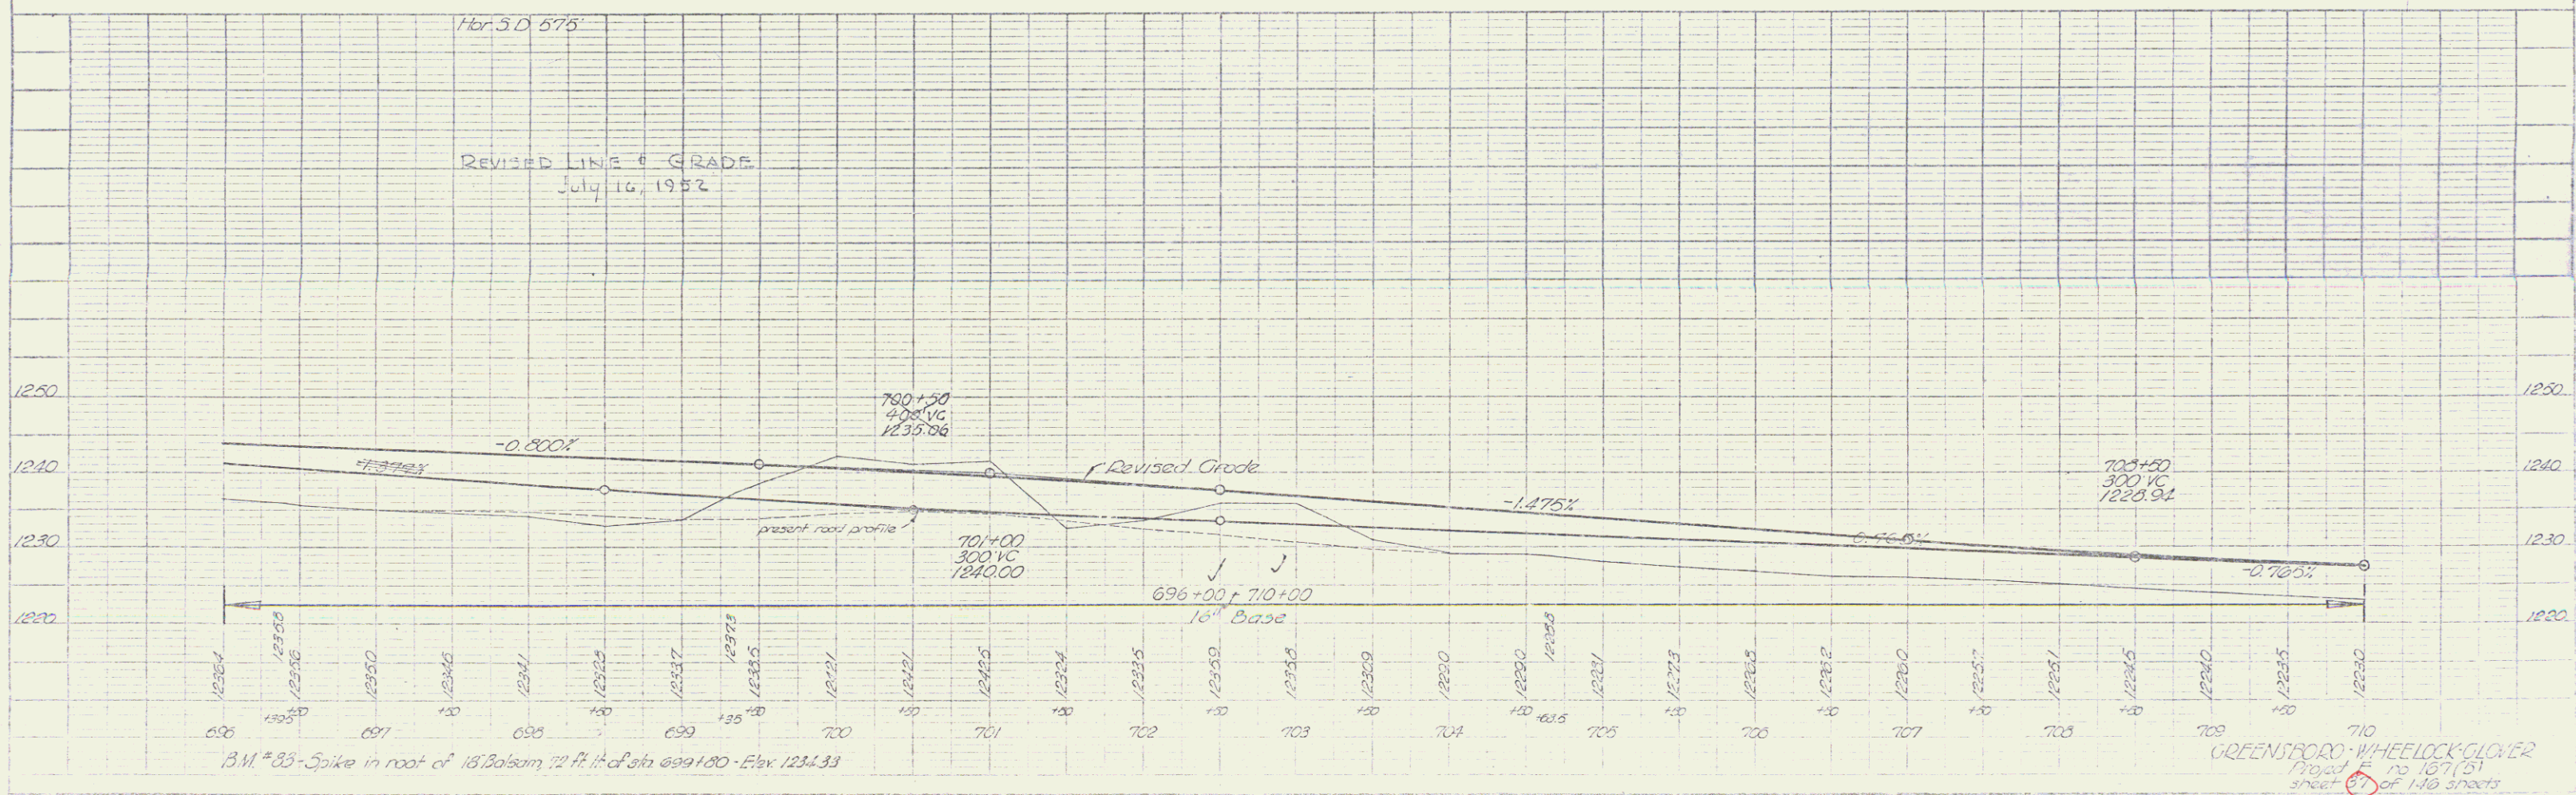

B.M. #83 - Spike in root of 18 Balsam 72 ft. ft. of sta 699+80 - Elev. 1234.33

GREENSFORD - WHEELOCK-GLOVER  
 Project No. 107(B)  
 Sheet 20 of 116 sheets