


Point	Kind of Instrument	Date of Instrument	Grantor	Grantee	Recorded	Remarks
A	Q.C.D.	3-5-36	Amy Bean	ShofW.	20 168	3-26-38
A'	"	4-3-36	Barton Sav. Bank & Tr. Co.	"	20 169	4-6-36
A''	"	4-3-36	"	"	20 170	4-4-36
A'''	W.D.	8-17-60	HA BUCKNAM	SPORIT	29 19	8-17-60

PROTECTION OF SPRING
 STA. 37 + 46 LT.
 The attention of the contractor is called to the Spring Sta. 37+46 Lt. and any other spring on or adjacent to the project. He shall take proper precautions during construction to avoid damage to the springs as it is necessary that the flow be maintained during construction. The contractor will be held liable for all damage done by occasion of his construction to the springs from the beginning of construction to the satisfactory completion of the project.

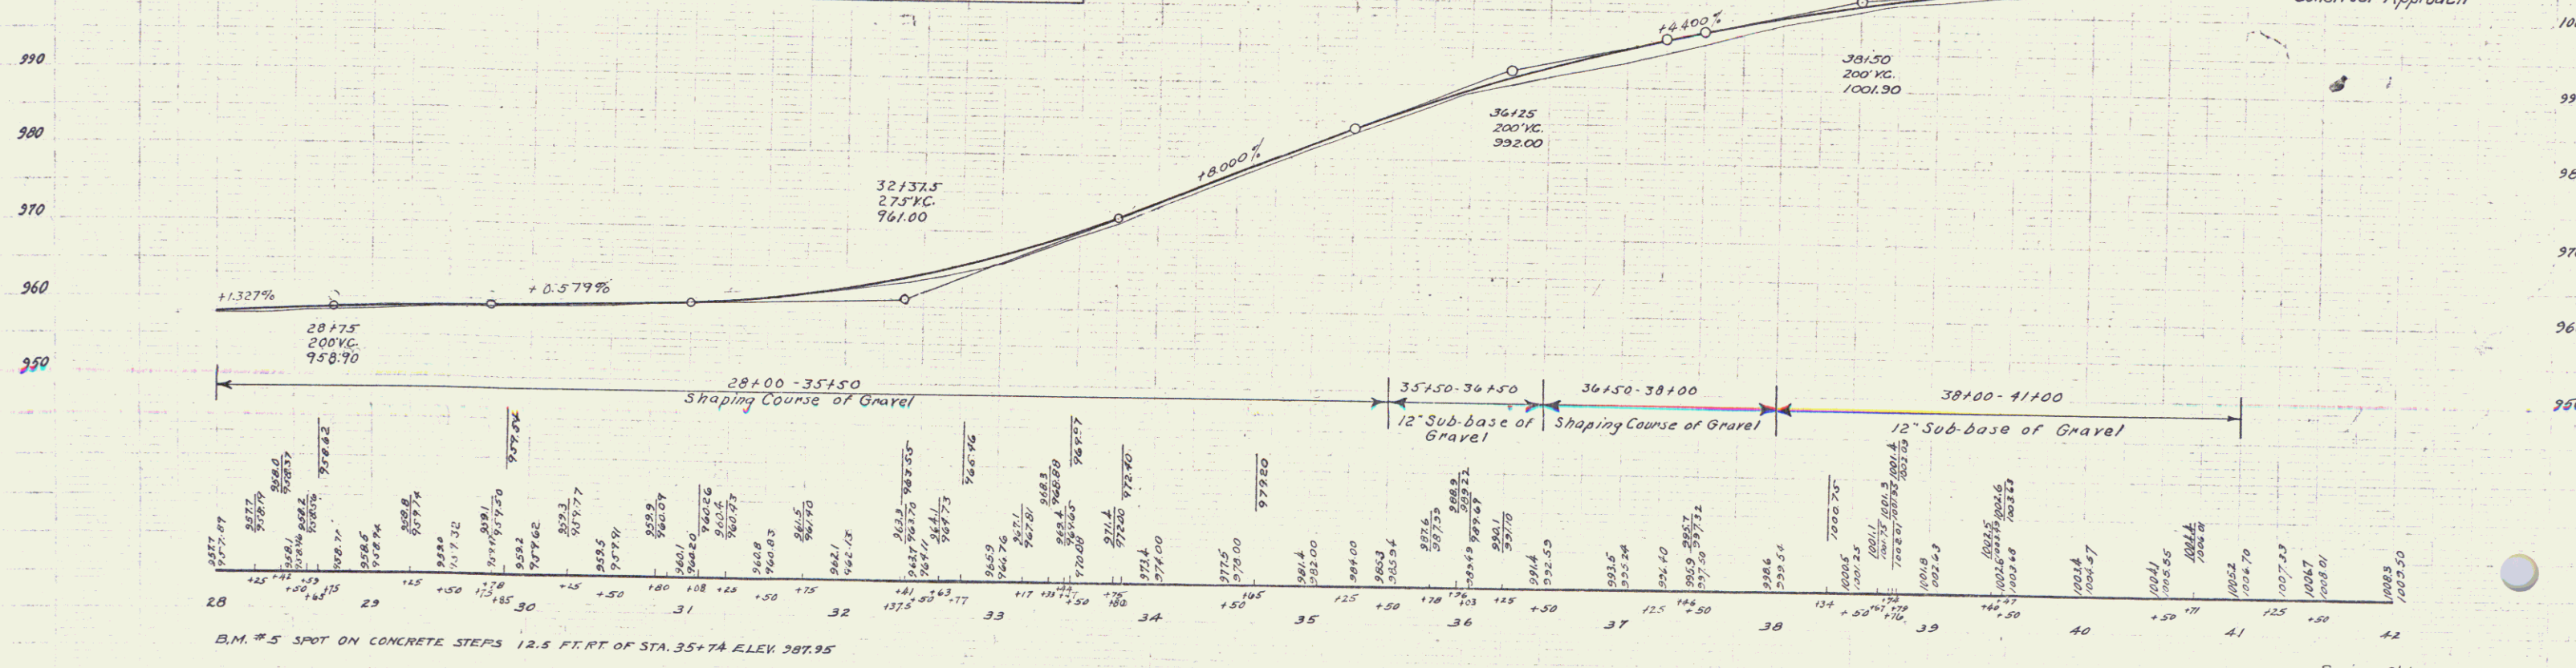

B.M. #5 SPOT ON CONCRETE STEPS 12.5 FT. FT. OF STA. 35+74 ELEV. 987.95