



BARRETT CONE
 CONE
 TRACED

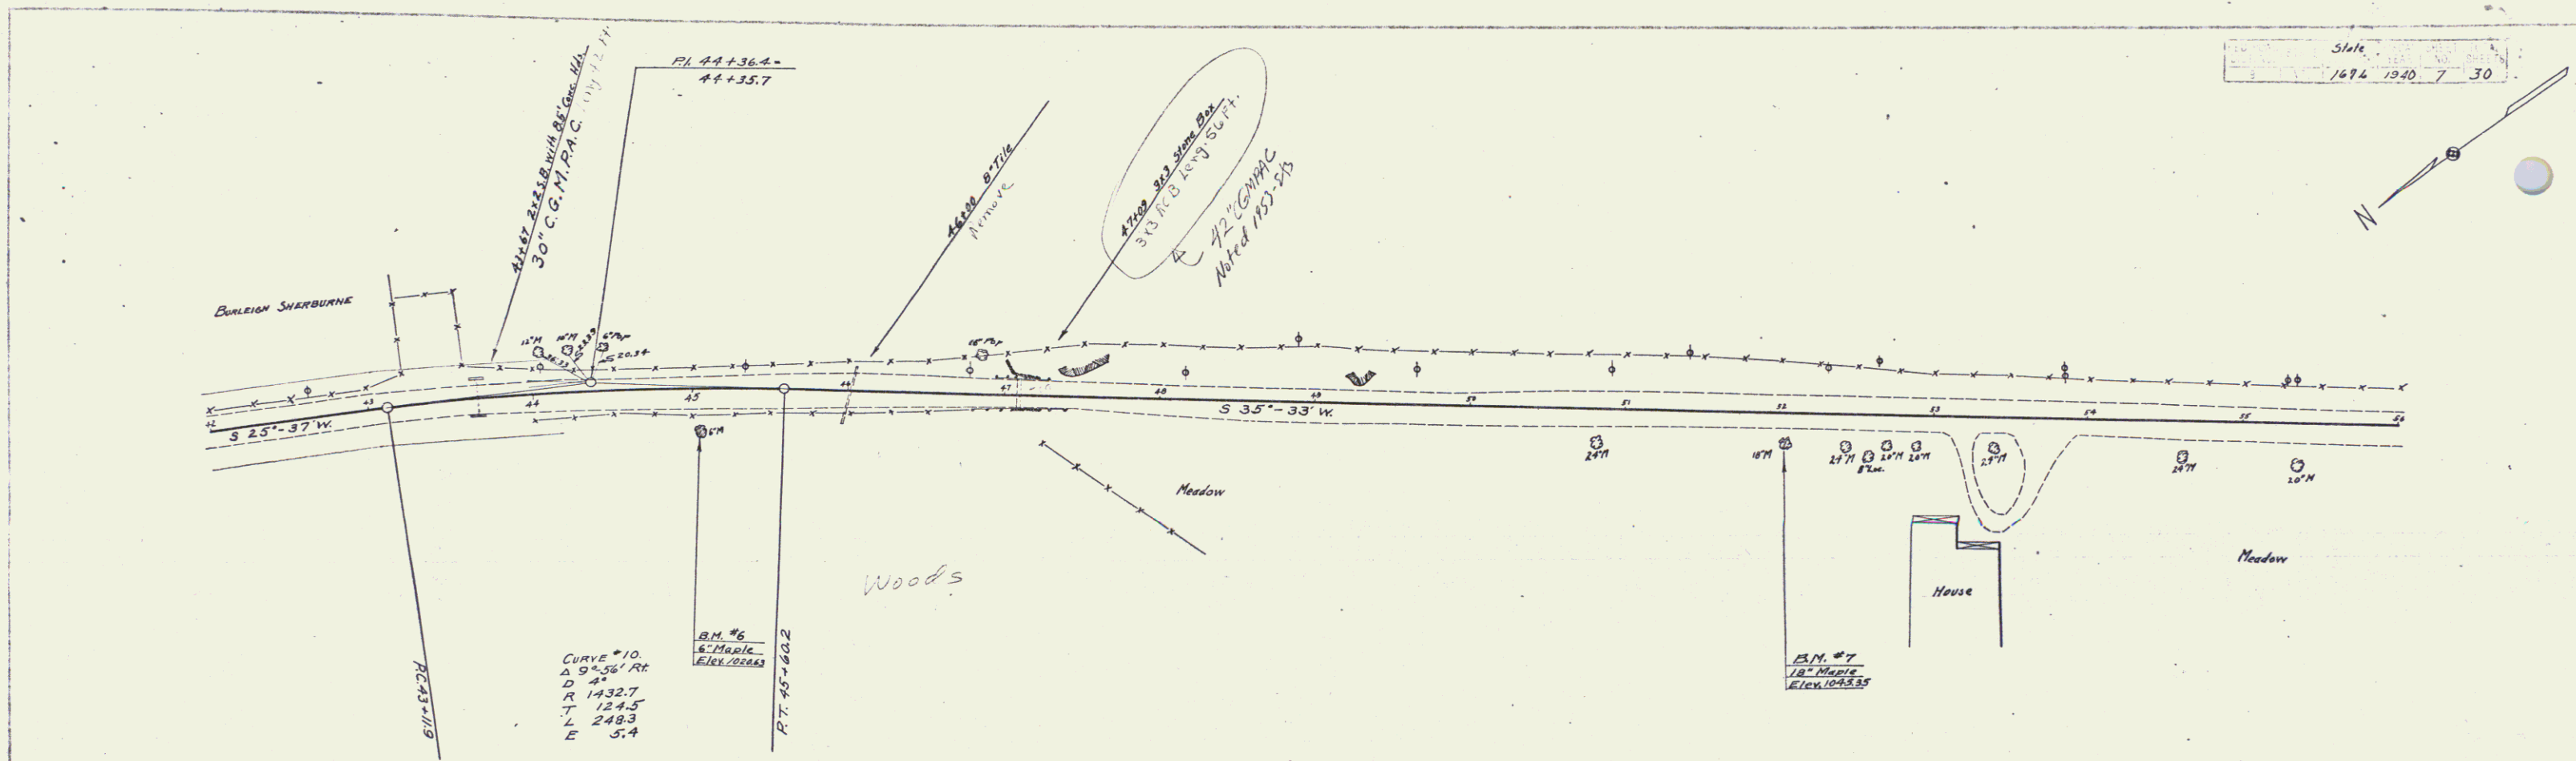

Scale
 1" = 40'
 1940 7 30

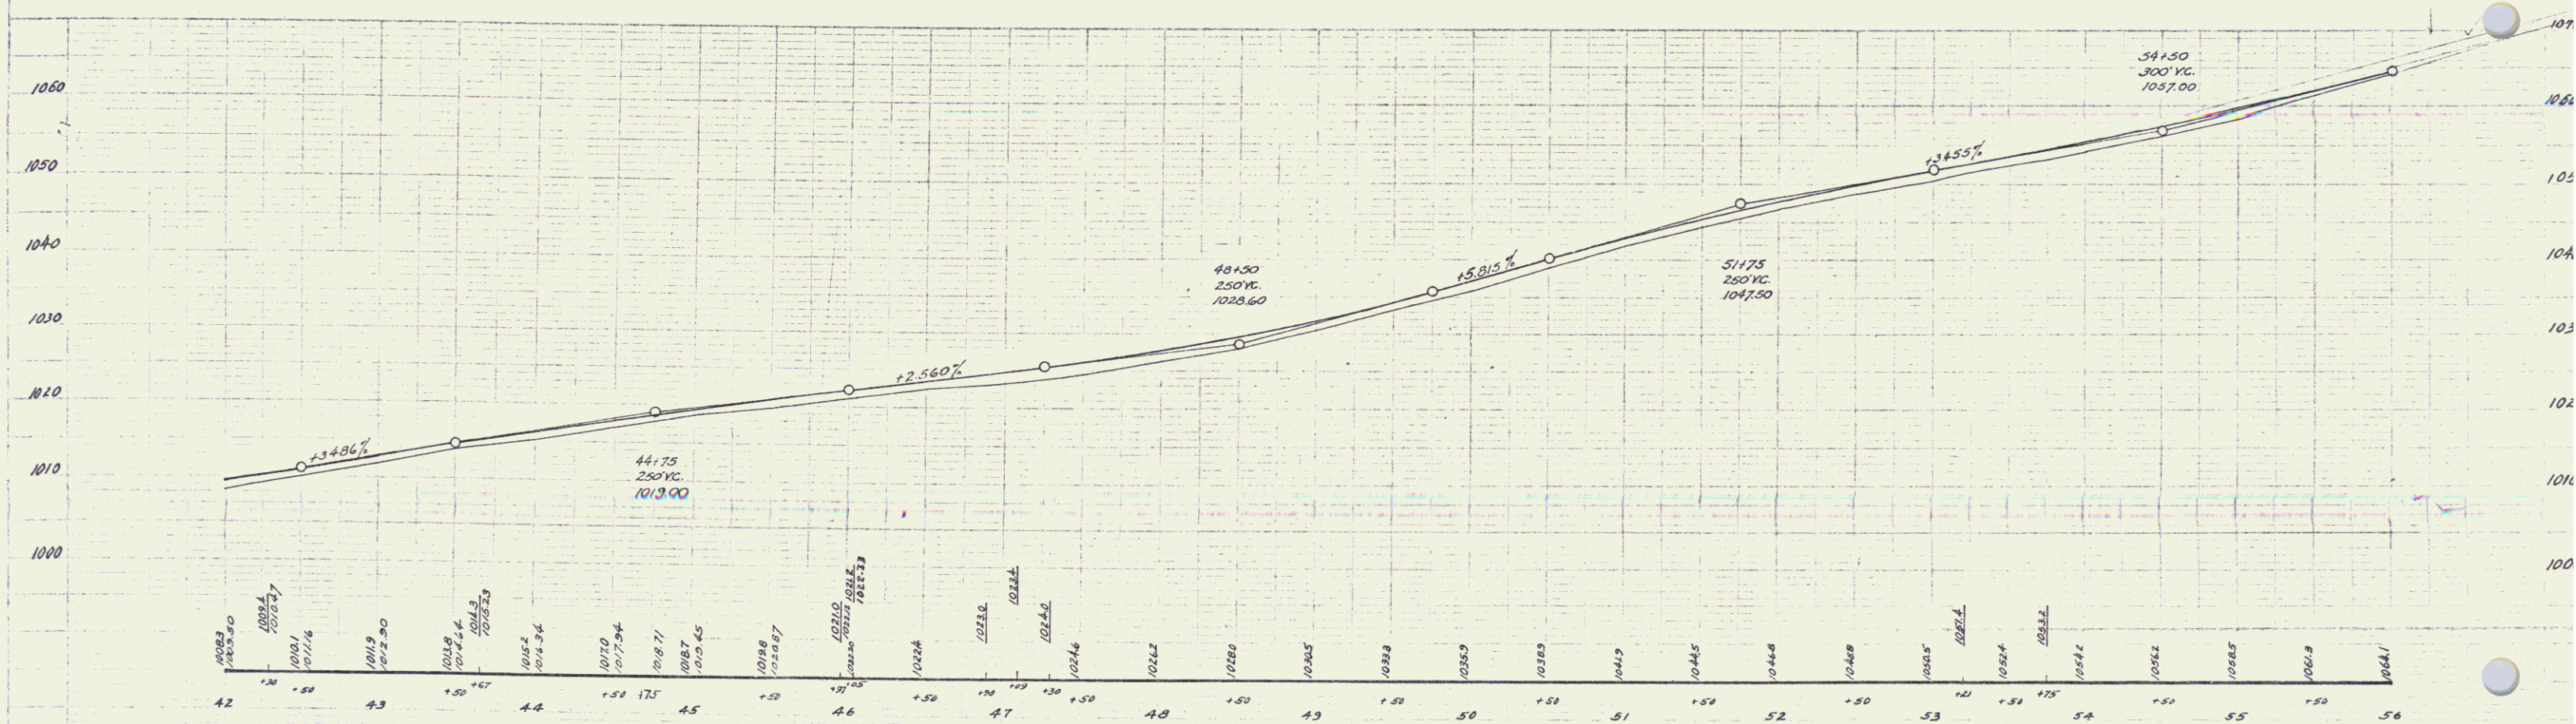

B.M. #6 SPIKE IN ROOT OF 6" MAPLE 25 FT. RT. OF STA. 45+03 ELEV. 1020.63
 B.M. #7 SPIKE IN ROOT OF 18" MAPLE 17.5 FT. RT. OF STA. 52+02 ELEV. 1045.35

Series State No. 1674
 Sheet 7 of 30