

INDEX OF SHEETS

SHEET NO 1	TITLE PAGE
2	TYPICAL CROSS-SECTION OF IMPROVEMENT
3	DRAINAGE AND SIDEWALK TABLES
4	QUANTITY SHEET (BRIDGE) PARTS "A" & "B"
5	QUANTITY SHEET (BRIDGE) PARTS "A" & "B"
6	QUANTITY SHEET (BRIDGE) PARTS "A" & "B"
7-10	PLAN AND PROFILE SHEETS PART "A"
11	PRELIMINARY INFORMATION SHEET 8+385
12	DETAILS OF SUPERSTRUCTURE 8+385
13	DETAILS OF ABUTMENT NO. 1 8+400
14	DETAILS OF ABUTMENT NO. 2 8+730
15	REINFORCING STEEL SCHEDULE 8+385
16-22	CROSS SECTIONS PART "A"
23-24	CROSS SECTIONS PART "A"
25	CONSTRUCTION DETAILS (DRAINAGE AND MARKERS)
26	CONSTRUCTION DETAILS (TYPICAL GRADING)
27	STANDARD STRUCTURE SHEET S 45-46 (THREE CABLE GUARD RAIL)
28	STANDARD STRUCTURE SHEET S 58-48 (POST P.P. DROP PILETS)
29	STANDARD STRUCTURE SHEET S 8-20 (DETAILS OF RAILING)
30	STANDARD STRUCTURE SHEET S 8-5 (SIT. BRIDGE RAILING)
31	STANDARD STRUCTURE SHEET S 8-11 (BARRICADES, SIGNS AND LIGHTS) BRIDGE
32	STANDARD STRUCTURE SHEET S 8-11 (BARRICADES, SIGNS AND LIGHTS) BRIDGE
33	STANDARD STRUCTURE SHEET S 8-11 (BARRICADES, SIGNS AND LIGHTS) BRIDGE
34-36	PLAN AND PROFILE SHEETS PART "B"
37	PRELIMINARY INFORMATION SHEET 32+63
38	DETAILS OF SUPERSTRUCTURE 32+63
39	DETAILS OF ABUTMENT NO. 1 32+66
40	DETAILS OF ABUTMENT NO. 2 33+00
41	REINFORCING STEEL SCHEDULE 32+63
42-48	CROSS SECTIONS PART "B"
47-49	CHANNEL SECTIONS PART "B"


STATE OF VERMONT
DEPARTMENT OF HIGHWAYS
PROPOSED IMPROVEMENT

FEDERAL AID PROJECT
TOWN OF GLOVER
COUNTY OF ORLEANS
VERMONT ROUTE 16

Route Project **VF16**
F167(6)
Date **01/10/1955**
P.I. **00R578**

PROJECT NAME & NUMBER	DATE	PAYMENT NO.
GLOVER F167(6)	12/15/54	2243-51
DESIGNED BY	CONTRACTOR	
Parris P.A. Glover	W. Woodard & Co.	
Colkins Plant, Glover	American Wire Co.	
Colkins Plant, Glover	C.E. Dunlop Construction	
Col. Ben. Mill, Harrison, N.H.		
A.B. Anderson, Barre, Vt.		
A.S. Hunt		
A.B. MacDougal		


LENGTH OF (PART A) 250.0 FEET = 0.047 MILE
LENGTH OF (PART B) 744.8 FEET = 0.141 MILE
LENGTH OF CONTRACT 994.8 FEET = 0.189 MILE

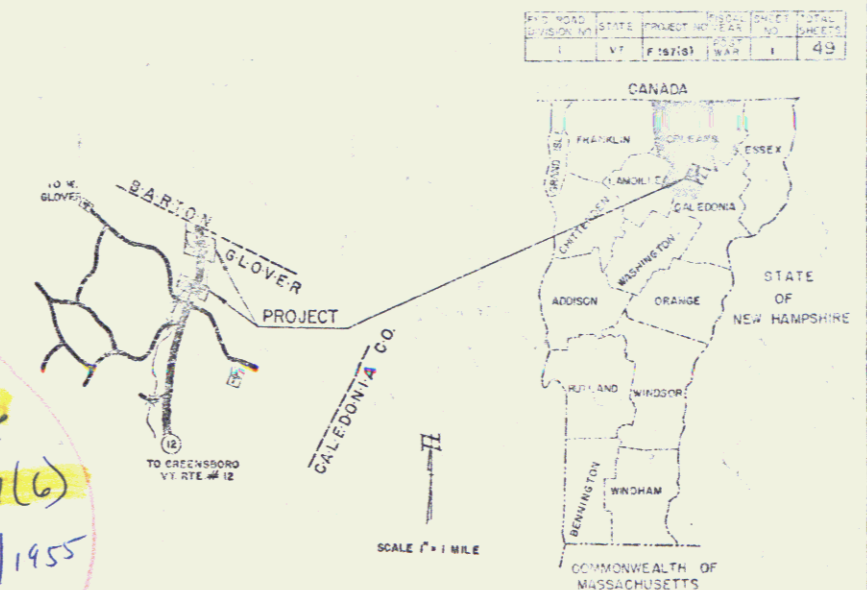

(PART A)

BEGINNING AT A POINT APPROXIMATELY 3967.8 FEET SOUTHWEST OF THE GLOVER-BARTON TOWN LINE AND EXTENDING NORTHEASTERLY 250.0 FEET.


LENGTH OF BRIDGE 69.0 FEET
LENGTH OF ROADWAY 181.0 FEET
LENGTH OF (PART A) 250.0 FEET

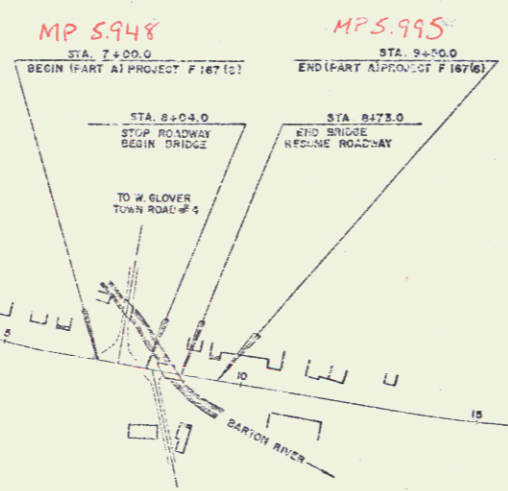

(PART B)

BEGINNING AT A POINT APPROXIMATELY 1817.8 FEET SOUTHWEST OF THE GLOVER-BARTON TOWN LINE AND EXTENDING NORTHEASTERLY 744.8 FEET.

LENGTH OF BRIDGE 74.0 FEET
LENGTH OF ROADWAY 670.8 FEET
LENGTH OF (PART B) 744.8 FEET

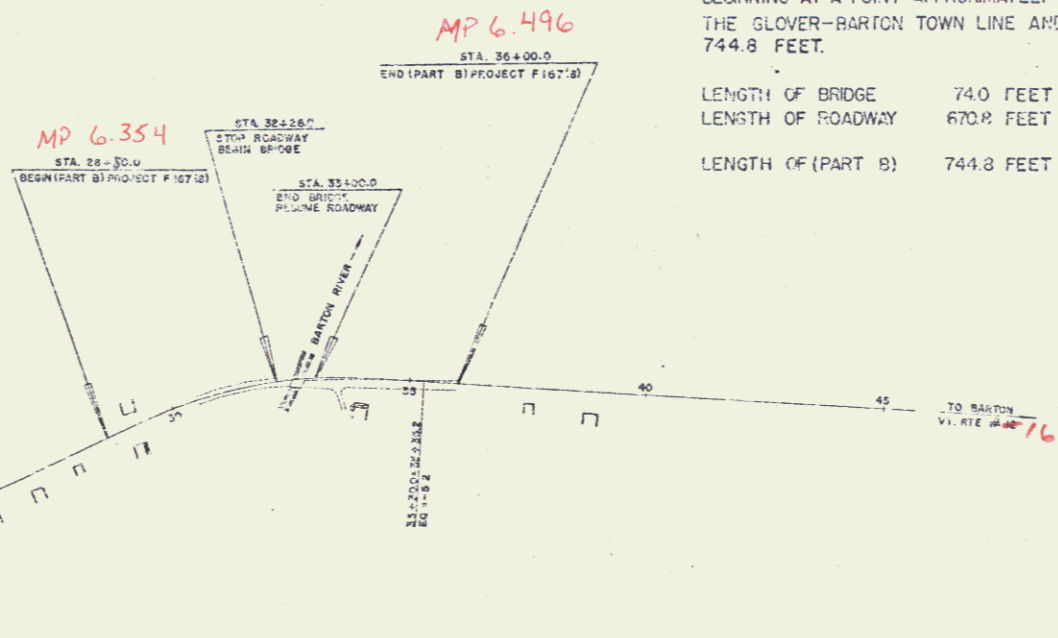

COUNTY OF ORLEANS
TOWN OF GLOVER
BRIDGE NO. 167
DATE: 1/10/55
BY: P.A. Glover
CHECKED BY: A.B. Anderson
APPROVED BY: A.S. Hunt

GROUND ELEVATION	DATE	SCALE
BRIDGE ELEVATION	DATE	SCALE
CURVE DATA		
DEFLECTION OF ANGLE	5	
DEGREE OF CURVE	9	
RADIUS OF CURVE	8	
TANGENT DISTANCE	7	
LENGTH OF CURVE	1	
EXTERNAL DISTANCE	8	
POINT OF INTERSECTION	9	
POINT OF CURVE	10	
POINT OF TANGENT	11	
POINT ON TANGENT	12	
POINT ON SUB-TANGENT	13	

APPROVED	APPROVED	APPROVED	APPROVED	APPROVED
DATE 1-7-55	DATE JAN 7 1955	DATE NOV 18 1954	DATE JAN 7 1955	DATE JAN 10 1955

NOTE: ANY FURTHER INFORMATION CONCERNING THIS PROJECT SHOULD BE REFERRED TO THE FIELD ENGINEER OF THE DISTRICT.

DEPARTMENT OF HIGHWAYS
BUREAU OF PUBLIC ROADS

PROJECT GLOVER, RD. F.167(6)
SHEET 6 OF 49 SHEETS

AUG 18 1980