
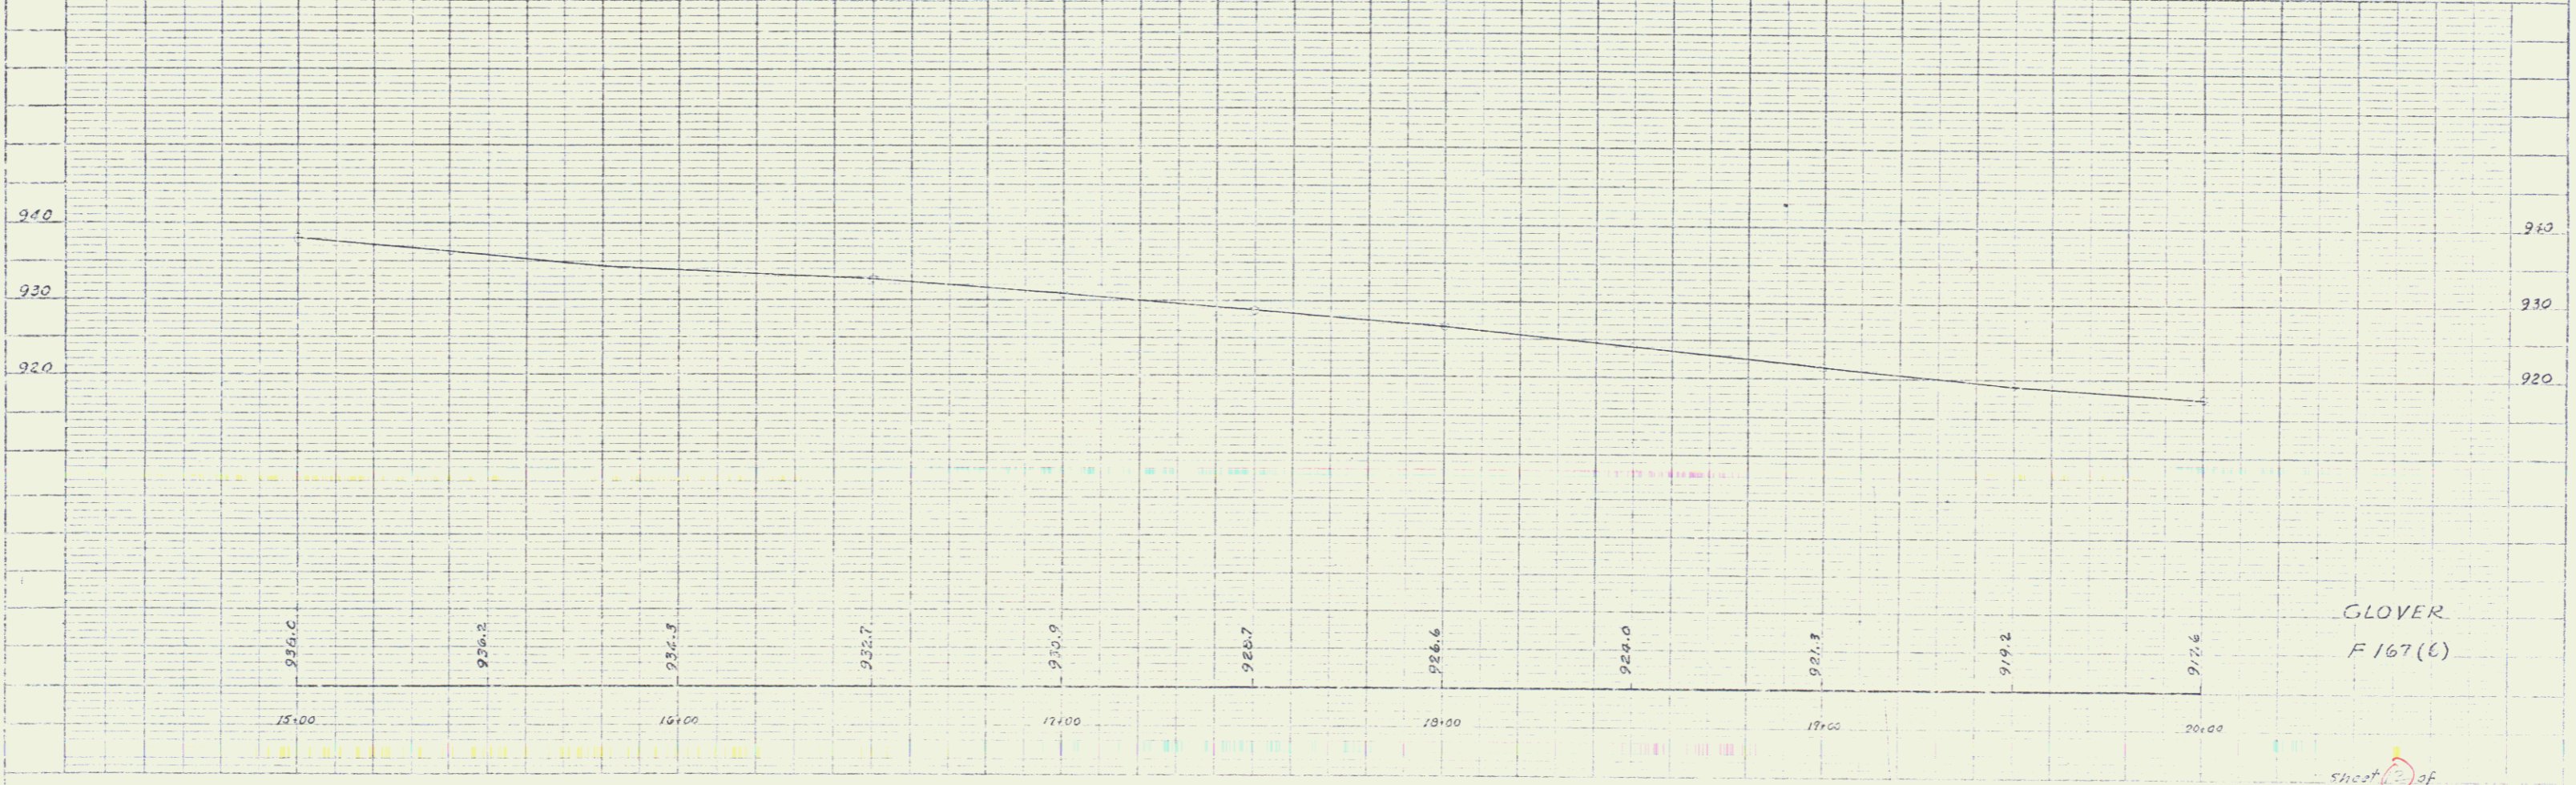


PLAN
 DATE: 7/23/78
 DRAWN BY: [Signature]
 CHECKED BY: [Signature]
 SCALE: AS SHOWN

PROFILE
 DATE: 7/23/78
 DRAWN BY: [Signature]
 CHECKED BY: [Signature]
 SCALE: AS SHOWN

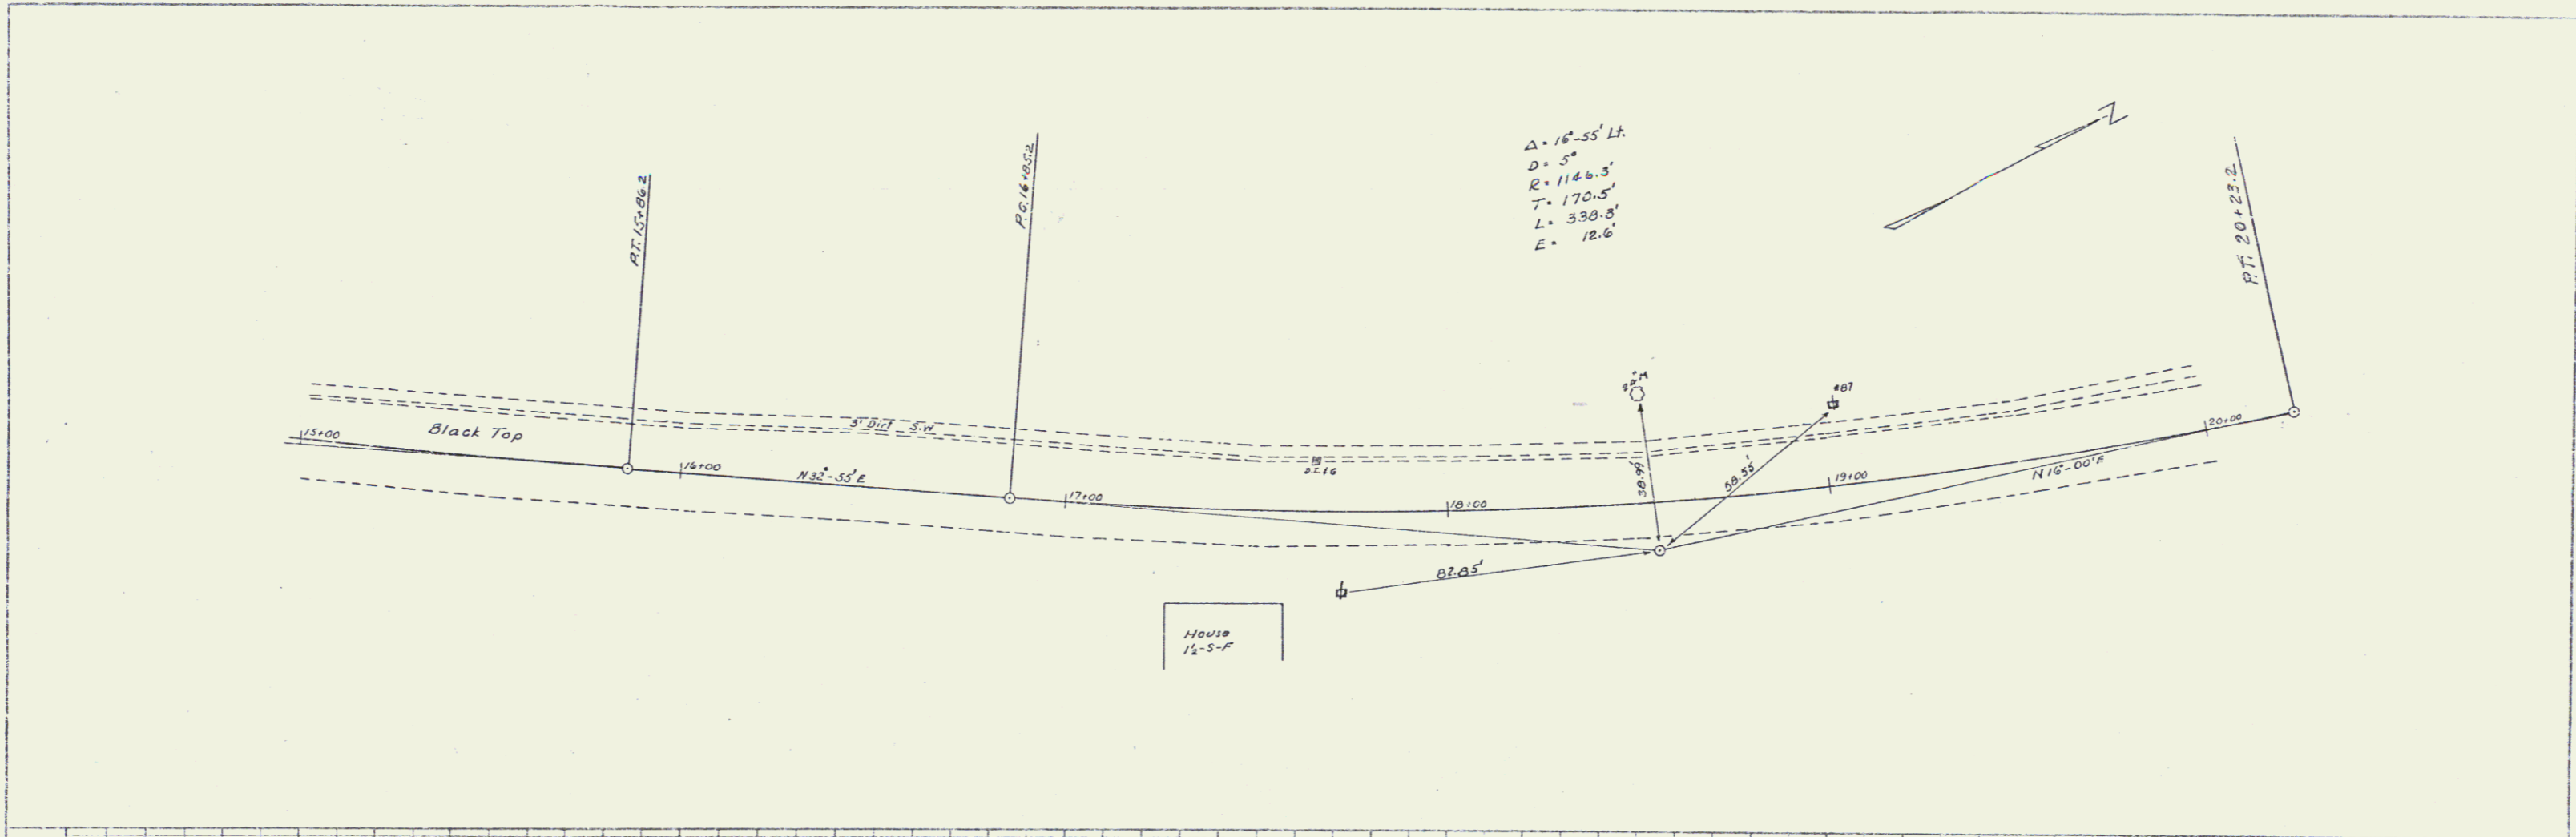

GLOVER
 F 167 (6)

Sheet 5 of 5

AUG 18 1980 5